


Dec. 21/3190



one additional stay tube to  
each chamber

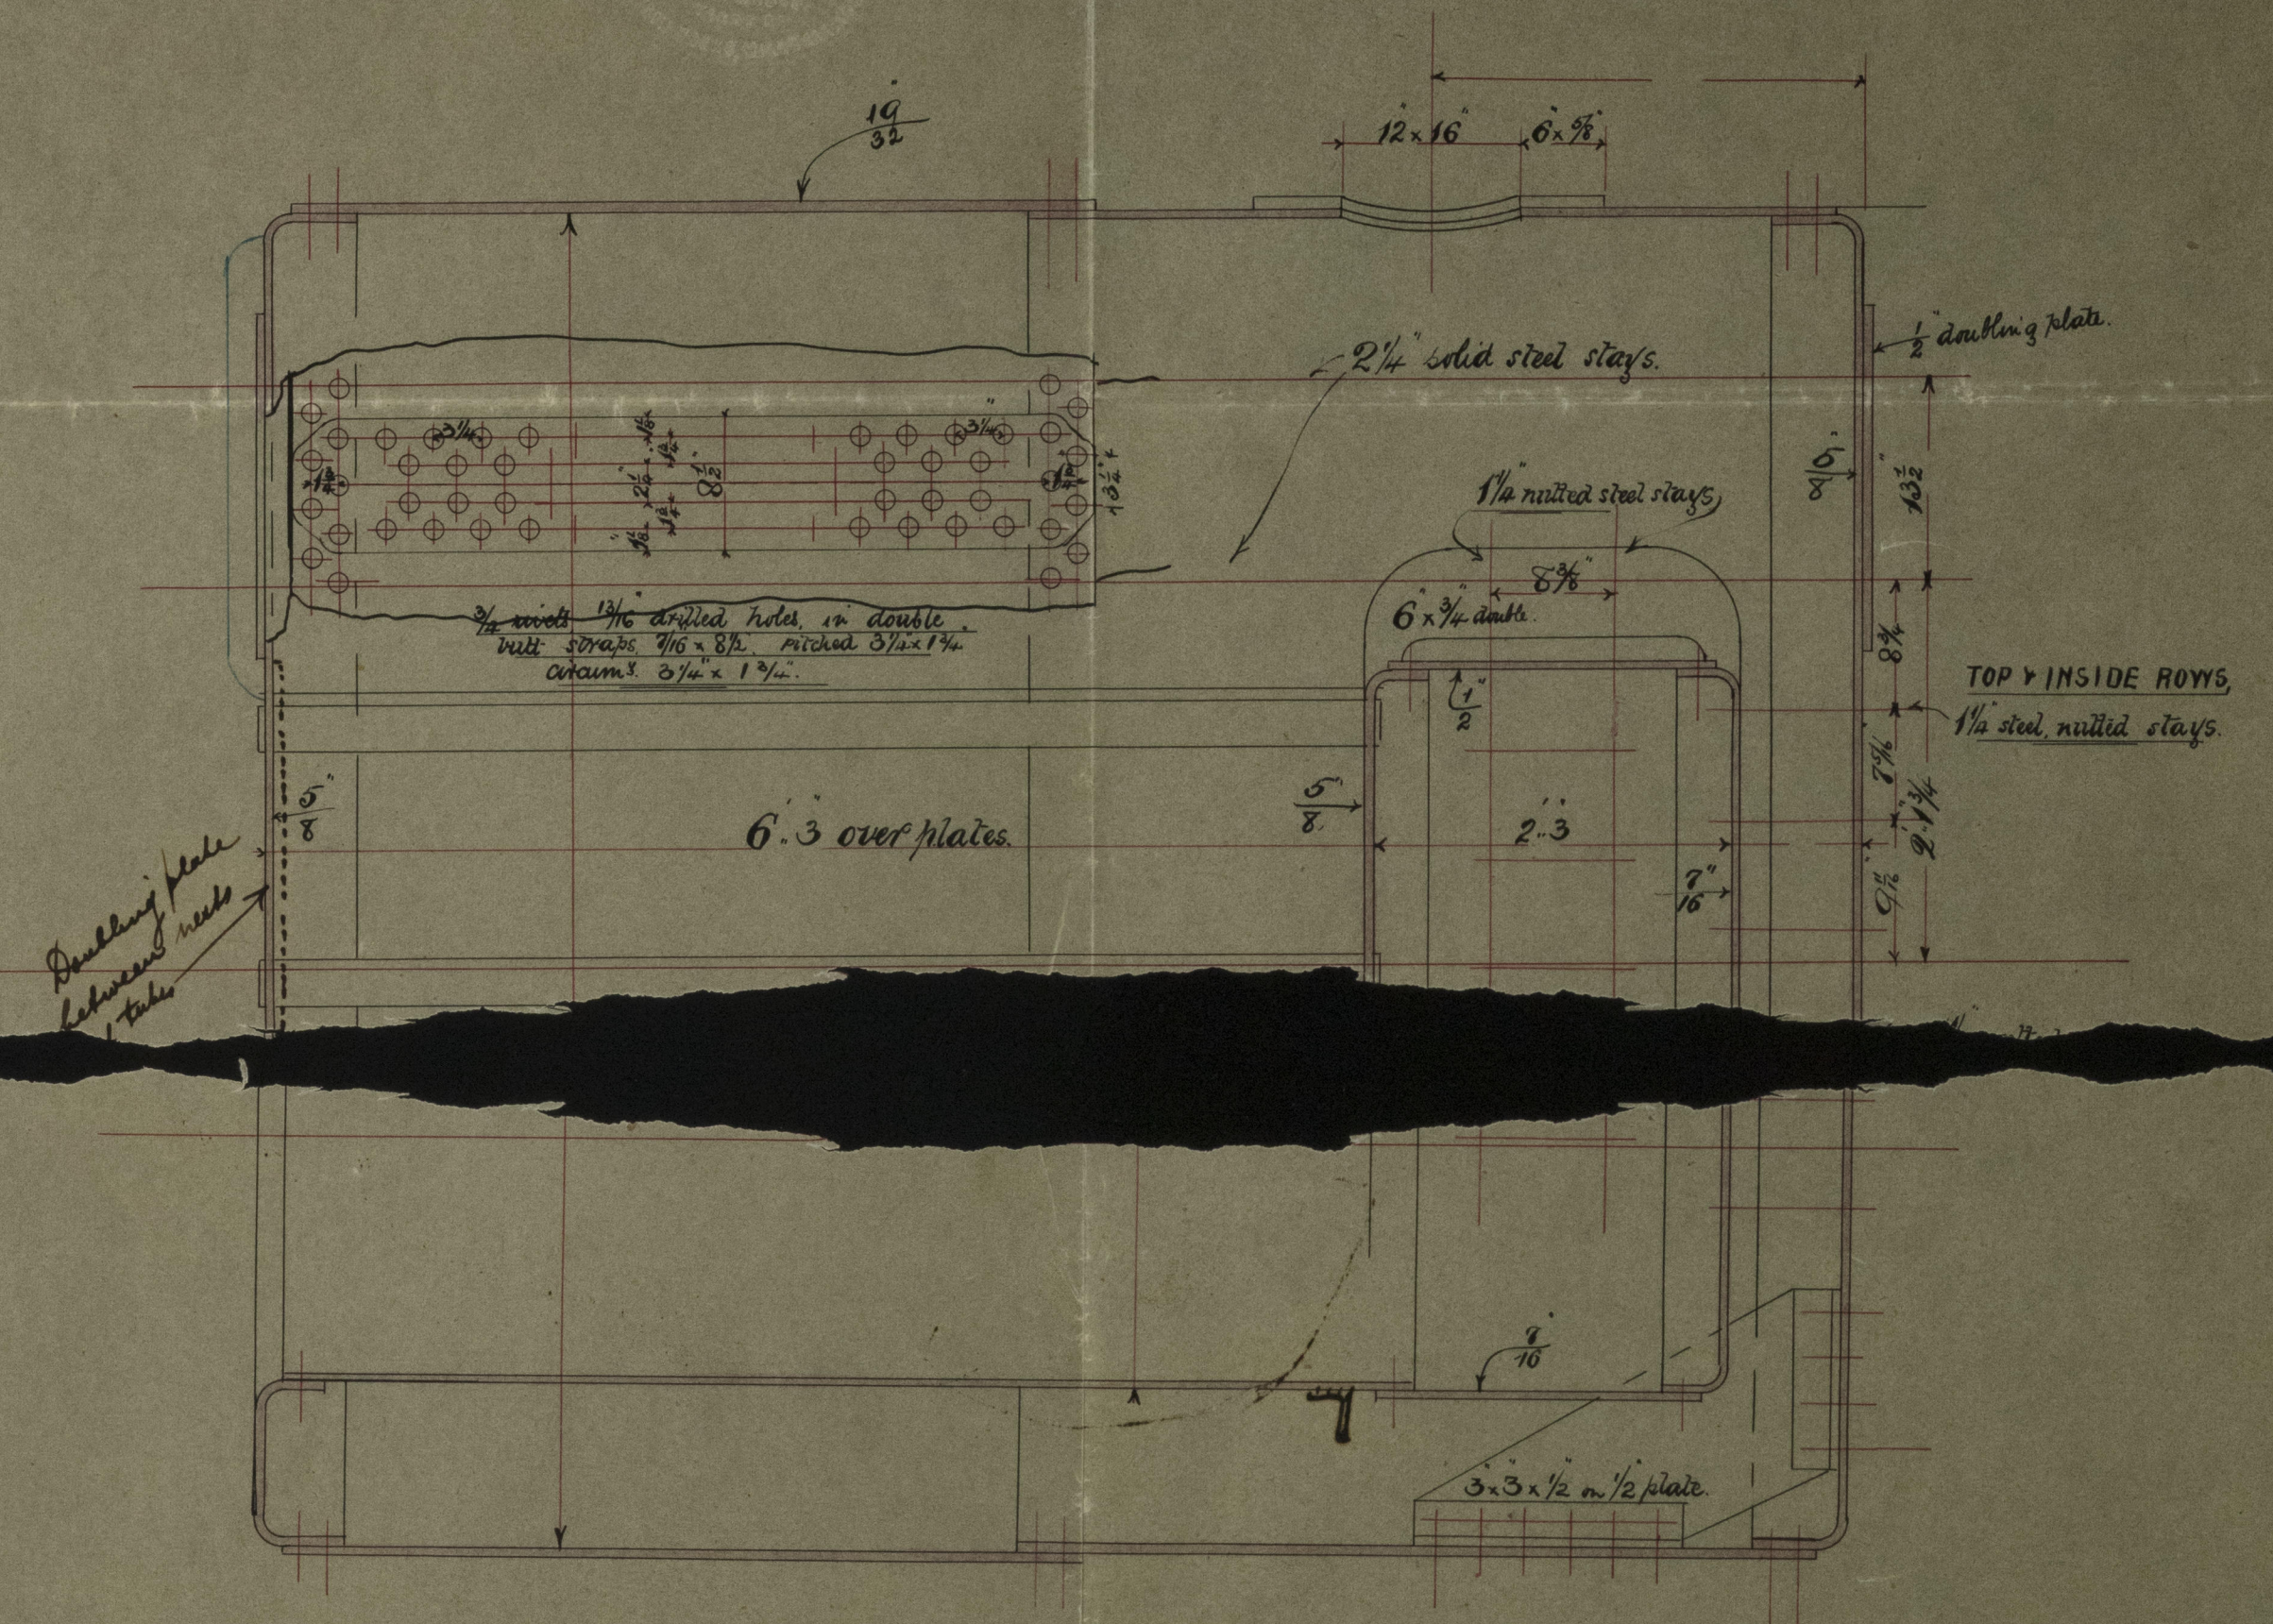

8' 6" x 9' 0" STEEL BOILER FOR

S. T. "HAWK."

*m.*


LLOYD'S' RULES FOR 100 LBS. W.G. P.E.

TESTED TO 200 LBS. PER SQ. IN.

SCALE\_ 1 INCH = 1 FOOT.

N. 2638.

MA. 18. 3. 92.

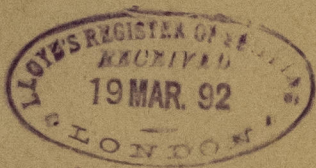










© 2021

Lloyd's Register  
Foundation