
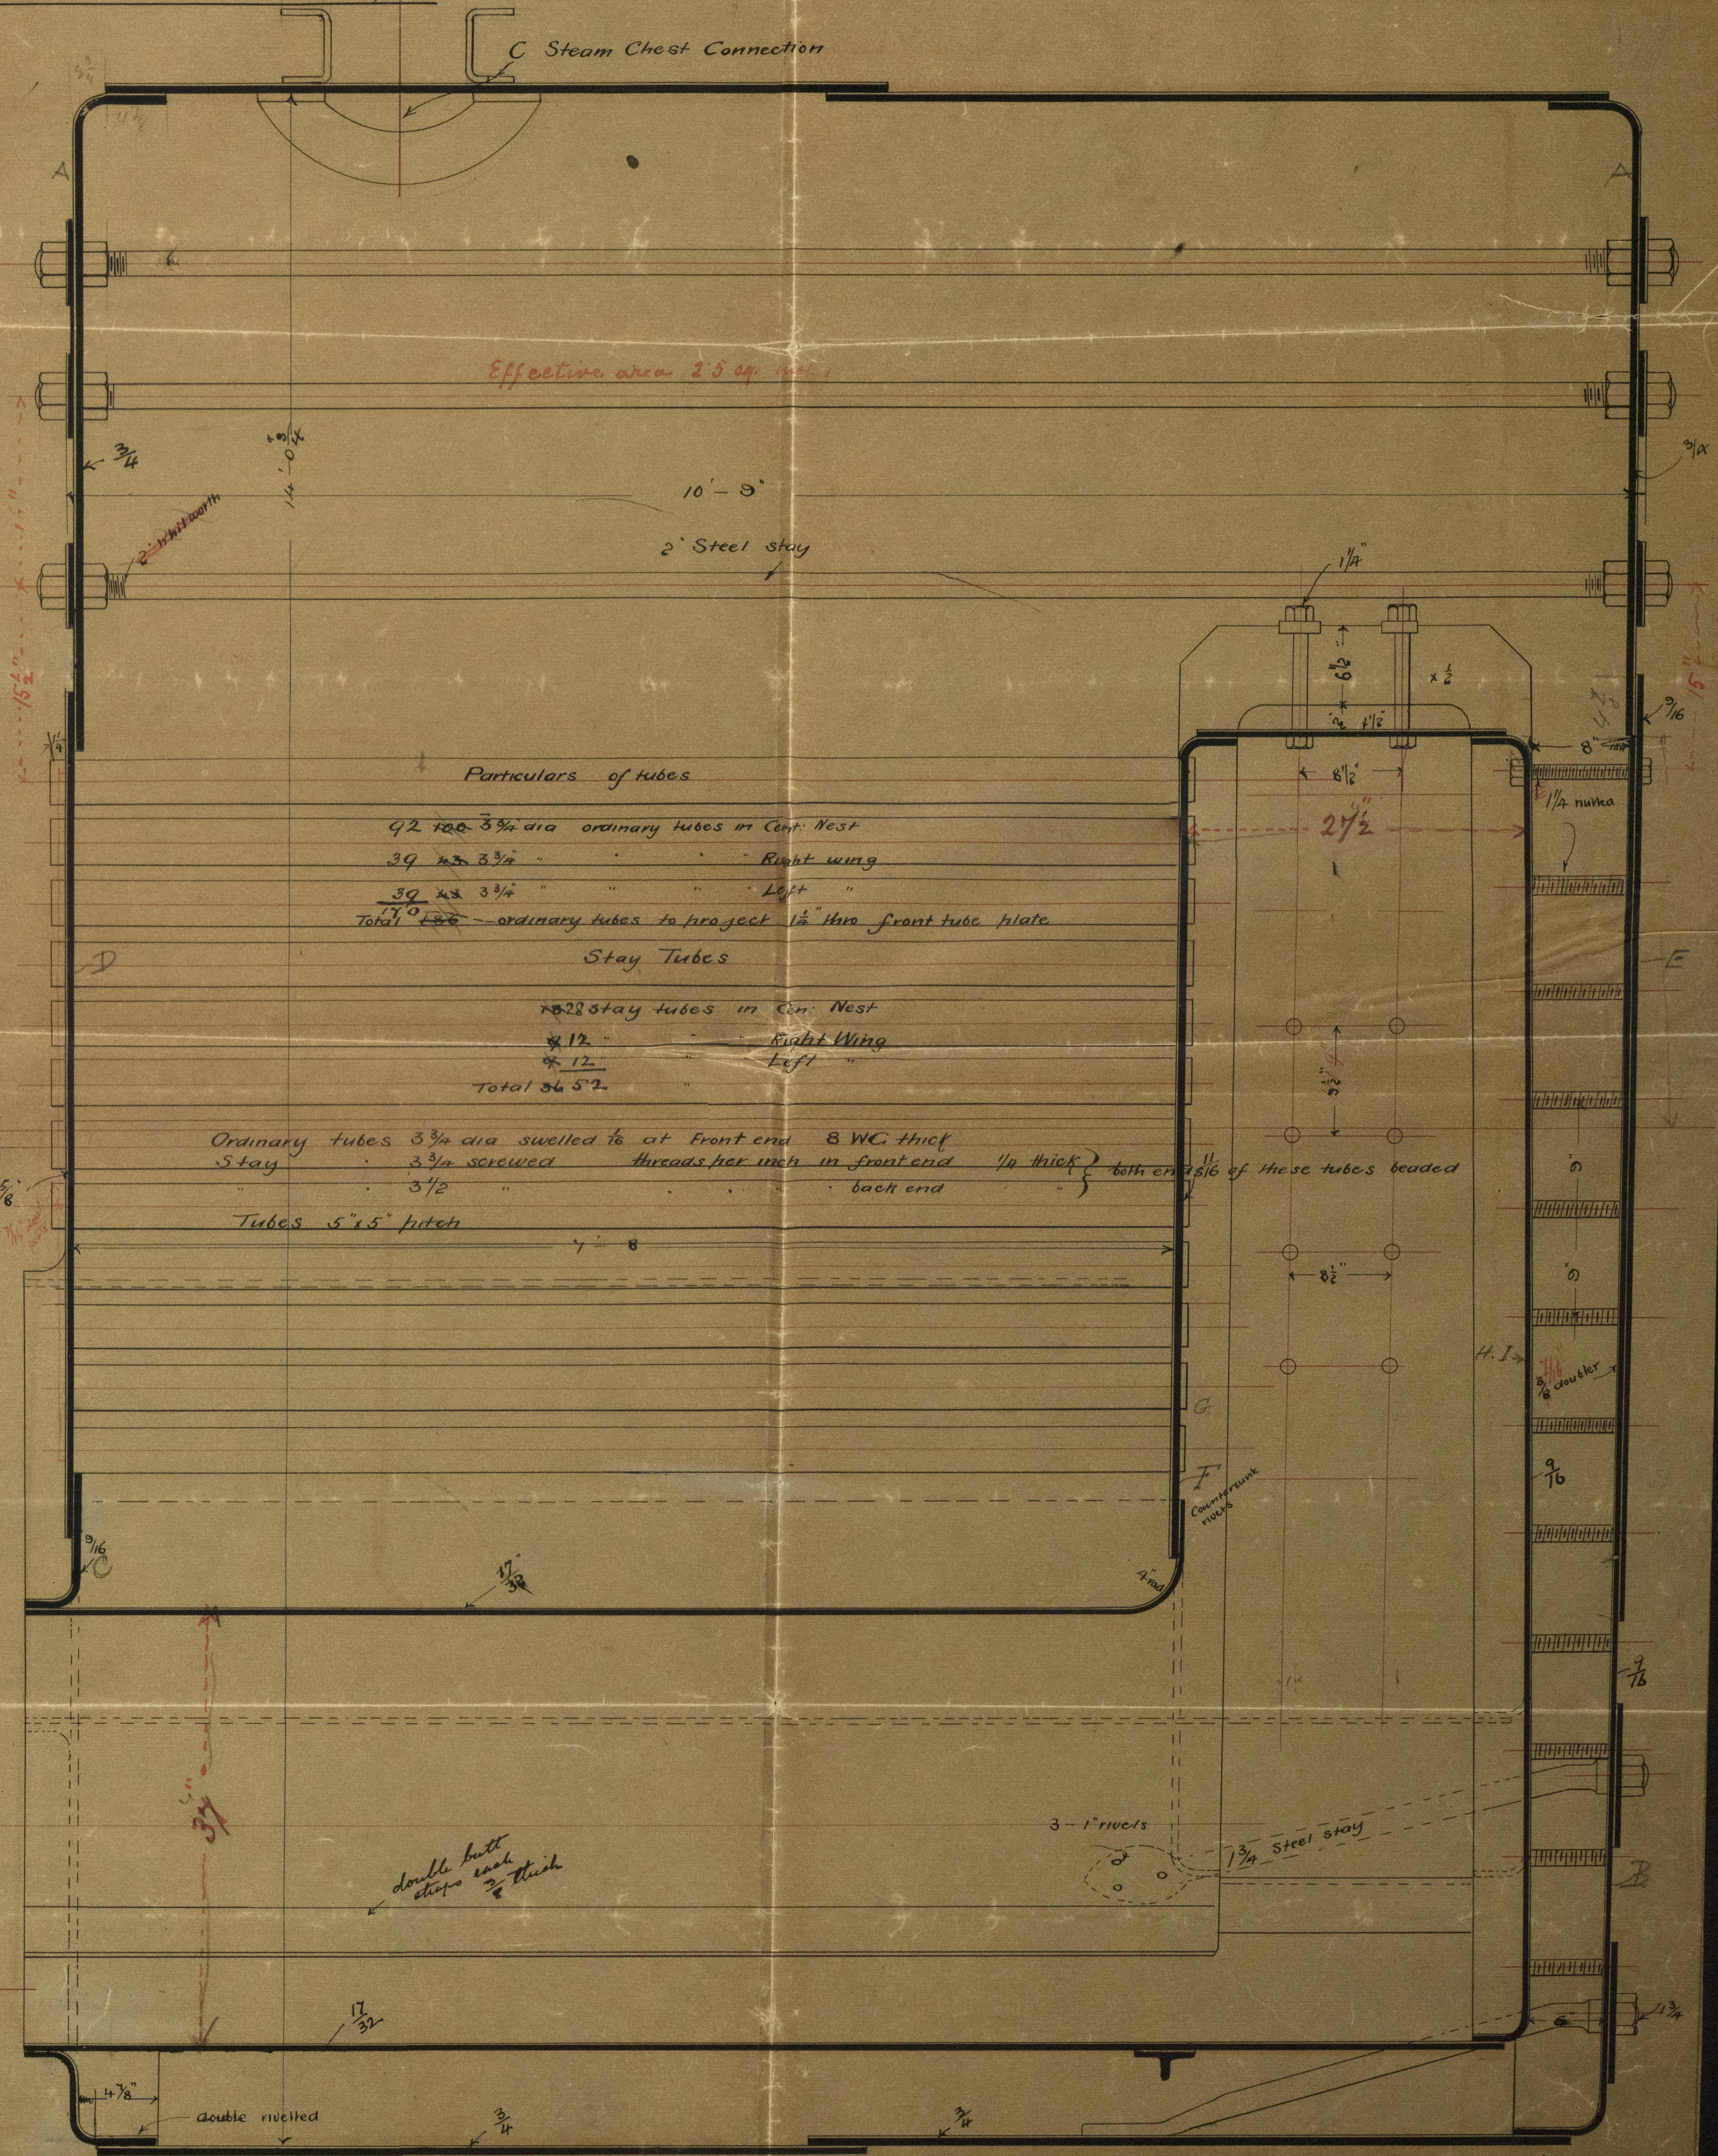


Dr. H. 10.92

*S.S. Grappler*  
14' 0" x 10' 9" marine Scale 1/2"

Working Pressure 90 lbs

JOHN FRASER & SON  
MILLWALL BOILER WORKS  
LONDON

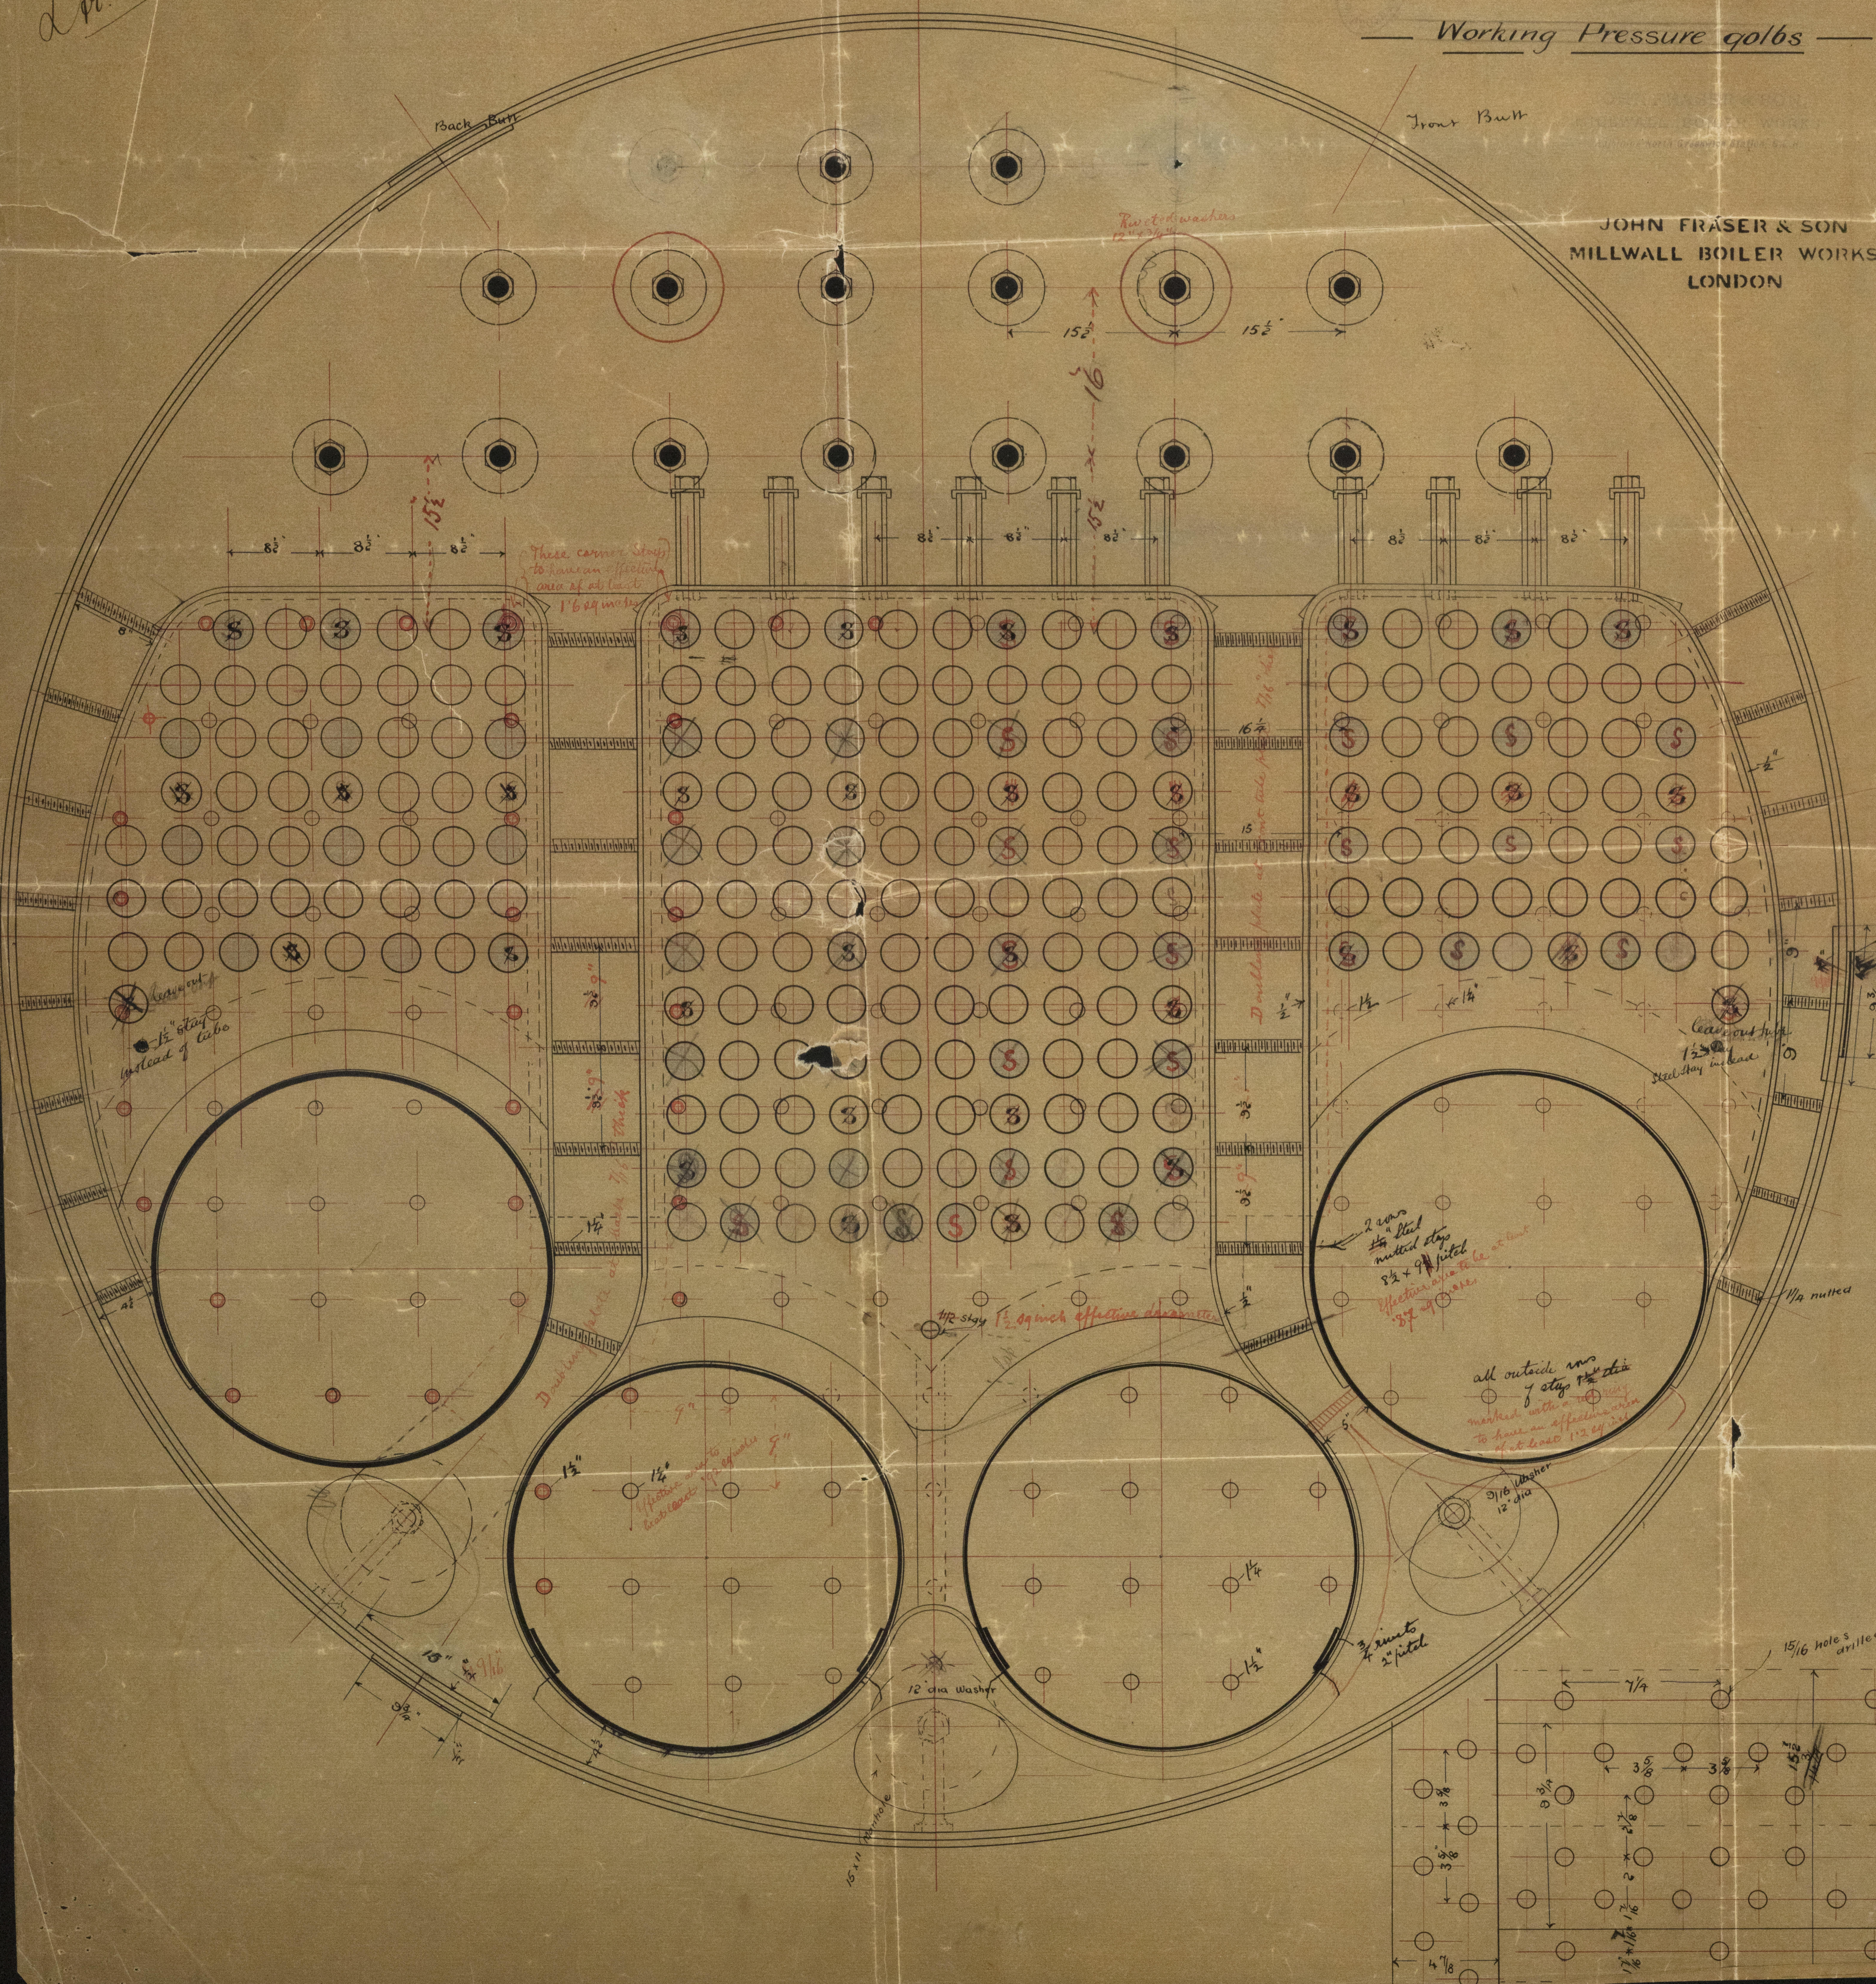

# Particulars of tubes

Total 170 — ordinary tubes to project 1 1/2" thru front tube plate		

## Stay Tubes


Ordinary tubes 2 3/4 dia swelled 1/8" at front end 8 WG thick  
 Stay tubes 3 3/4 dia screwed threads per inch in front end 1/4 thick } both ends of these tubes beaded  
 back end

5' x 5' pitch





50752-0024

bottom plates

1/2" x 1/2" x 1/2"


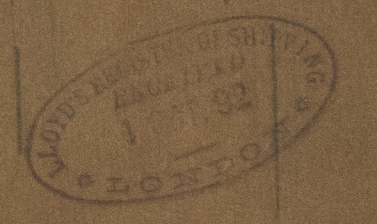




