



TWO STEEL DONKEY BOILERS FOR SS "METHVEN" & "DUNBAR CASTLE"

TO PASS BOARD OF TRADE & LLOYDS SURVEY

SCALE $\frac{1}{2}'' = 1'-0''$

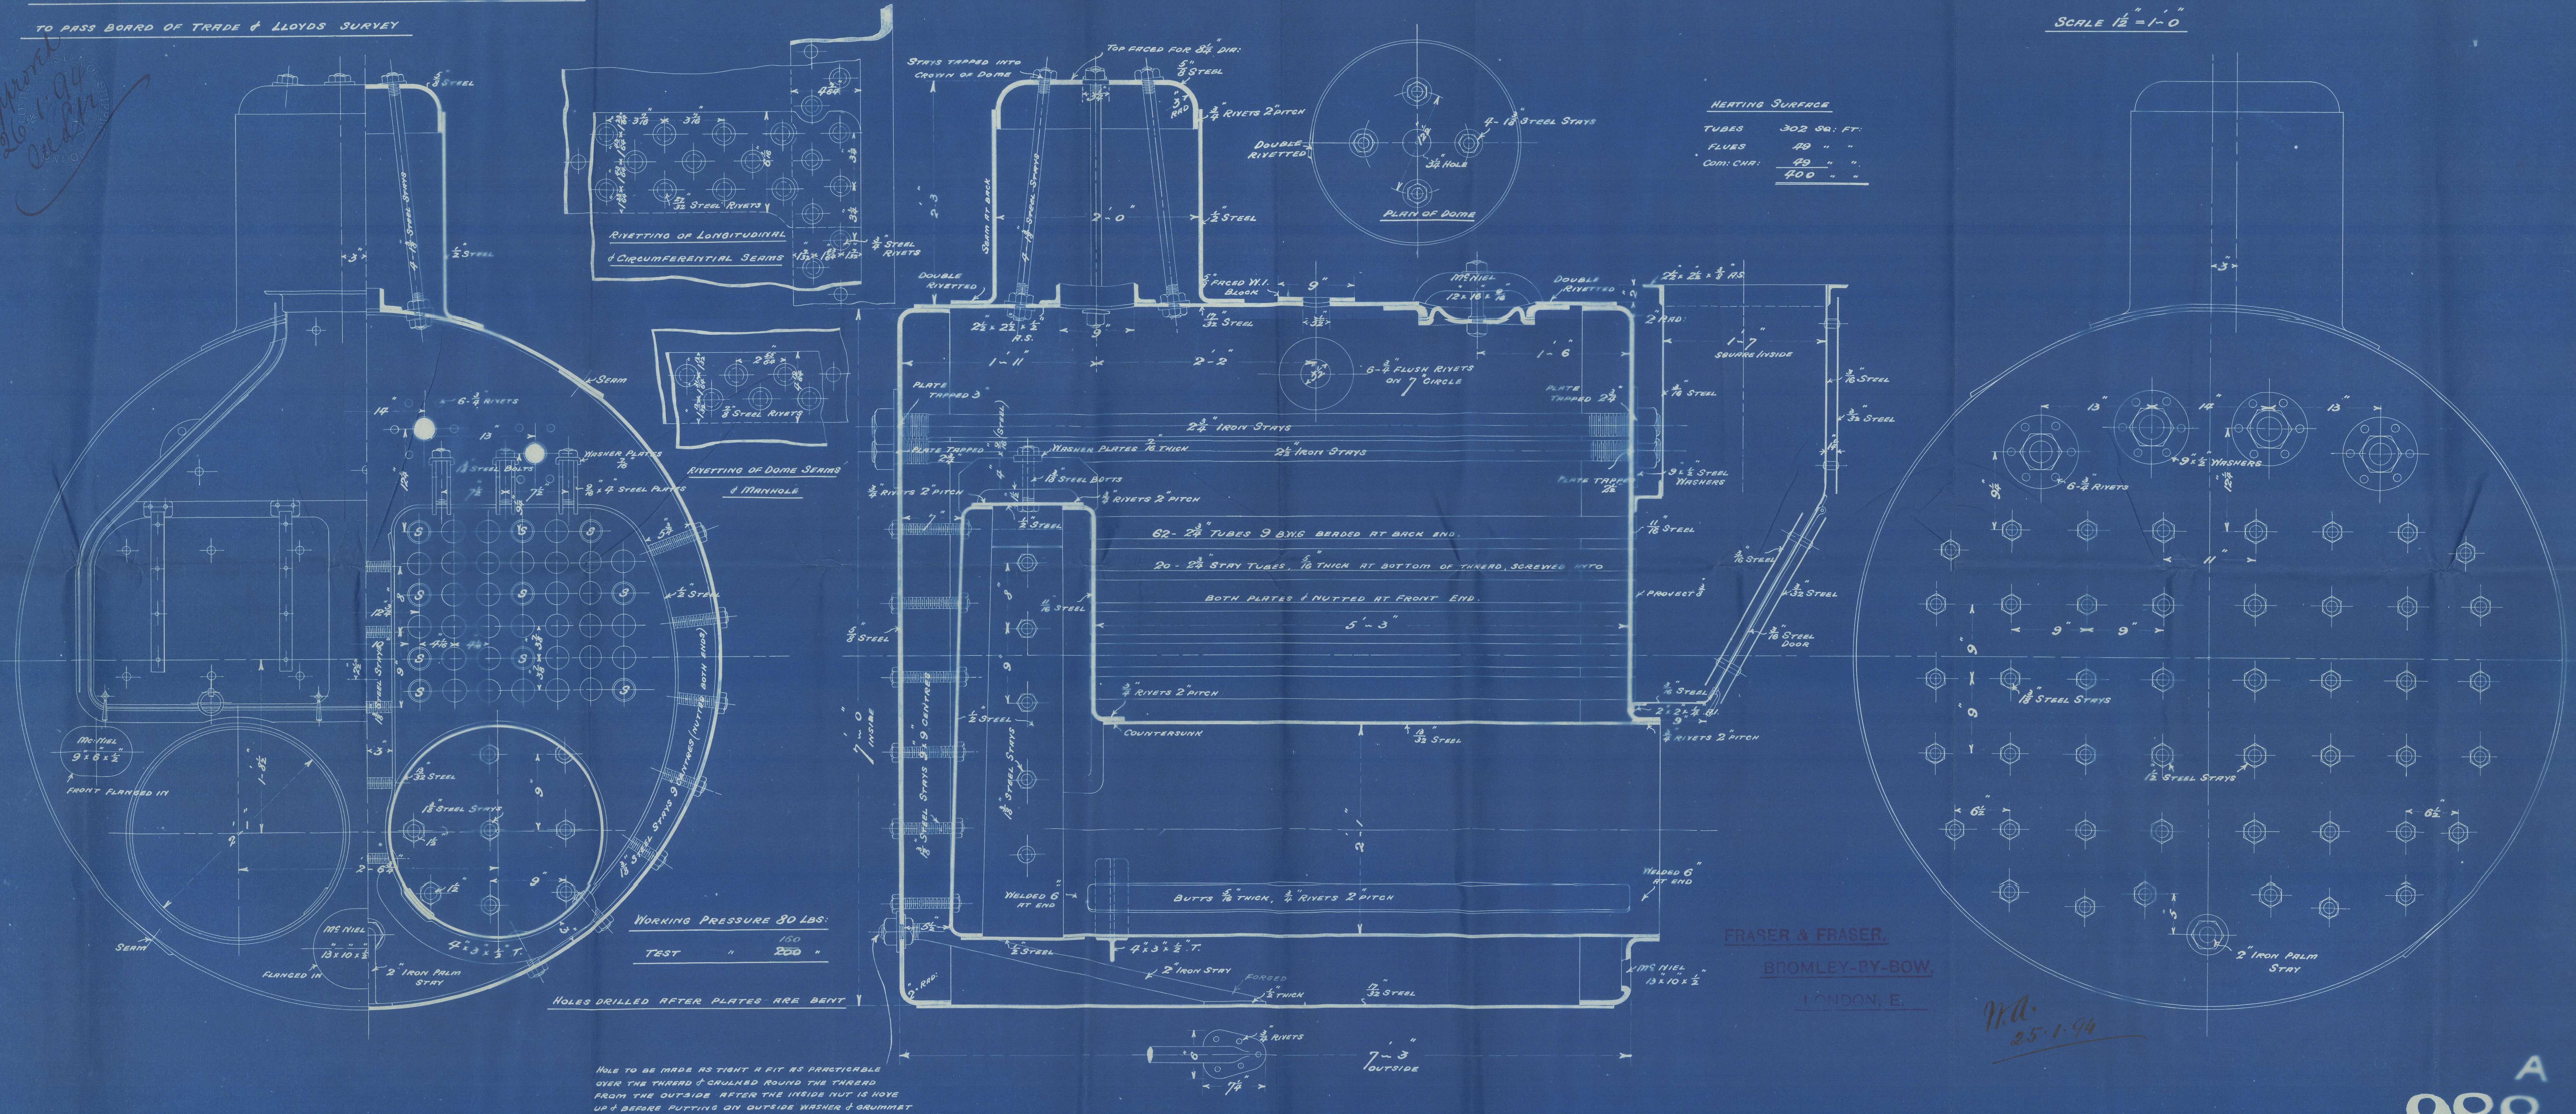

A
988

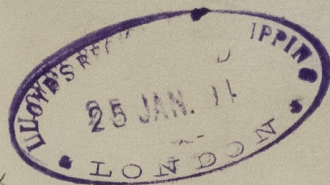

O. Rollins
for
Wethersfield
&
Dunbar Castle
Row. Report
56319
T



© 2021

Lloyd's Register
Foundation

LON728-0029