

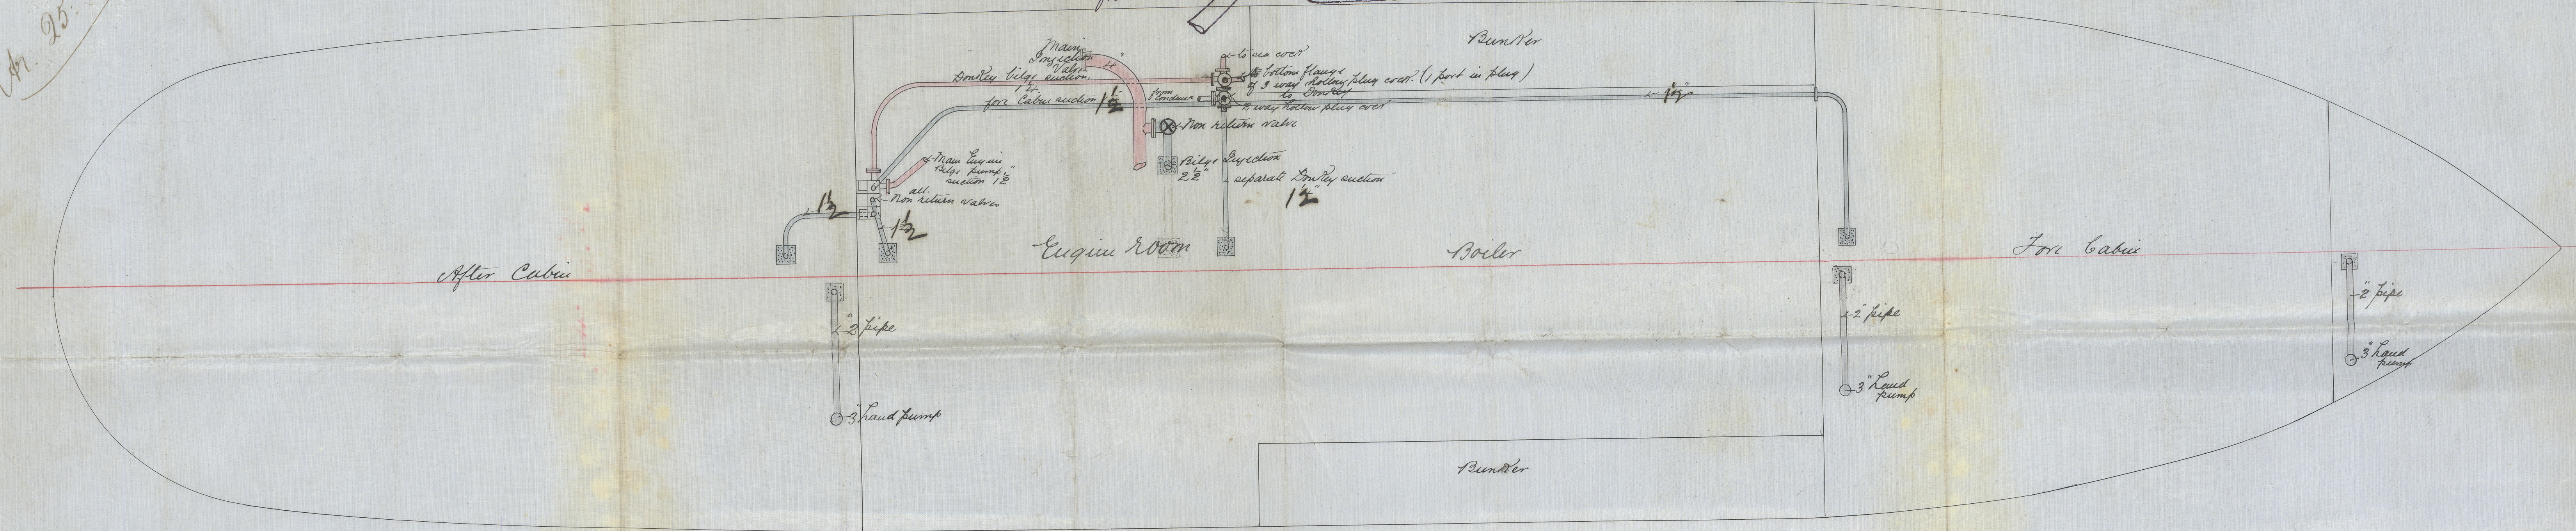


Rev. 25. 2. 90

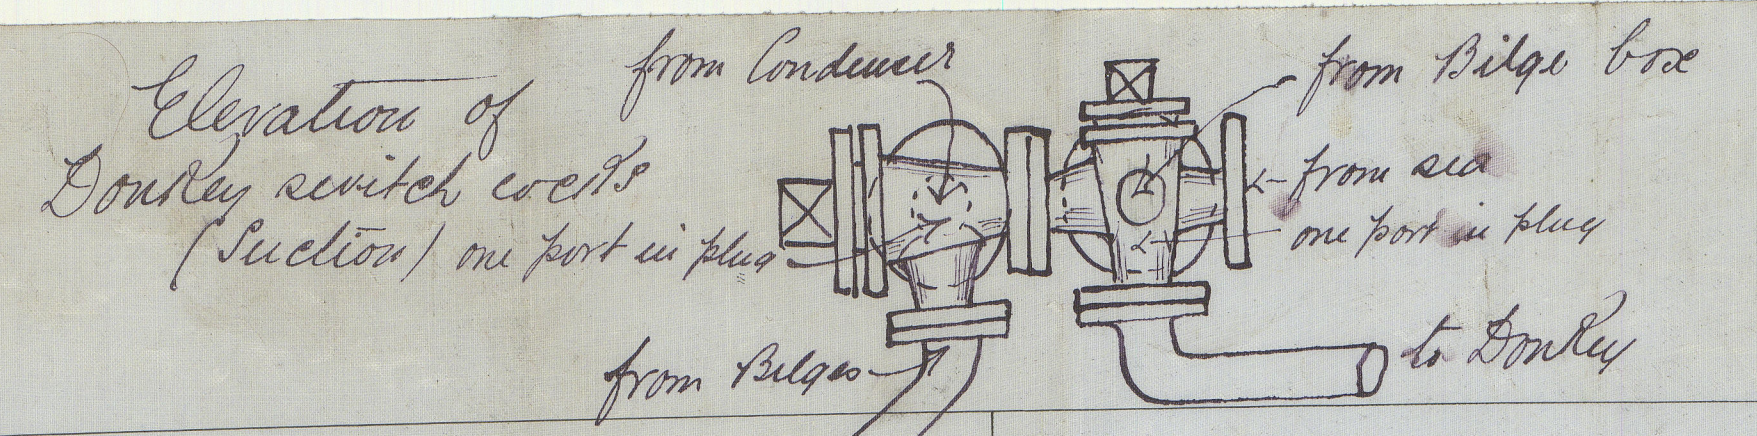


Bilge Pipe Arrangement
 Vessel No 126 Eng No 56
 Scale 1/2" = 1 foot
 20-2-95

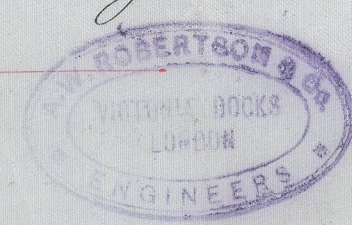



JM
 25/2/95

L. Luetta
London. 56598.

18/1/57
MS

 

18/1/57
MS
18/1/57
MS

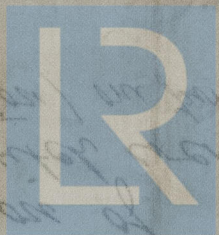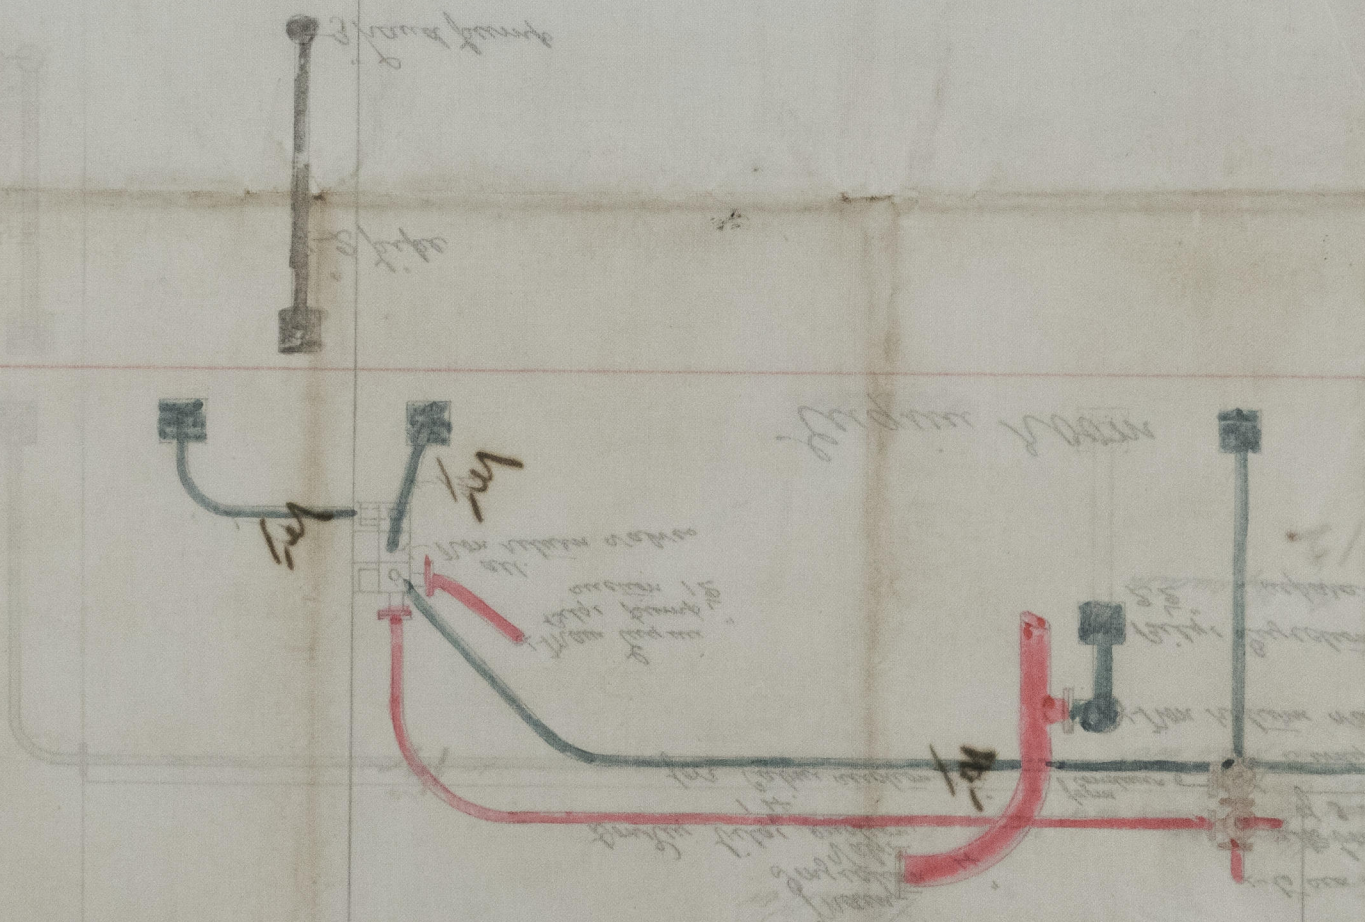

© 2021

Lloyd's Register
Foundation