







LOIDS REGISTER OF SHIPPING  
RECEIVED  
12 OCT. 94  
LONDON

10. 10. 01. 20

20th of Dec.  


 ↓

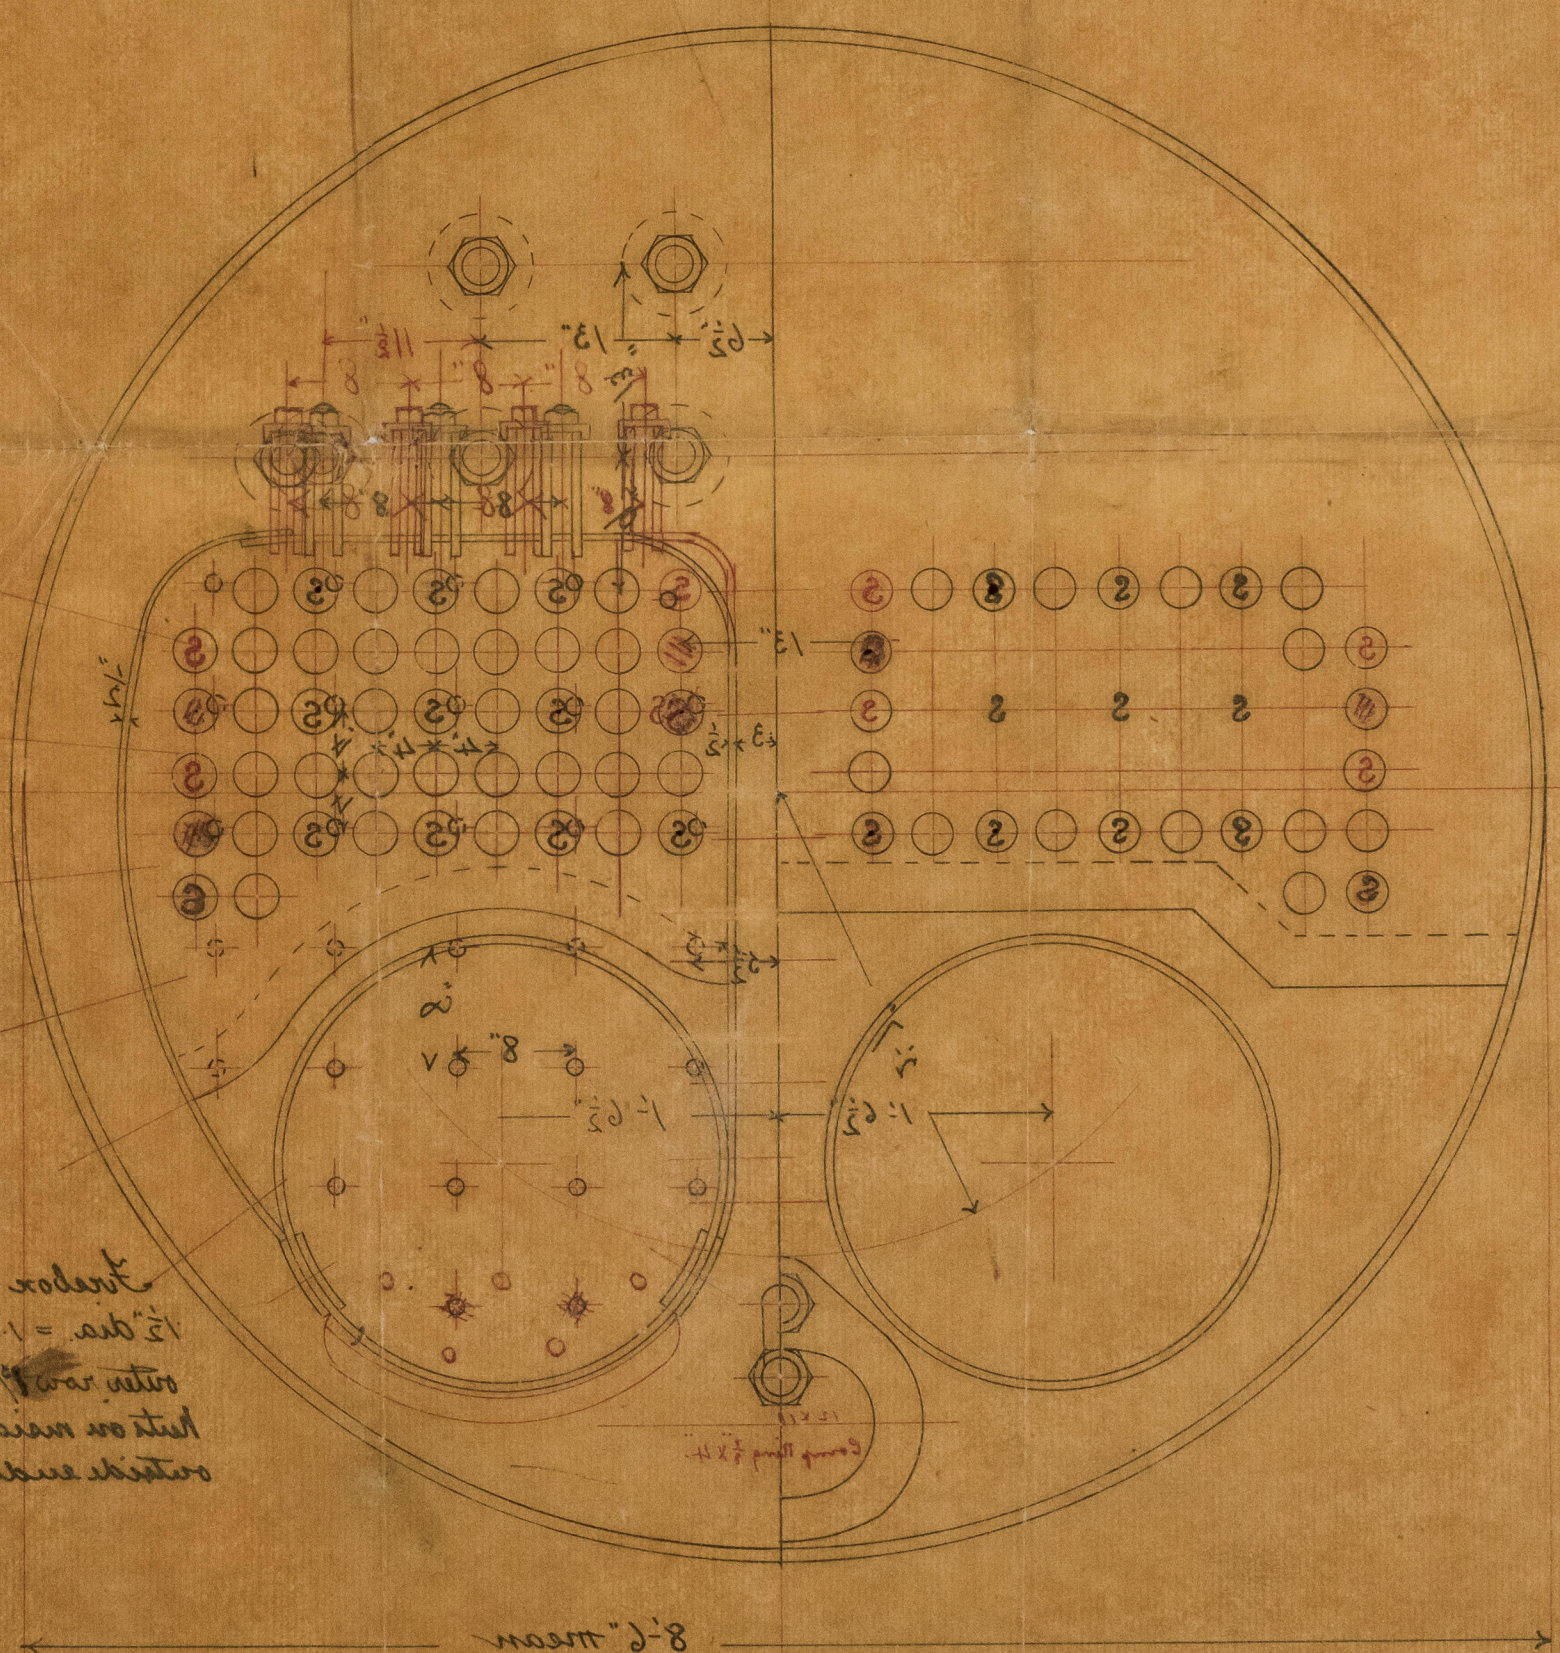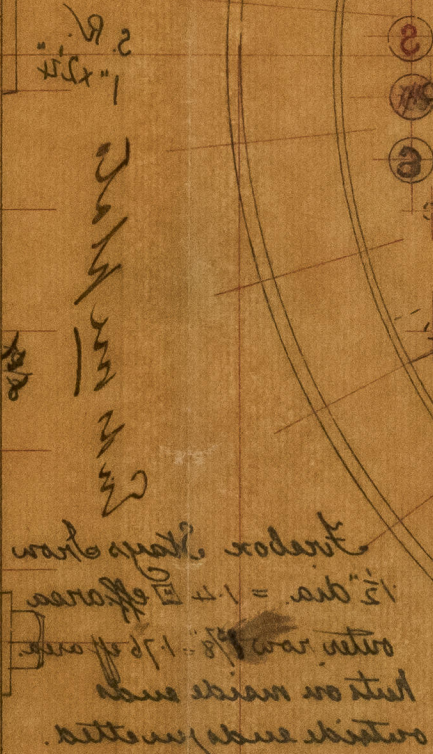

~~the table marked as above~~  

11-10-11