
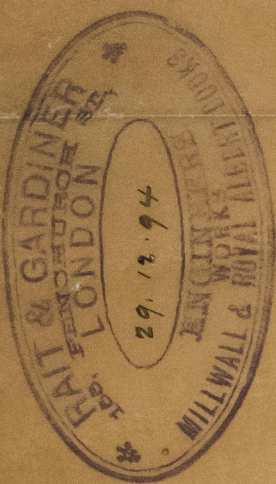


Mississippi. b.b.

London No 20100

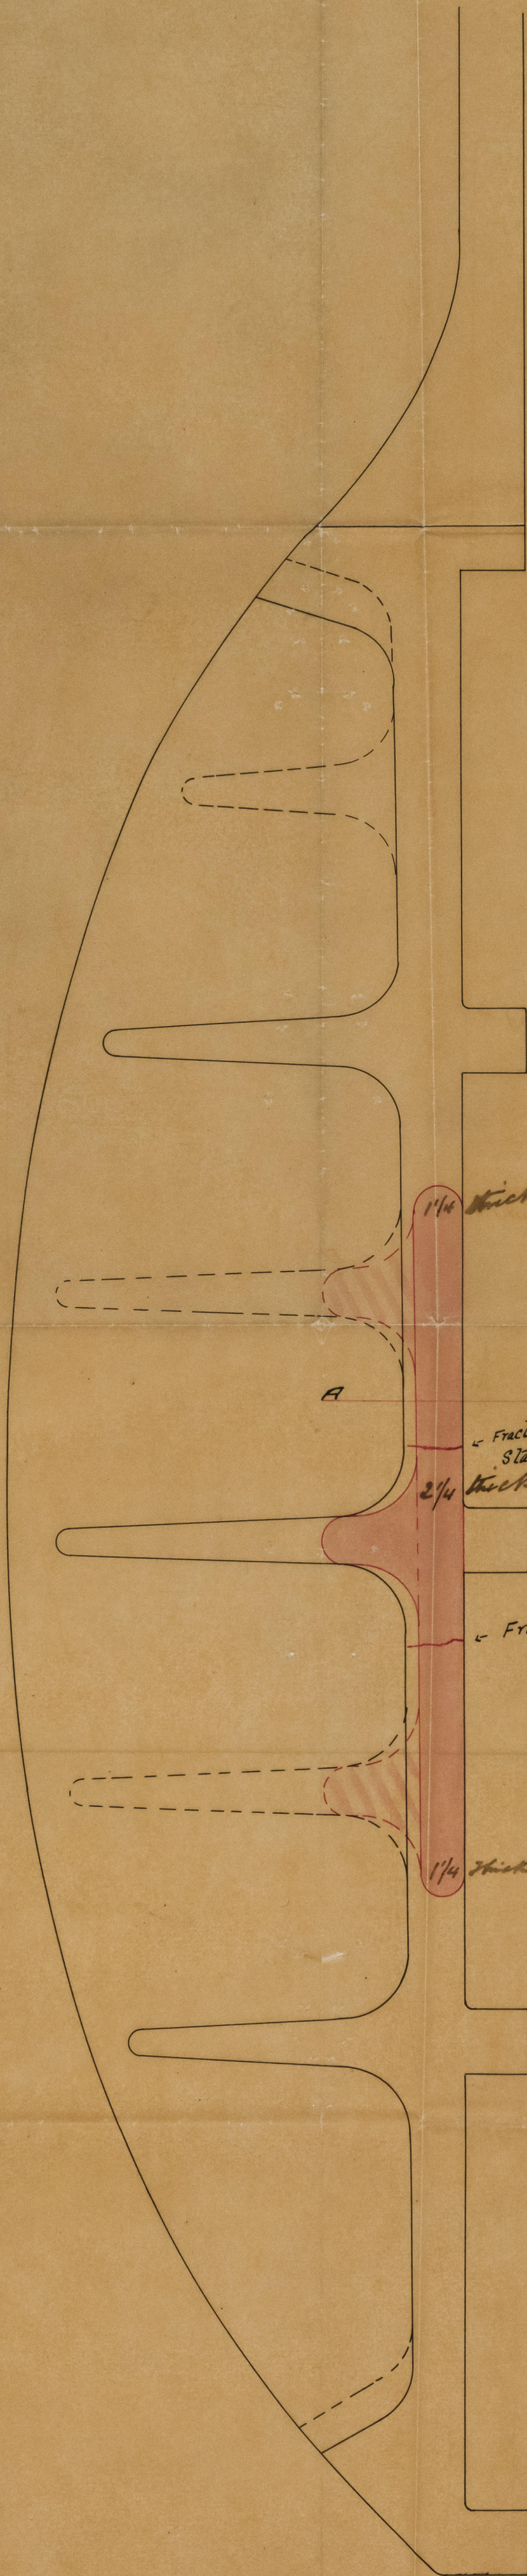

ss "MISSISSIPPI"

REPAIRS TO RUDDER

SCALE 3' / FOOT




© 2021
Lloyd's Register
Foundation

LON 728-0200

S.S. Mississippi


London No. 56106.

0010-81LN07

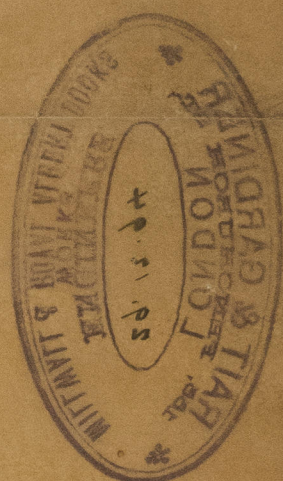

Section A.B.
3/4" = 1 foot

Fracture on
Starboard side
1/4" thick
Fracture on
Port side
1/4" thick

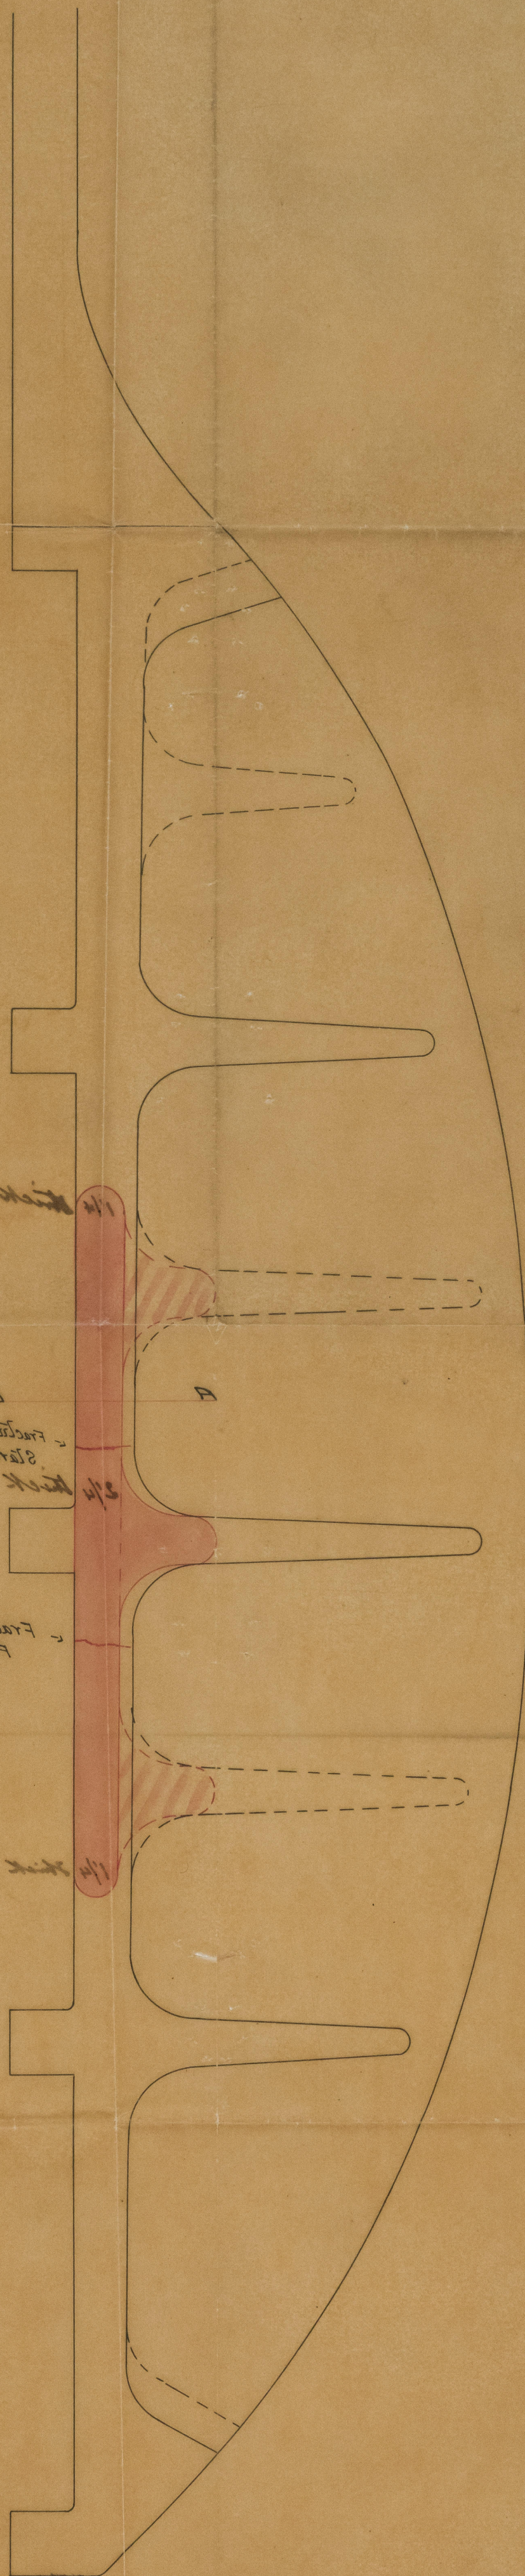



SCALE 3/4" = 1 FOOT



© 2021
Lloyd's Register
Foundation

0010-81LN07