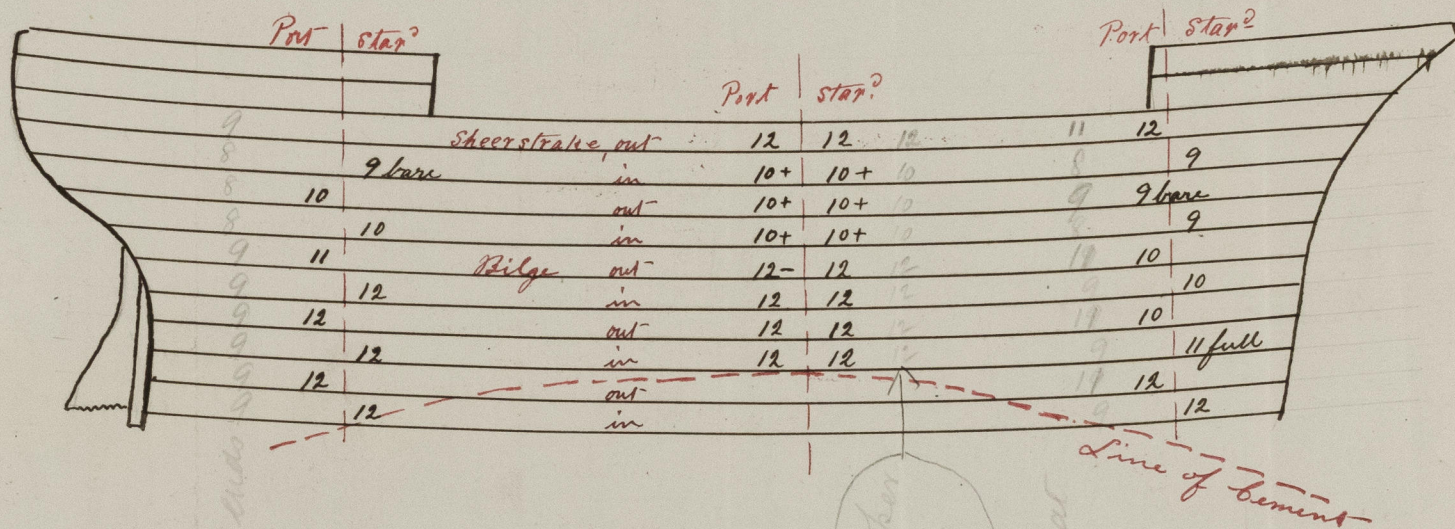


56894 Lon

30th August
1895

Iron Ship "Turakina"

Sketch shewing present thickness of plating in sixteenths

Reduction allowed at ends
per RuleOriginal thickness per
Survey ReportReduction allowed at
ends per Rule

© 2021

Lloyd's Register
Foundation