



Lloyd's Register of British and Foreign Shipping.

(Report on Vessel No. _____ Port _____)

No. 3196.a. SHIP FORGINGS OR CASTINGS.

I have to report that the undermentioned Iron ^{and} ~~or~~ Steel Forgings ^{and} ~~or~~ Castings, manufactured by The Darlington Forge Co.

of Darlington for the Vessel No. _____, being built by S/S "Woodbroomloo" of London

have been inspected by me as set forth below, and found to be, so far as can be seen, sound. The stern frame tested as required by the Rules and found satisfactory

The words FORGINGS or CASTINGS, IRON or STEEL, should be struck out as may be required.

Mark on Forgings.

Lloyd's
No. 3196.a
No. 6.


Rough Cameron

Sunderland


4.1.96.

	STERN FRAME.	RUDDER FRAME.	STEM.
Material*	<i>Simons steel</i>	<i>Scrap iron</i>	
How made	<i>Cast</i>	<i>Forged</i>	
Dimensions	<i>as per plan attached</i>	<i>9' - 4 1/2"</i>	
Progress on Inspection	<i>Cast tested</i>	<i>Forged Smithed</i>	
Date when Inspected	<i>Dec 27-30/95 Jan 2/96</i>	<i>Dec 20-24-27-30/95 Jan 2/96</i>	

SKETCHES OF FRAMES SHOWING POSITION AND DESCRIPTION OF WELDS OF FORGINGS, OR PARTICULARS OF TESTS APPLIED TO CASTINGS.

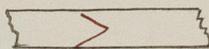

Welds

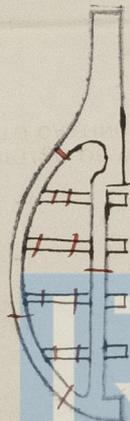

Examined this ~~forging~~ and the steel plates, as per test note attached hereto; during progress of being riveted together; at the Shipyard of Messrs McGray & Co Ltd, W. Hartlepool; found workmanship good.



Fee (if any chargeable) £ 4 : 4 : 0.

To be paid at **SUNDERLAND.**

* If of Iron, state whether scrap or puddled Iron.