



6 cyl Multitubular
Steel Boilers
Constructed by
Lodge & Sons
Milwall
150 lb pressure


| | | |
|--|--|--|
| N ^o 324 Lloyd's test 300 lbs 16.7.96 T.R.B | N ^o 327 Lloyd's test 300 lbs 18.9.96 T.R.B | N ^o 328 Lloyd's test 300 lbs 18.9.96 T.R.B |
| N ^o 332 Lloyd's test 300 lbs 21.8.96 T.R.B | N ^o 334 Lloyd's test 300 lbs 3.9.96 T.R.B | N ^o 335 Lloyd's test 300 lbs 4.9.96 T.R.B |

London Rpt
No 58041

LON 730-0158



© 2021

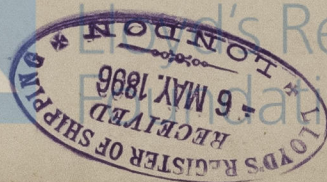

Lloyd's Register
Foundation