

N^o 371 VESSEL.


SCALE 1" = 1' F.

Lloyd's Numerals.

1st. 35.9
2nd. 3913.1

Midship Section of Twin Screw Steamer for
Messrs T. A. Young & Son, Engineers, Blackwall.
Builders, Edwards & Co. Millwall, who
will pay fees for Hull.

TO CLASS 100 A1

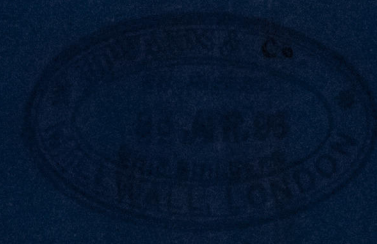

© 2021 Lloyd's Register Foundation


Thos S. S. Munzinger & Co

Approved
Ind Section

London. 55803/4

Built by Thomas Co
Melwall 1896
1/2

Builder no 371

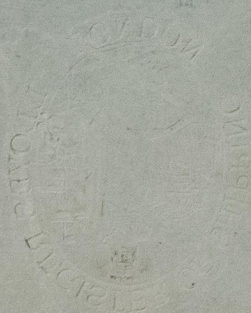

© 2021

Lloyd's Register
Foundation