

LONDON OFFICE, 4, ST. MARY AXE, E.C.

Alfred Dodman.

TELEGRAPHIC ADDRESS
DODMAN,
KINGS LYNN.

MANUFACTURER OF
PORTABLE, SEMI PORTABLE
AND TRACTION ENGINES

VARIOUS DESIGNS
OF HORIZONTAL AND
VERTICAL ENGINES.

MARINE ENGINES,
BOILERS & LAUNCHES.

HOISTING, WINDING AND
PUMPING ENGINES.

IRON & BRASS CASTINGS,
MILL GEARING,
CONTRACTORS PLANT
IN GENERAL.

ENGINE, BOILER OR
MILLWRIGHT REPAIRS
BY COMPETENT MEN & TOOLS

Engineer · Boiler-maker · Founder.

OIL MILL
MACHINERY.

HIGHGATE WORKS,

Kings Lynn December 19th. 1896.
ENGLAND.

Mr. W. Morrison,

Dear Sir,

Where the Combustion Chamber side plate, the tube plate & the flue join there will be 3 thicknesses of plate as per sketch below as it is my custom to cut away the tube plate leaving the flue joined to the combustion side plate only I shall be pleased to hear from you by wire on Monday morning if this is acceptable by you or if you prefer to have the 3 thicknesses kept in.

Yours faithfully,

Alfred Dodman.

Wm


NR

LON731-0023

Wired 21.12.96 47

"Amended sketch approved
provided sufficient landing
letter follows"

Morrison

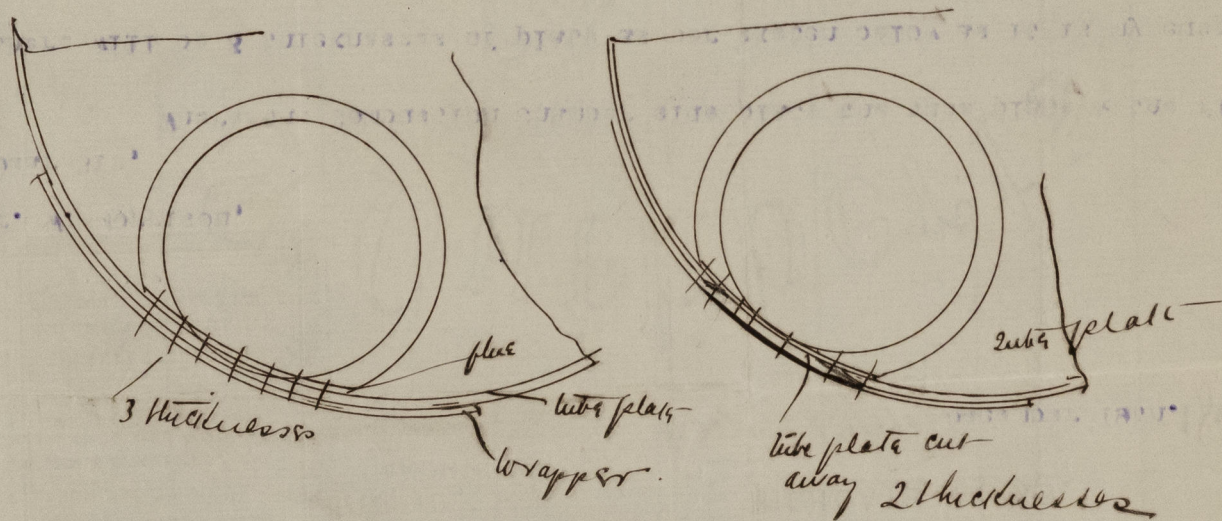

© 2021

Lloyd's Register
Foundation