


Feb. 5. All.
20:5. All.
LONDON

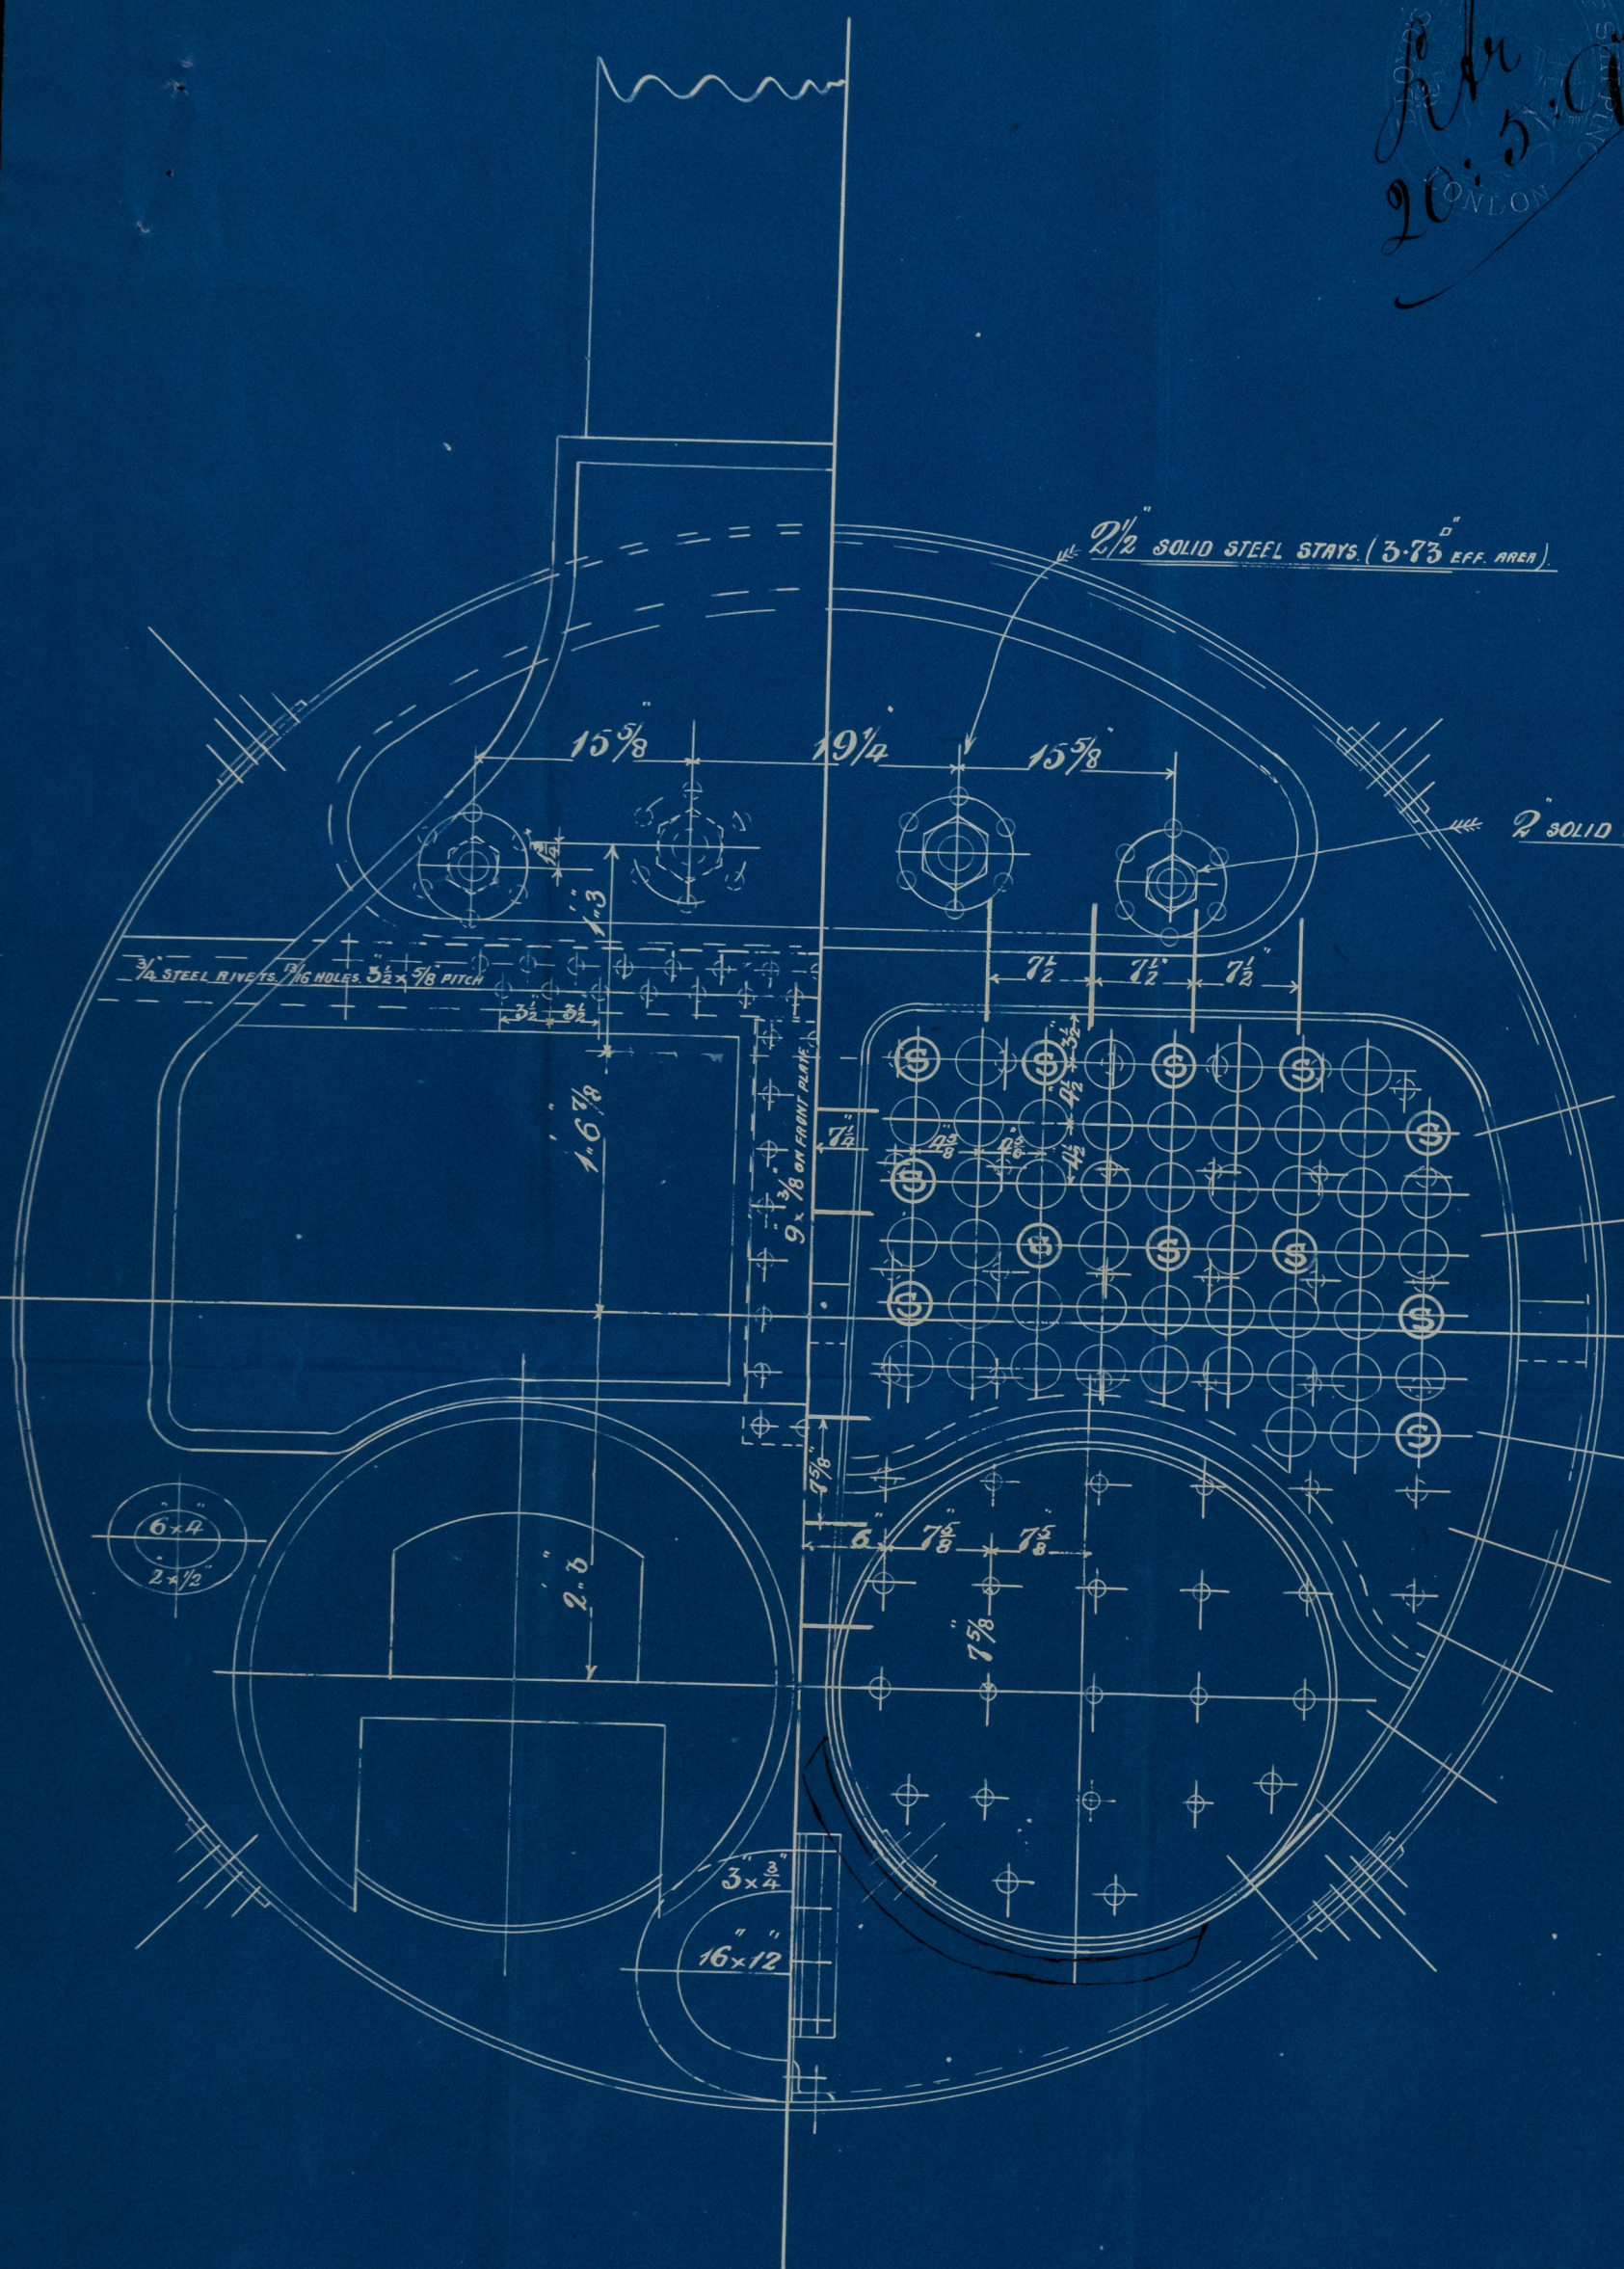

2 SOLID STEEL STAYS (2.31^D EFF. AREA)

24 - 3/4" x 1/4" STAY TUBES, screwed into both plates
88 - 3/2" x 10G PLAIN TUBES.
112 = TOTAL

S. T. "DUNCAN."

9' 6" x 9' 3" STEEL BOILER.

FOR M^{ESSRS} R & H. GREEN. —

TO LLOYDS' RULES & INSPECTION FOR 90 LBS. W.P.

SCALE 1 INCH = 1 FOOT.

JLS
 2005.97
 N. 3022
 8704. 19.5.97

Borlin No 34
Constructed by
Stodge & Sons
Milwall



for the
Steam Tug
"Juncan"

90 lbs.

No 360
Lloyd's test
180 lbs
20.8.97 T.R.B.

LON T31-0185



© 2021

Lloyd's Register
Foundation