


Tracing No. 223/B

See  
Ch 31.12.97

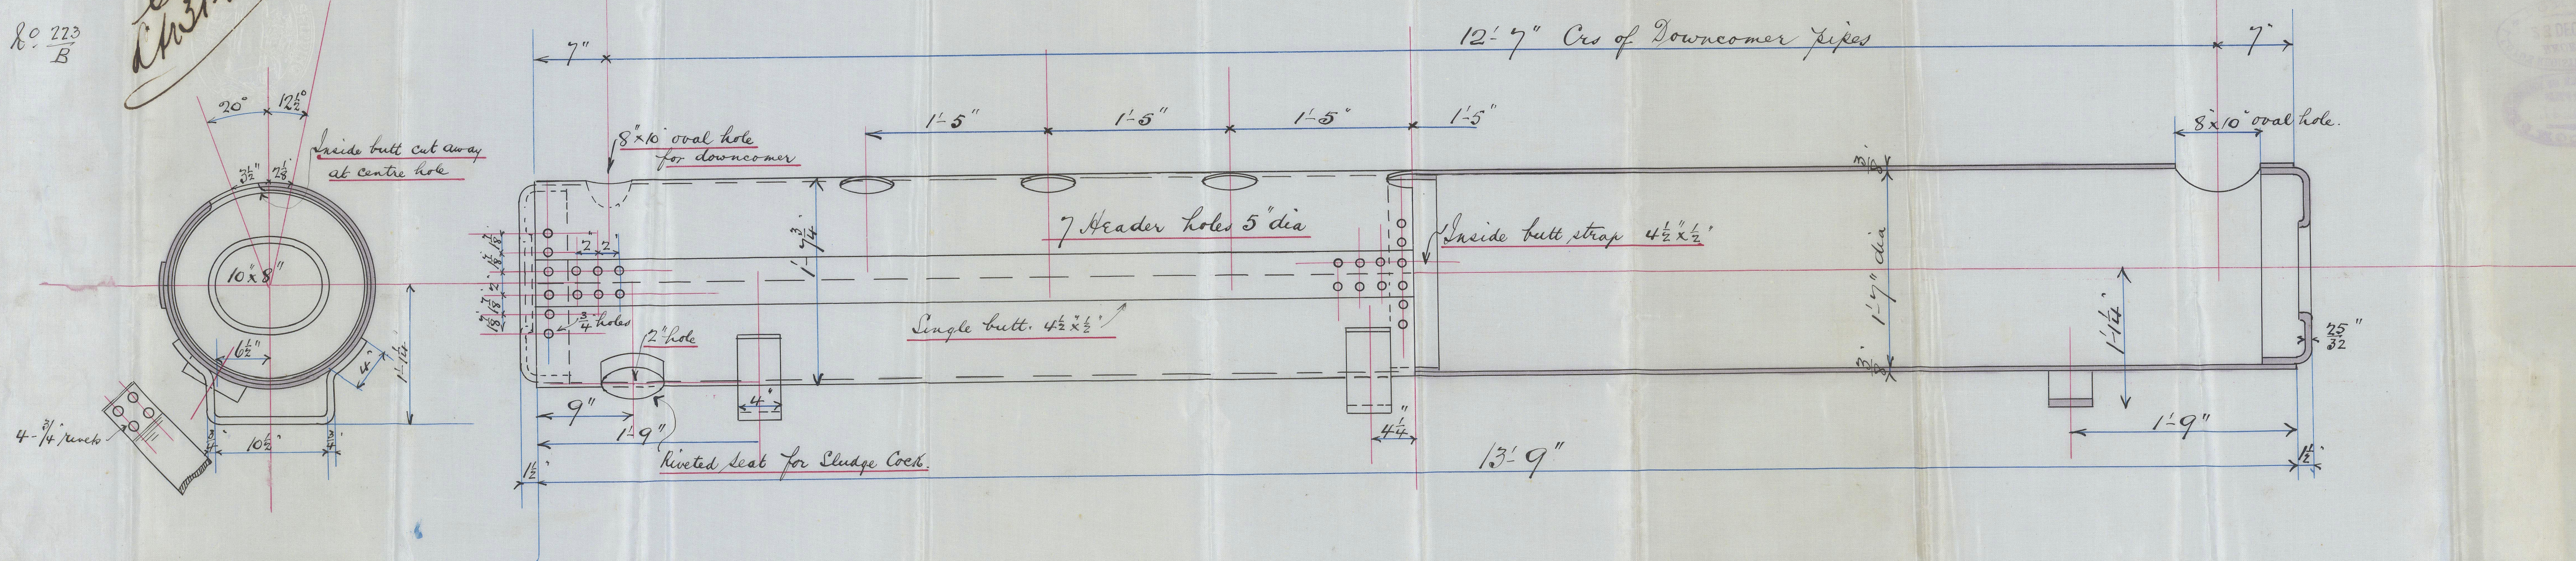



HORIZONTAL WATER DRUM.

ONE THUS.

S.M. STEEL.

Material

- 2 plates 7'-1" x 6'-10 1/2" x 3/8" Shell
- 1 — 13'-9" x 4 3/4" x 1/2" Butts
- 2 — 7'-1" x — x —
- 2 — 2'-1" dia x 23/32" Ends
- 12 — 1'-1" x 1" Downcomer flanges.
- 4 tubes 6 1/2" x 1/4" x 6'-10 1/2" Downcomers
- 2 — — x 3'-6" —

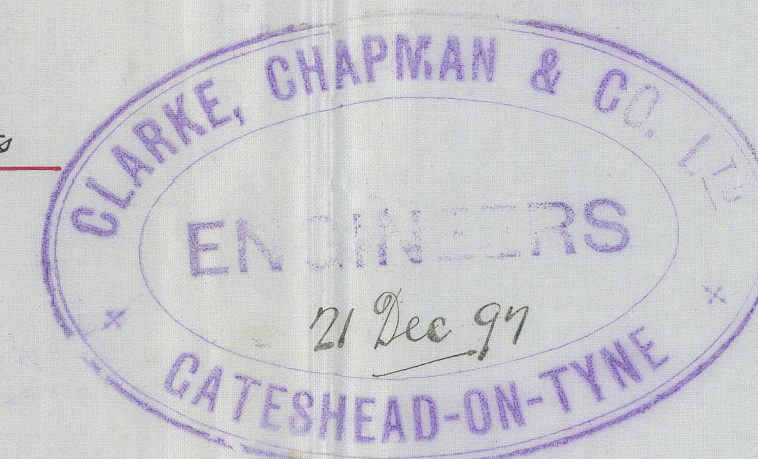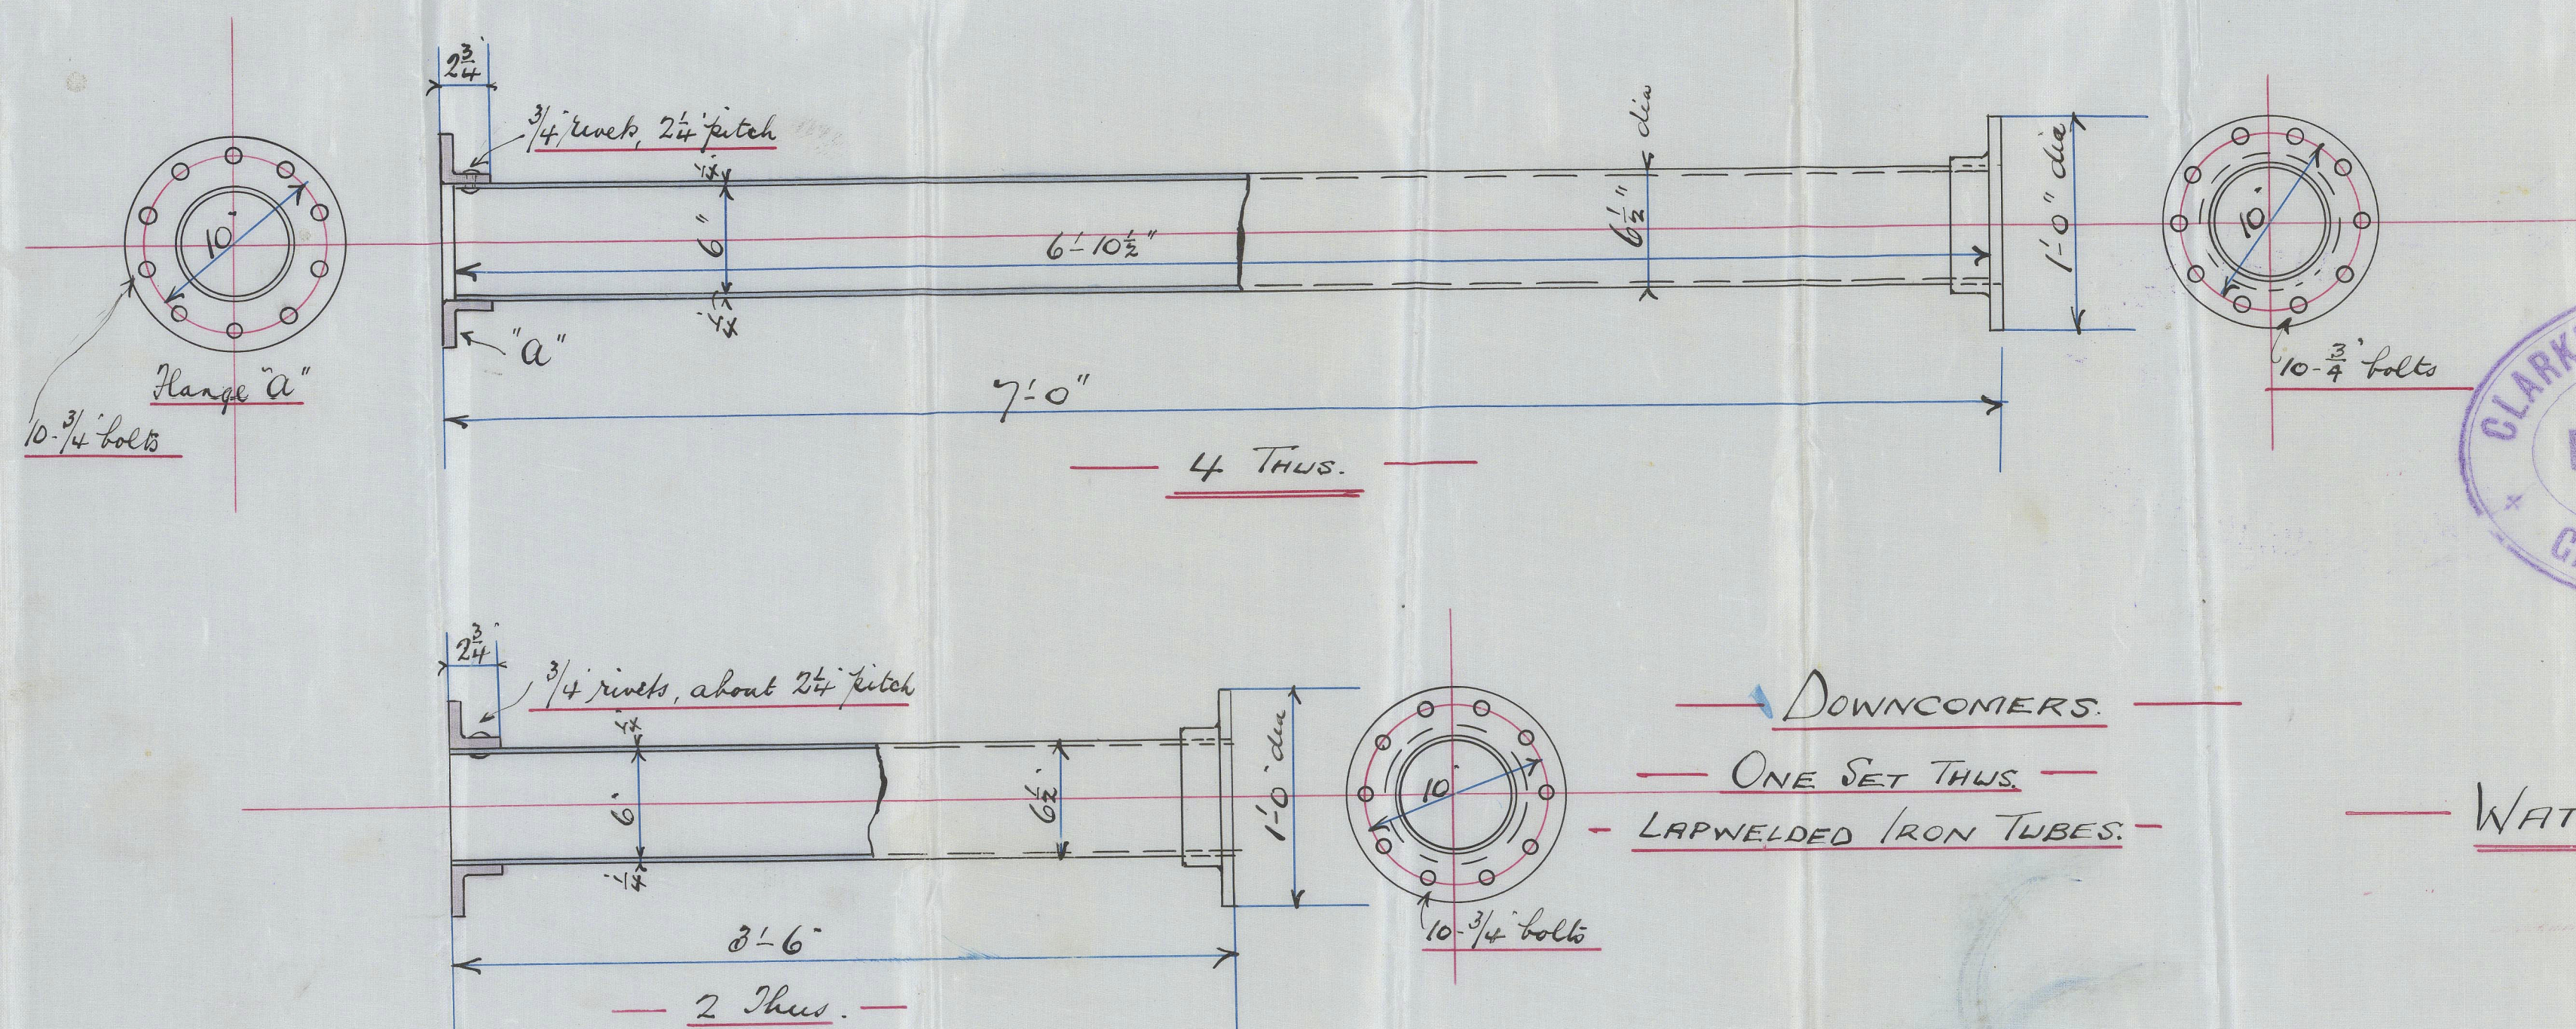

Nº 27376

WATER DRUM & DOWNCOMERS FOR "PETERSEN" BOILER.

5/8" BUTESHIRE


SCALE 1 1/2" = 1 FOOT.

W.P. 160 LBS.  
T.P. 320 —

LON 732-0065



Clarke, Chapman & Co  
& Ruteshwa

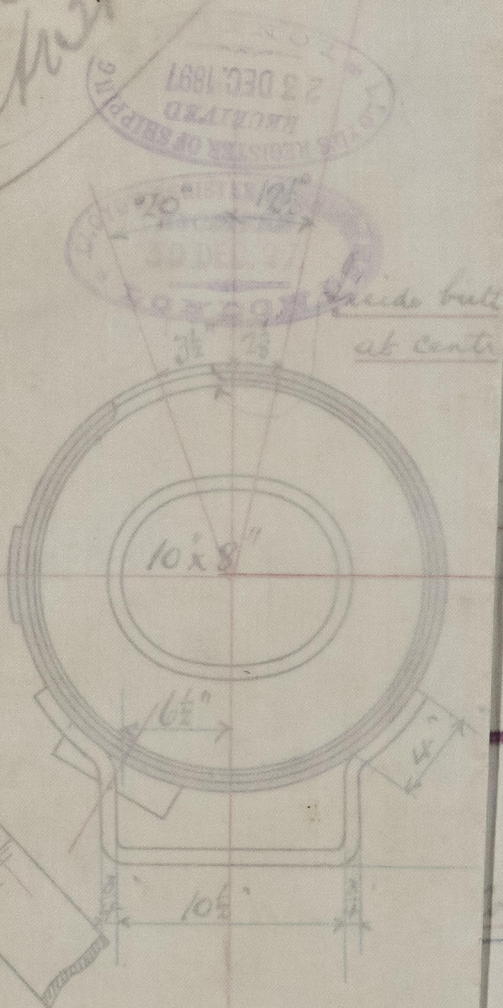

© 2021

Lloyd's Register  
Foundation

LON T32 0065