




Don
13.6.98

Proposed New Mild Steel Boiler No. 477

Working pressure 160 lbs per sq in.

Hydraulic test 320 lbs per sq in.

To Lloyd's requirements 10/6/98

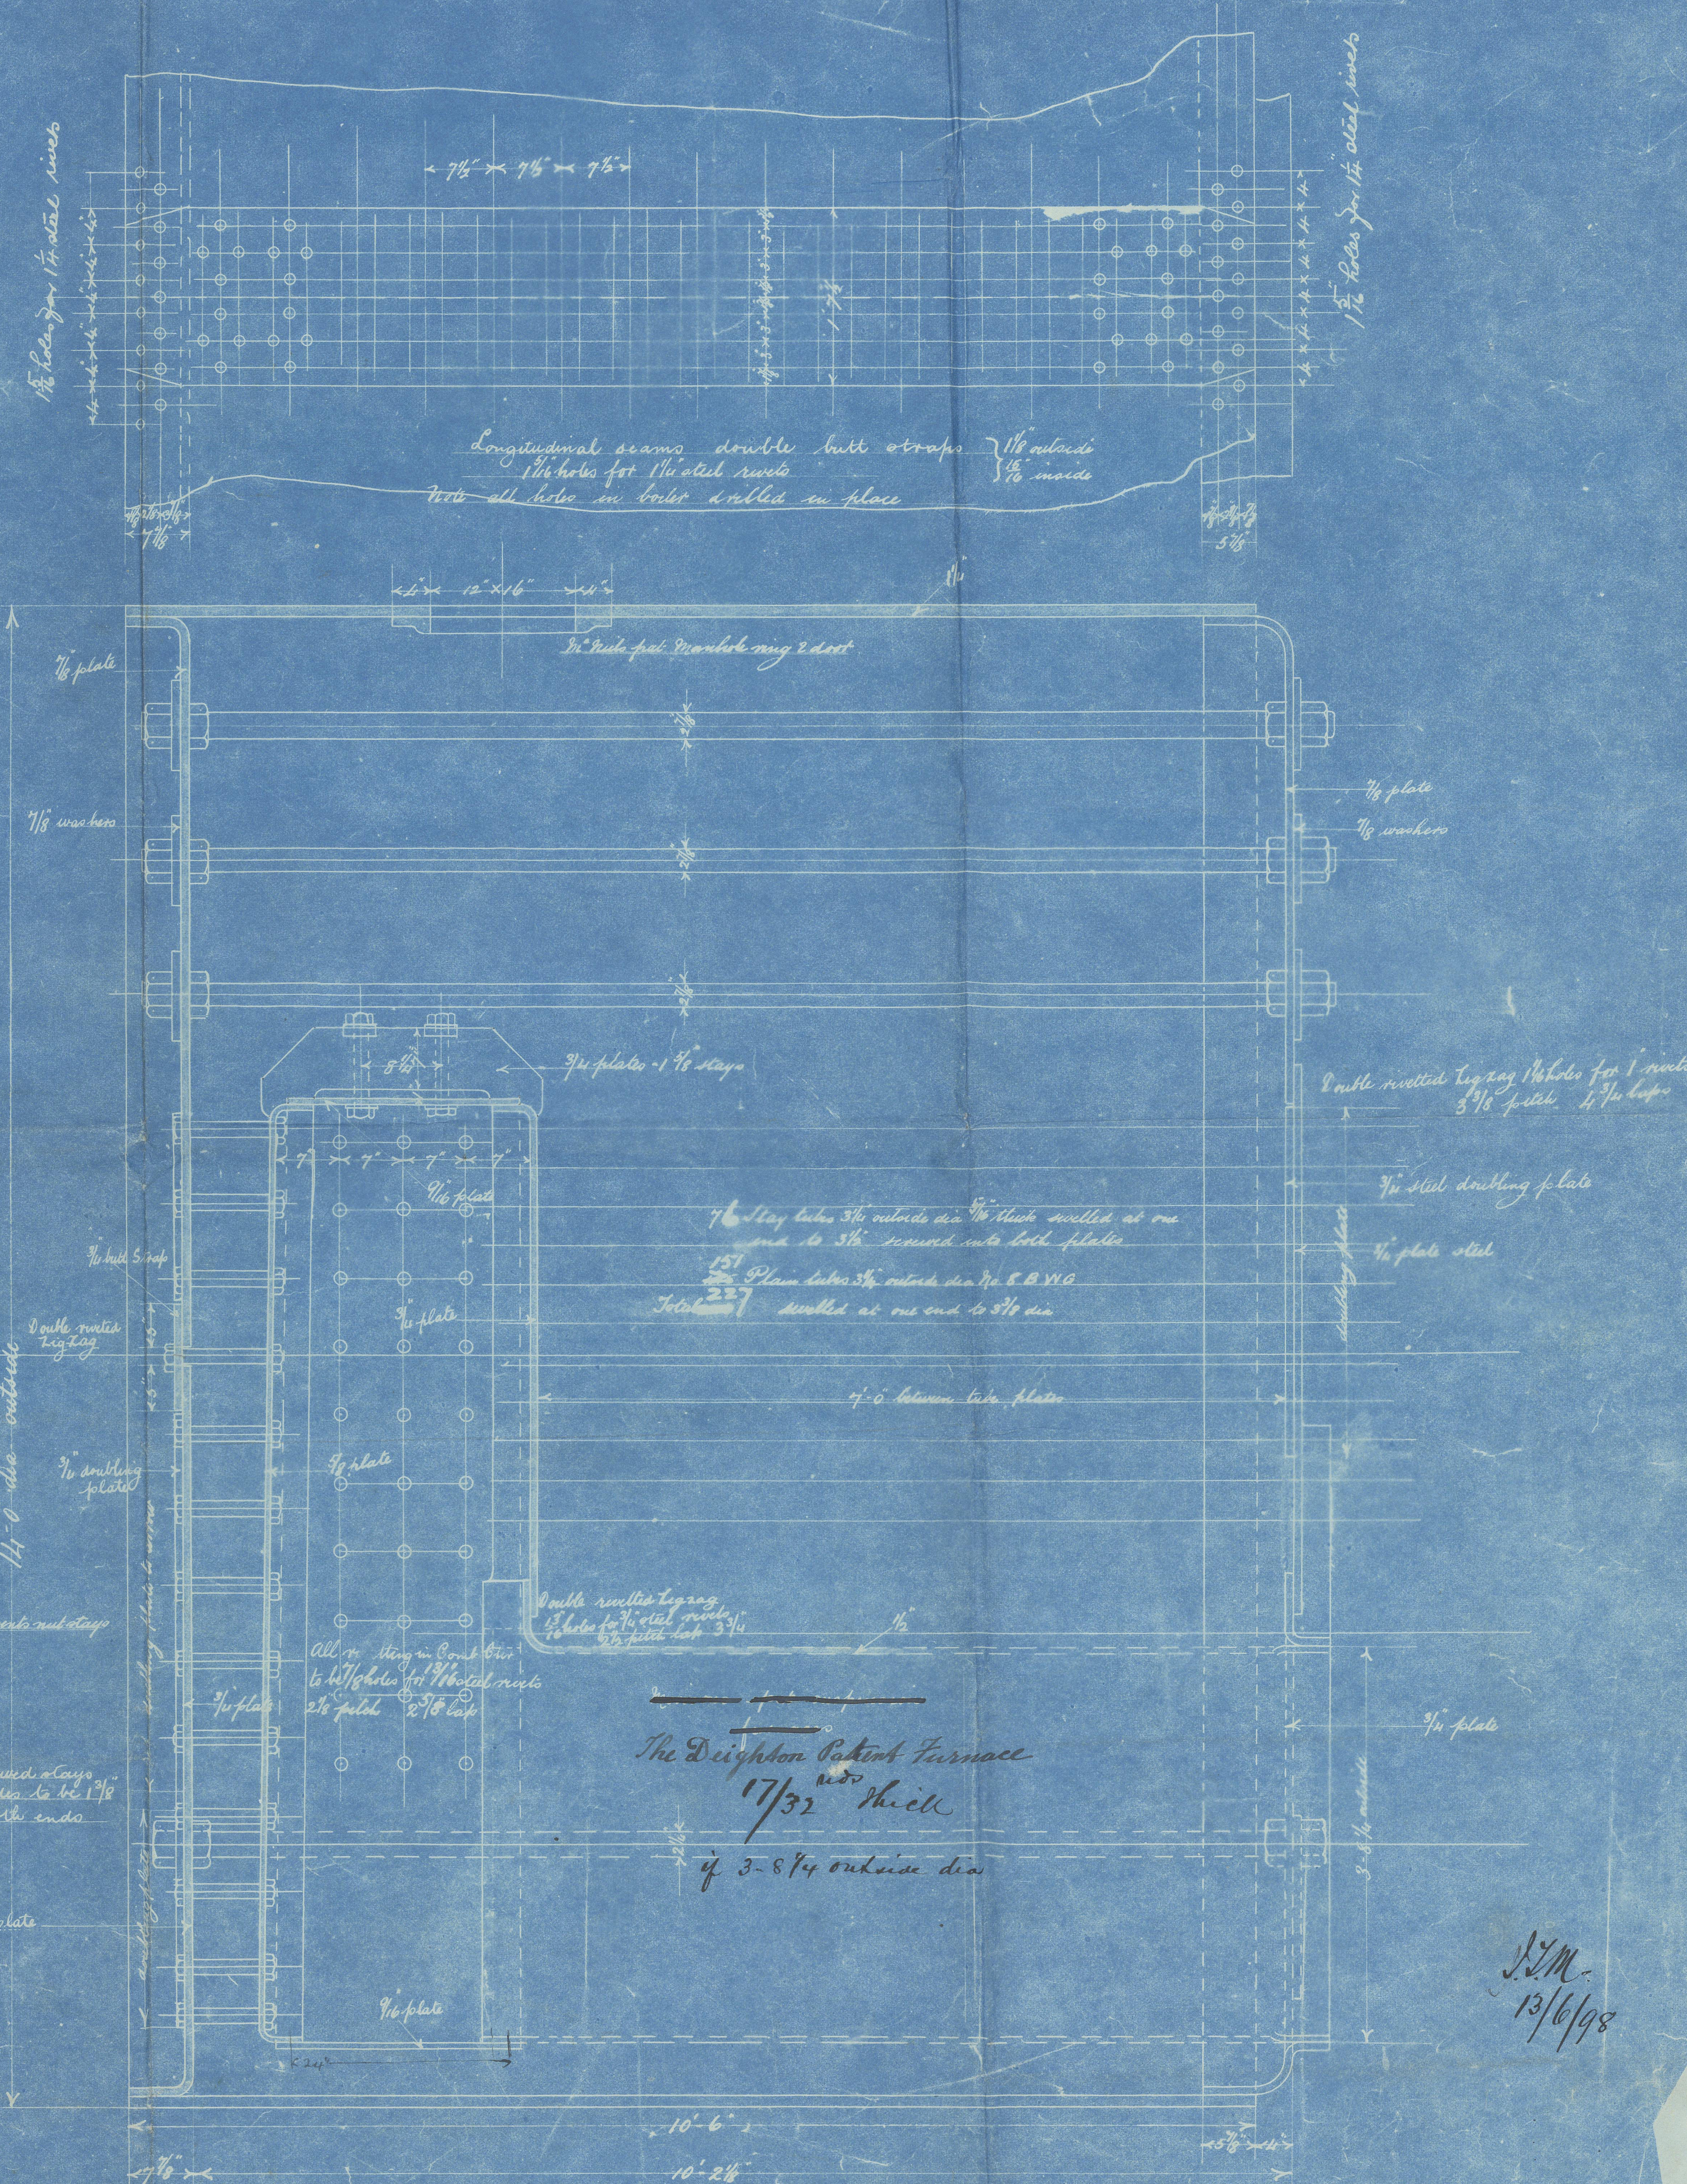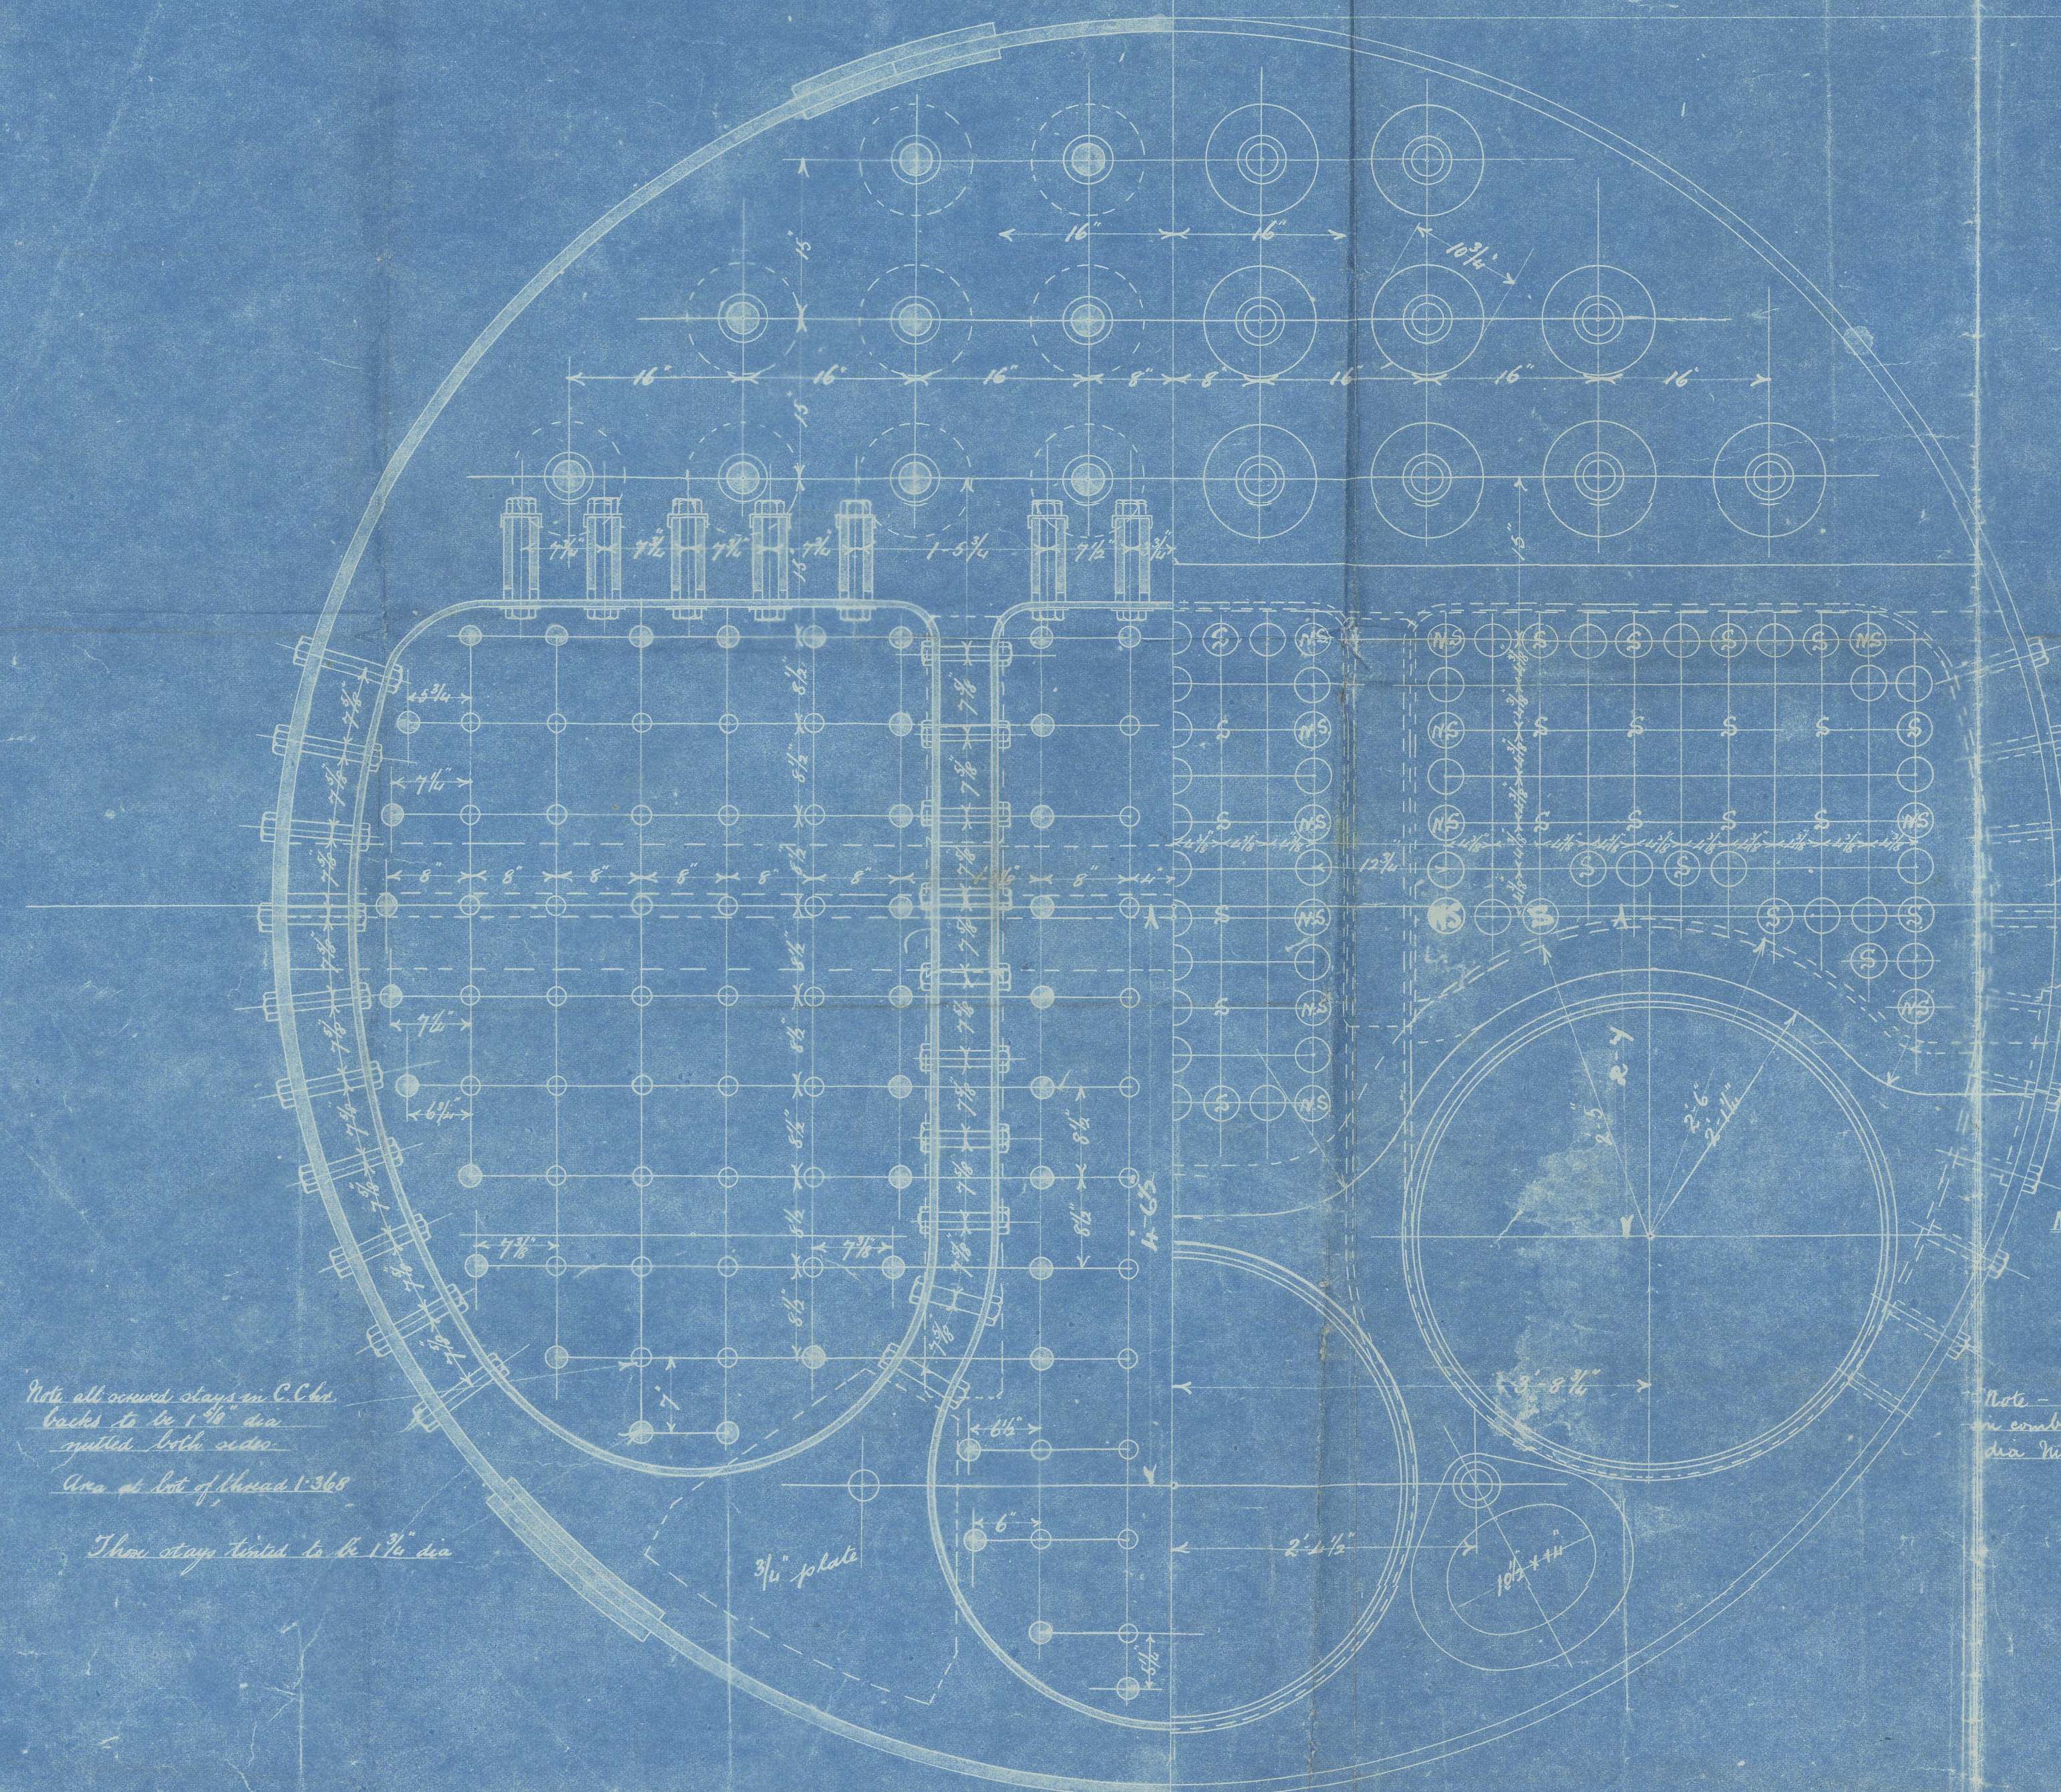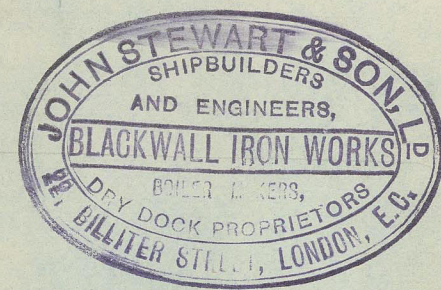

LONT32-0138



LON732-0138



© 2021

Lloyd's Register
Foundation