



(a) Corroded frames

(b) Frames and Reverse of  $3\frac{1}{4} \times 3\frac{1}{4} \times \frac{5}{16}$



(c) Rider plate & doubling rivetted on web frames considered corroded

Proposed plan for stiffening the corroded parts in Coal bunkers of the SS Elena D.

24 June 1905

Director

LON 732 - 0161

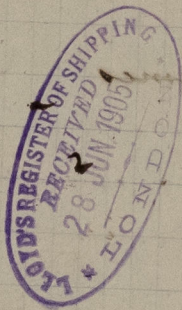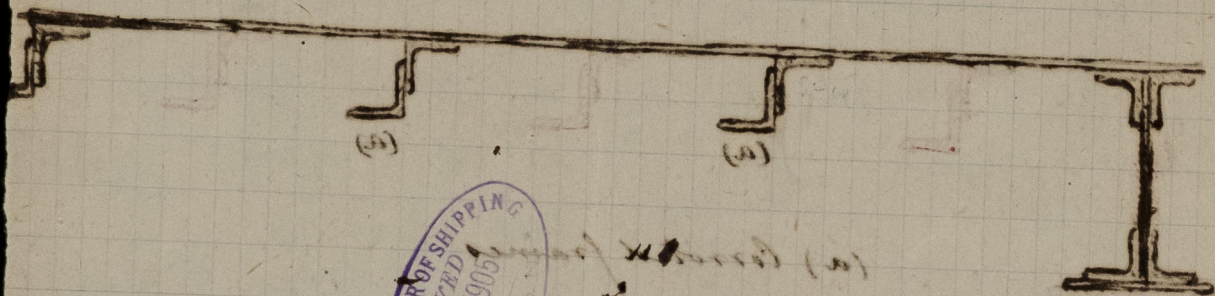




© 2021

Lloyd's Register  
Foundation