


Trinity 1439

26.8.99

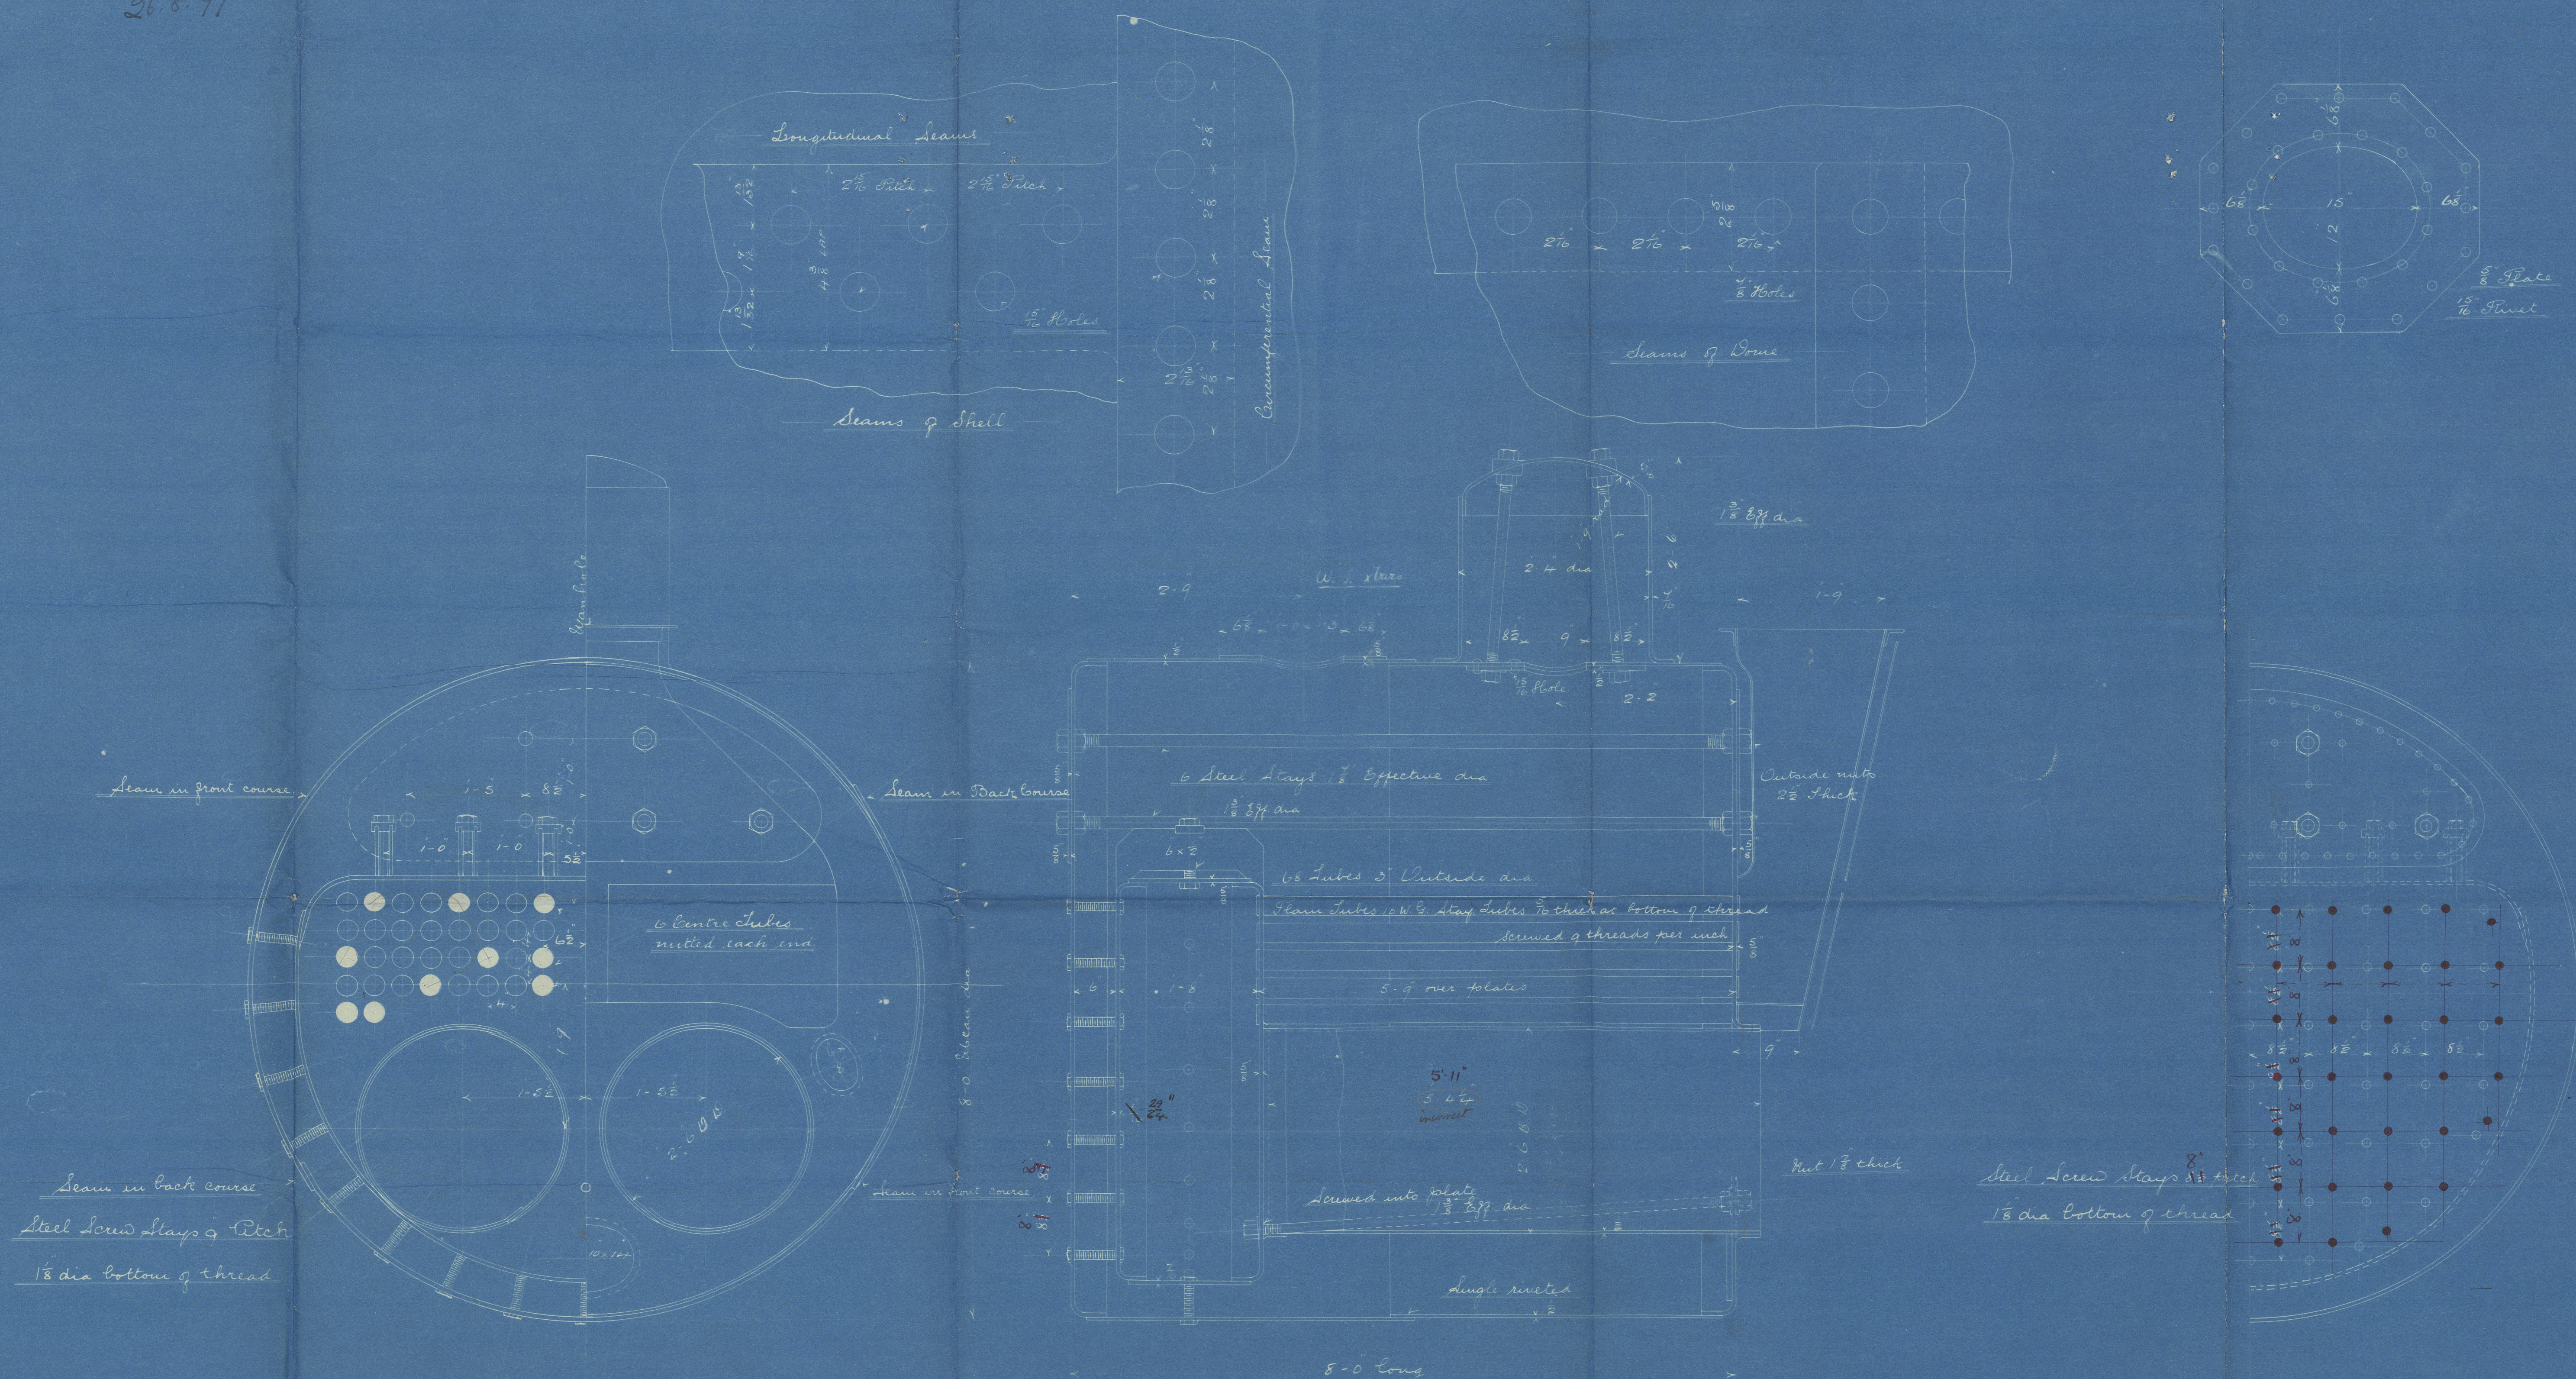

Long Seams of Shell Double Riveted 1/8 Holes 2 1/8 Pitch 4 3/8 Lap
 Circumf. Single 1/8 2 1/8 2 1/8
 Dome 1/8 2 1/8 2 1/8

Long Chime & Furnace Seams Single Riveted 1/8 Holes 2 1/8 Pitch 2 1/8 Lap

All plates Messrs John Brown & Co. Glasgow

Rivet makers Messrs James Miller & Co. Glasgow

All holes drilled

Working pressure 80 lbs per sq in

Testing 100

Scale 1-1 foot

Lloyds & Board of Trade Surveyors

Heating Surface 400 sq ft

Grate Area 23 sq ft



25m
 26/8/99
 6mbs
 25/8/99

© 2021
FOR ENCLOSURE TO

Lloyds Engineers Surveyors

FROM CLARKE, CHAPMAN & CO. LTD.,
GATESHEAD-ON-TYNE.

0161 2/2

Clarke Chapman H^o

N^o 2381c

80 lbs W.P.

GSA

1/11/99

5636

160 lbs

S/s Duke of
Norfolk

Lon. 61462



© 2021

Lloyd's Register
Foundation

LON 433 061/12