


THE ORIENT STEAM NAVIGATION COMPANY, LIMITED.

S. S. CUZCO, GARONNE & LUSITANIA.

Scale 1/2 inch to the Foot.

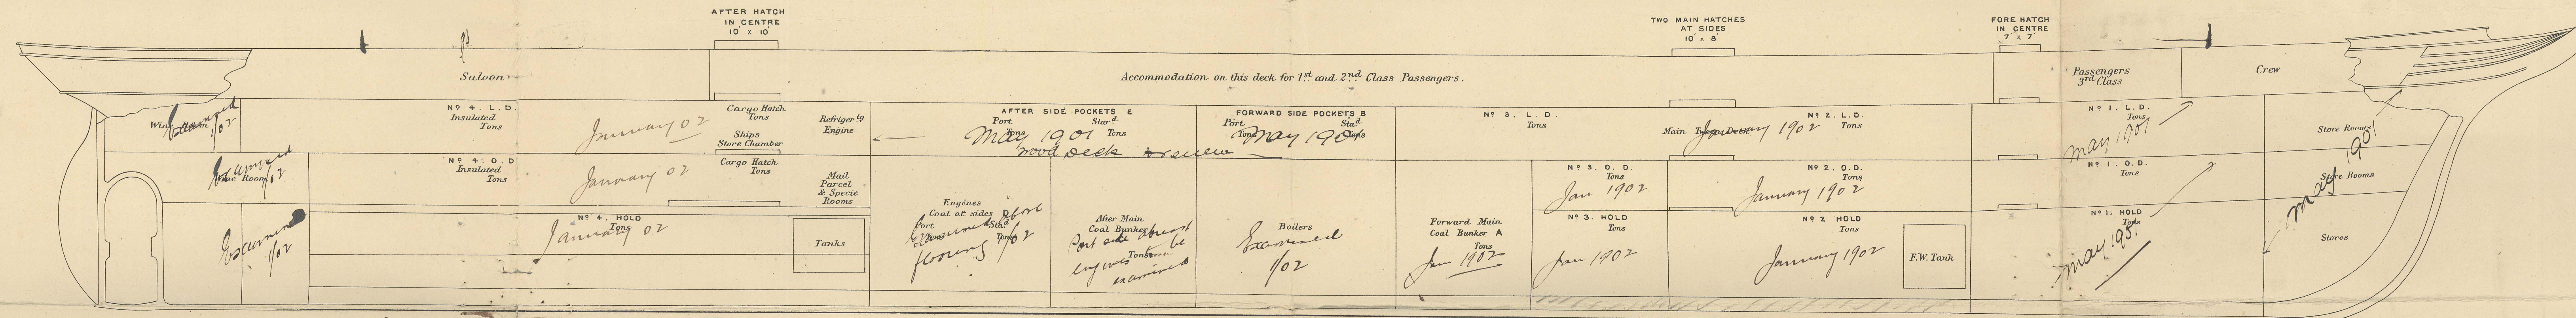

Tank under No. 3

Tanks hold water under No. 3
No. 4. 1902

CAPACITY OF CARGO HOLDS, COAL BUNKERS AND WATER BALLAST.											
CARGO HOLDS MEASURED TO HALF DEPTH OF BEAMS.						COAL BUNKERS MEASURED TO HALF DEPTH OF BEAMS 40 CUBIC FEET TO THE TON.			WATER BALLAST		
NO OF HOLDS	40 CUBIC FEET TO THE TON	NOT INSULATED		INSULATED		PERMANENT COAL BUNKERS.	CUBIC FEET	TONS		FRAMES	CUBIC FEET
		CUBIC FEET	TONS	HATCHES	CUBIC FEET TONS						TONS
I	Hold					A Forward Main Bunker			1	Tank & No. 2 Hold	
"	Orlop deck					B For. Side pockets Port			2	Tank under No. 4 Hold	
"	Lower deck					" Do. Star. d					
II	Hold					C After Main Bunker					
"	Orlop deck					D Coal at sides of Engines Port					
"	Lower deck					" Do Star. d					
III	Hold					E After Side pocket Port					
"	Orlop deck					" Do Star. d					
"	Lower deck										
IV	Hold					RESERVE COAL.					
"	Orlop deck					No. III Hold					
"	Lower deck					" Orlop Deck					

MANAGERS
F. GREEN & CO,
ANDERSON, ANDERSON & CO
Fenchurch Avenue,
LONDON, E.C.