
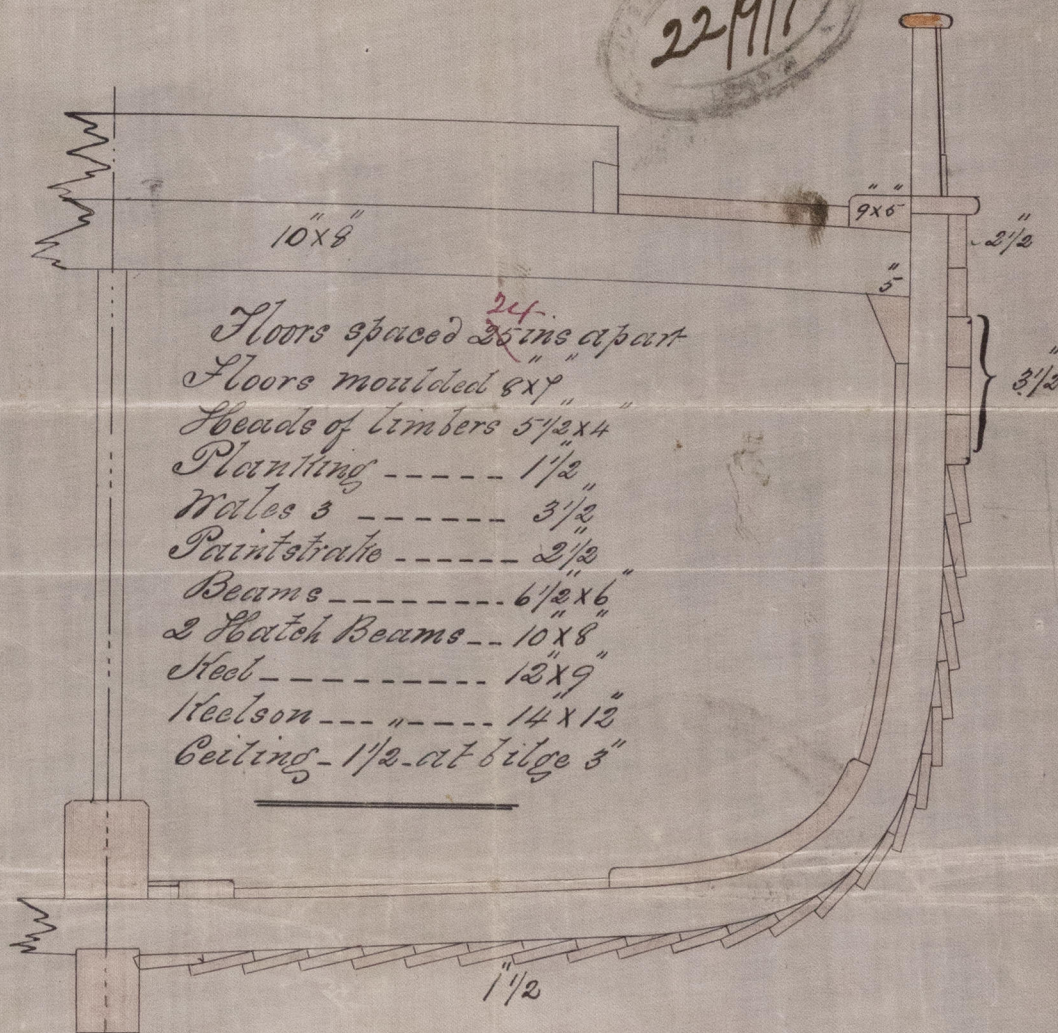


*Leith Report*  
*1041134*  
 Midships Section of Clunker Built  
 Wood Steamer. Building by  
 Messrs A. B. Hovan & Son, Birnbeck.

Length of Keel - 76 Feet  
 Breadth - 20 "  
 Depth - 9 "

Rec 20/9/73  
*HA*

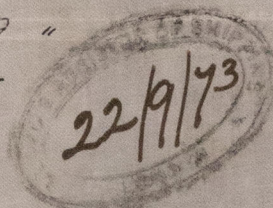

*S.M. 22/9/73*



© 2019

Lloyd's Register  
 Foundation

LTH554-0053