




© 2019

Lloyd's Register  
Foundation




REGISTERED  
-2 APR. 84  
LONDON

*Lat. to Leith*  
*3/4/84*

S S N<sup>o</sup> 84

SCALE  $\frac{1}{4}$  IN. TO 1 FOOT.

DOBBSON & CHARLES  
Ship Builders  
GRIMMOUTH

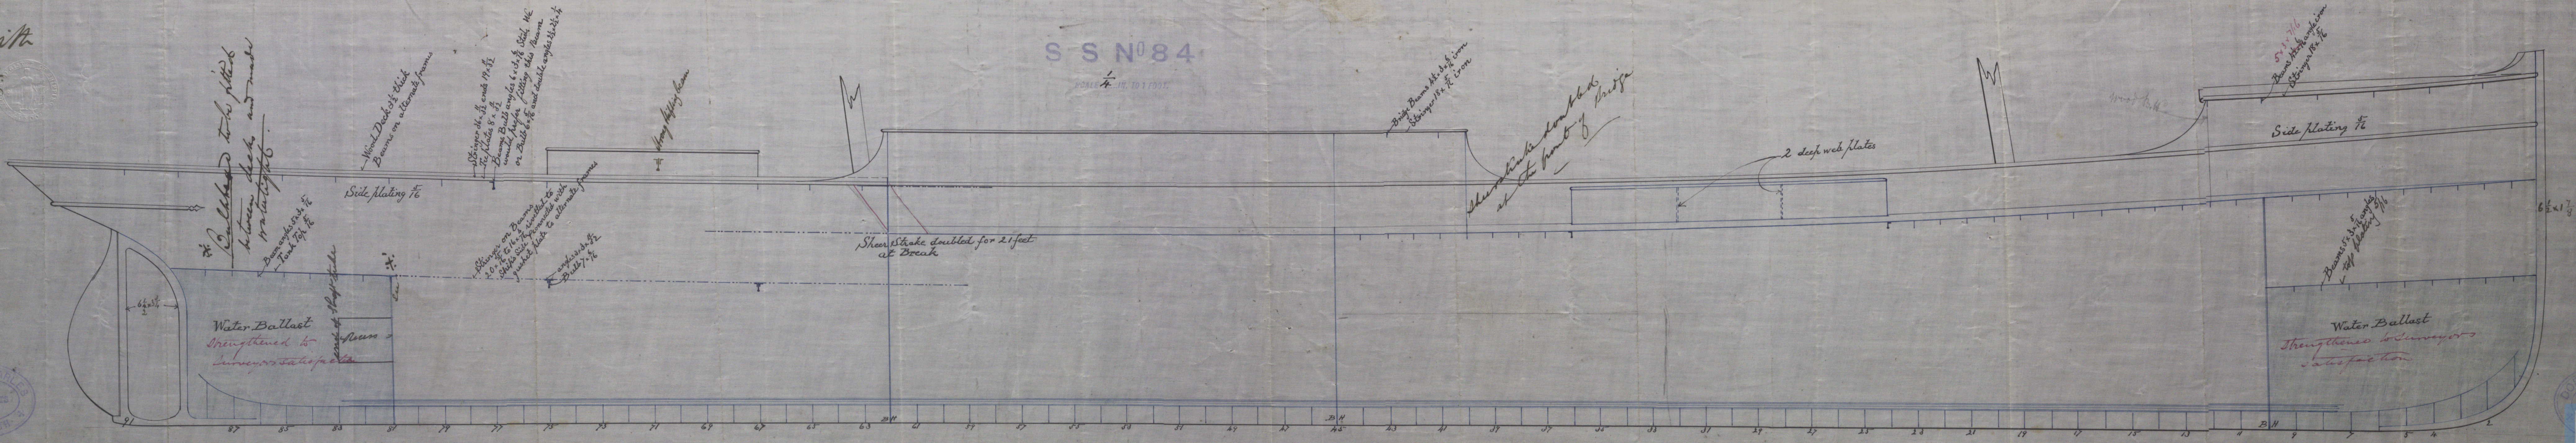

*J.H.B.*  
*2/4/84*

DOBBSON & CHARLES  
Ship Builders  
GRIMMOUTH

Lloyd's Register  
Foundation

CTH556-0253