

LTH 558-0062



LLOYD'S REGISTER,
LONDON.
REGD. OFFICE
ANSE



© 2019

Lloyd's Register
Foundation




8.2.88

S.S. "Barbaras" Lth Rept. 5715

Deck Plan of S.S. No 16, building by Mr. H. Jarvis, at Anstruther.

To Class 9 A1. "For Coasting Purposes". Scale $\frac{1}{4}$ " = 1 ft.

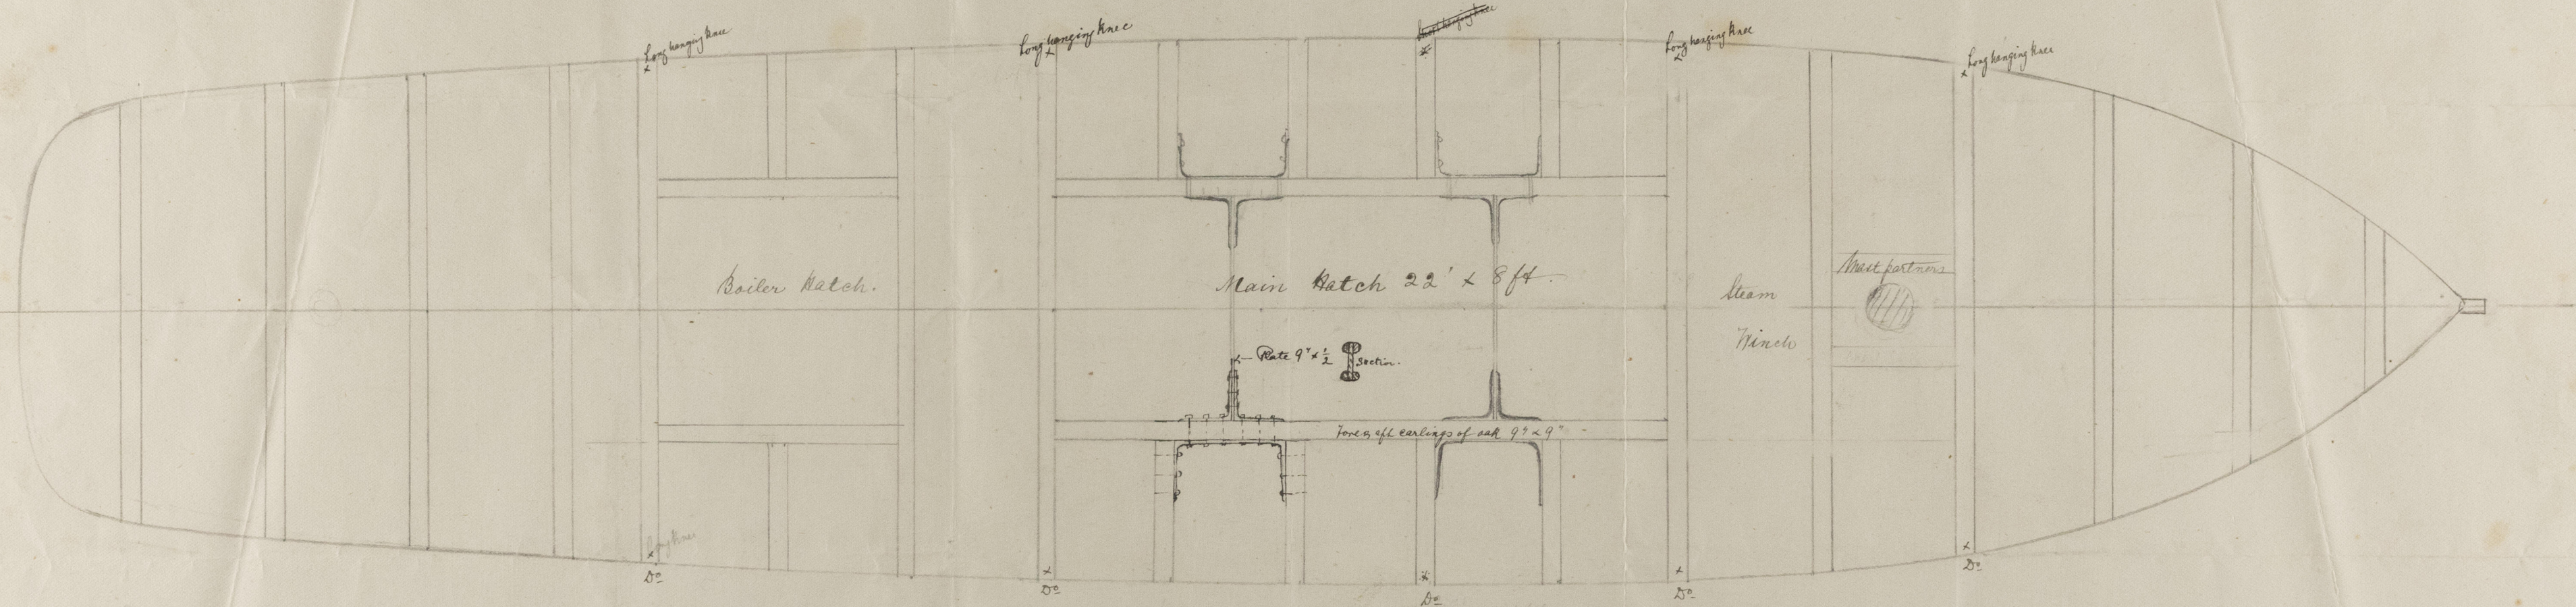

B.M. J.P.C.
8/2/88



7/2/88

© 2019

Lloyd's Register
Foundation

LTH 558-0062