



LTH 558-0063

LLOYD'S REGISTER,
LONDON.

REC'D 12.88

AN82

[Faint, illegible handwritten text]

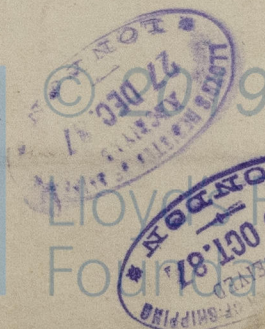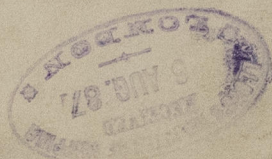

Lloyd's Register
Foundation

s.s. "Barbara" Lth. Rept. 5715

Steamer Length 86 feet x 19 ft 6 in moulded x 9 ft 4 in of ceiling to top of beam
To Class 9A. at Lloyds "for boasting purposes."

To be built under Special Survey by Mr. Wm Jarvis, No 16
Scale $\frac{1}{2}$ ⁱⁿ to a foot Anstruther


Scale $\frac{1}{2}$ ⁱⁿ to a foot

9.8.87.

31.10.82

28.12.84

f. 2. 88

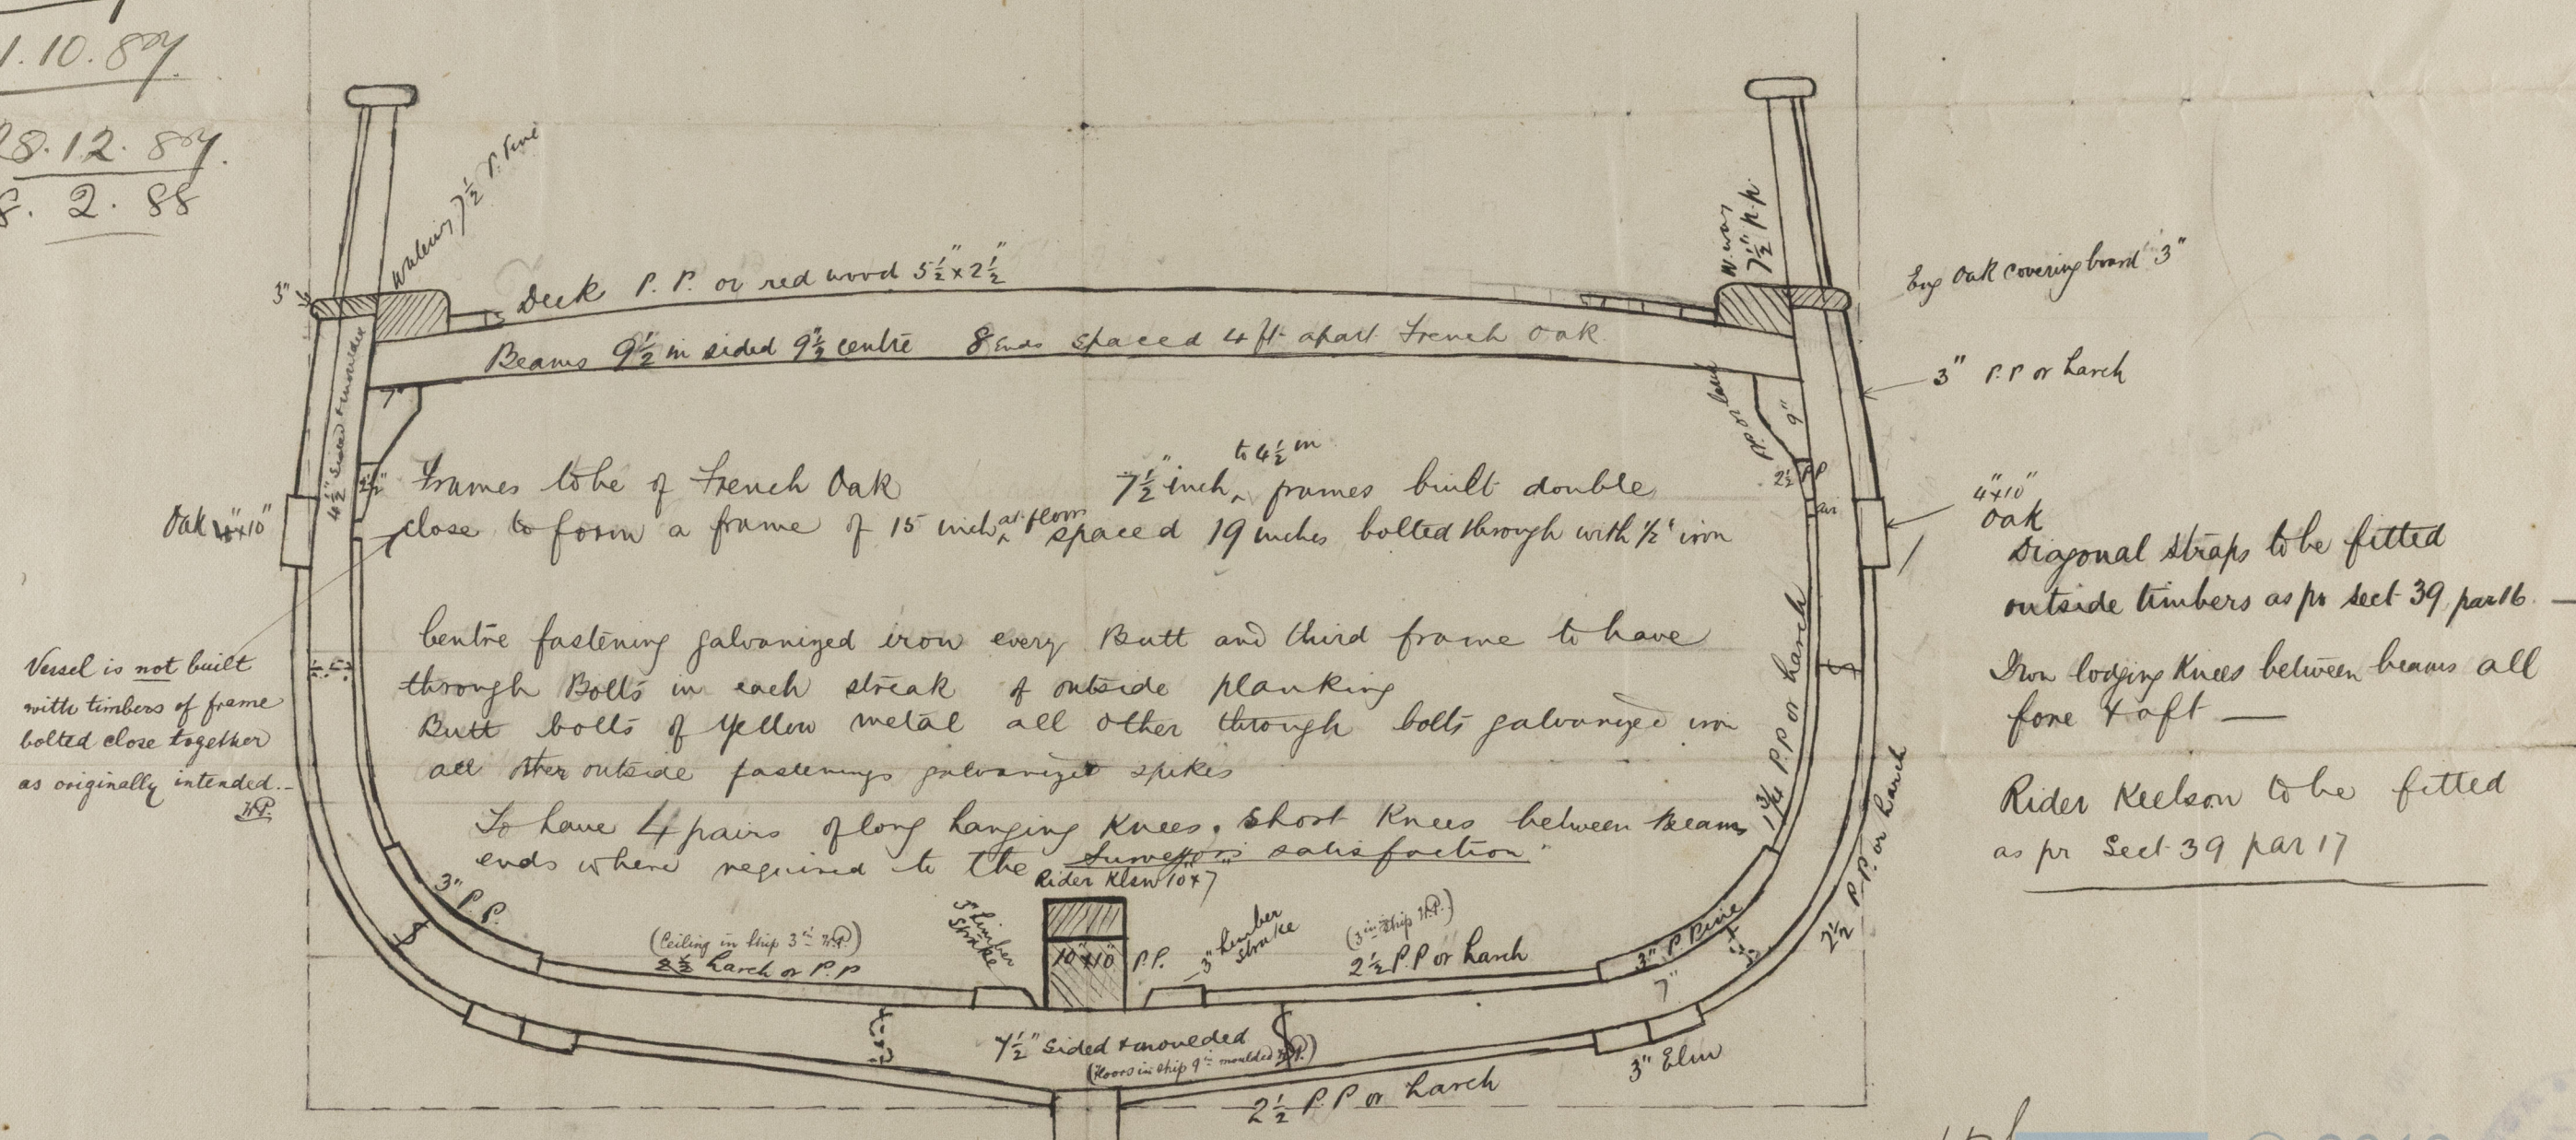

" Rieder Kulsen Am Elm ^{Fluss 9x9"}

2¹/₇ 31/10/87

18 Mr

872/88

107/1
9/8/87

© 2019

Lloyd's Register
Foundation