



Str. L. Leith

4/12/84.

S.S. "Emerald"

Lth. rep. 5234


5841

Lew. "Pioneer" Leith Report to 5060  
 " " " " " 5769  
 " " " " " 5234

LTHS58-0229


Mess Brothers S.S. No 17. Proposed class 9A - for Fishing purposes  
 No: 18 [vide Lth. Ltr. 24.2.85]  
 " No: 19 " No: 20  
 Length between perpendiculars 70  
 Breadth moulded 16'9"  
 Depth moulded 8'4"

(No: 20) S.S. "Emerald" Lth. Report No 5234.  
 (No: 19) S.S. "British Prince" Lth. Report No 5169.  
 (No: 17) S.S. "Alice" Lth. Report No 4989.  
 (No: 18) S.S. "Pioneer" Lth. Report No 5060.  
 (No: 25) S.S. "Emerald" Lth. Report No 5841.

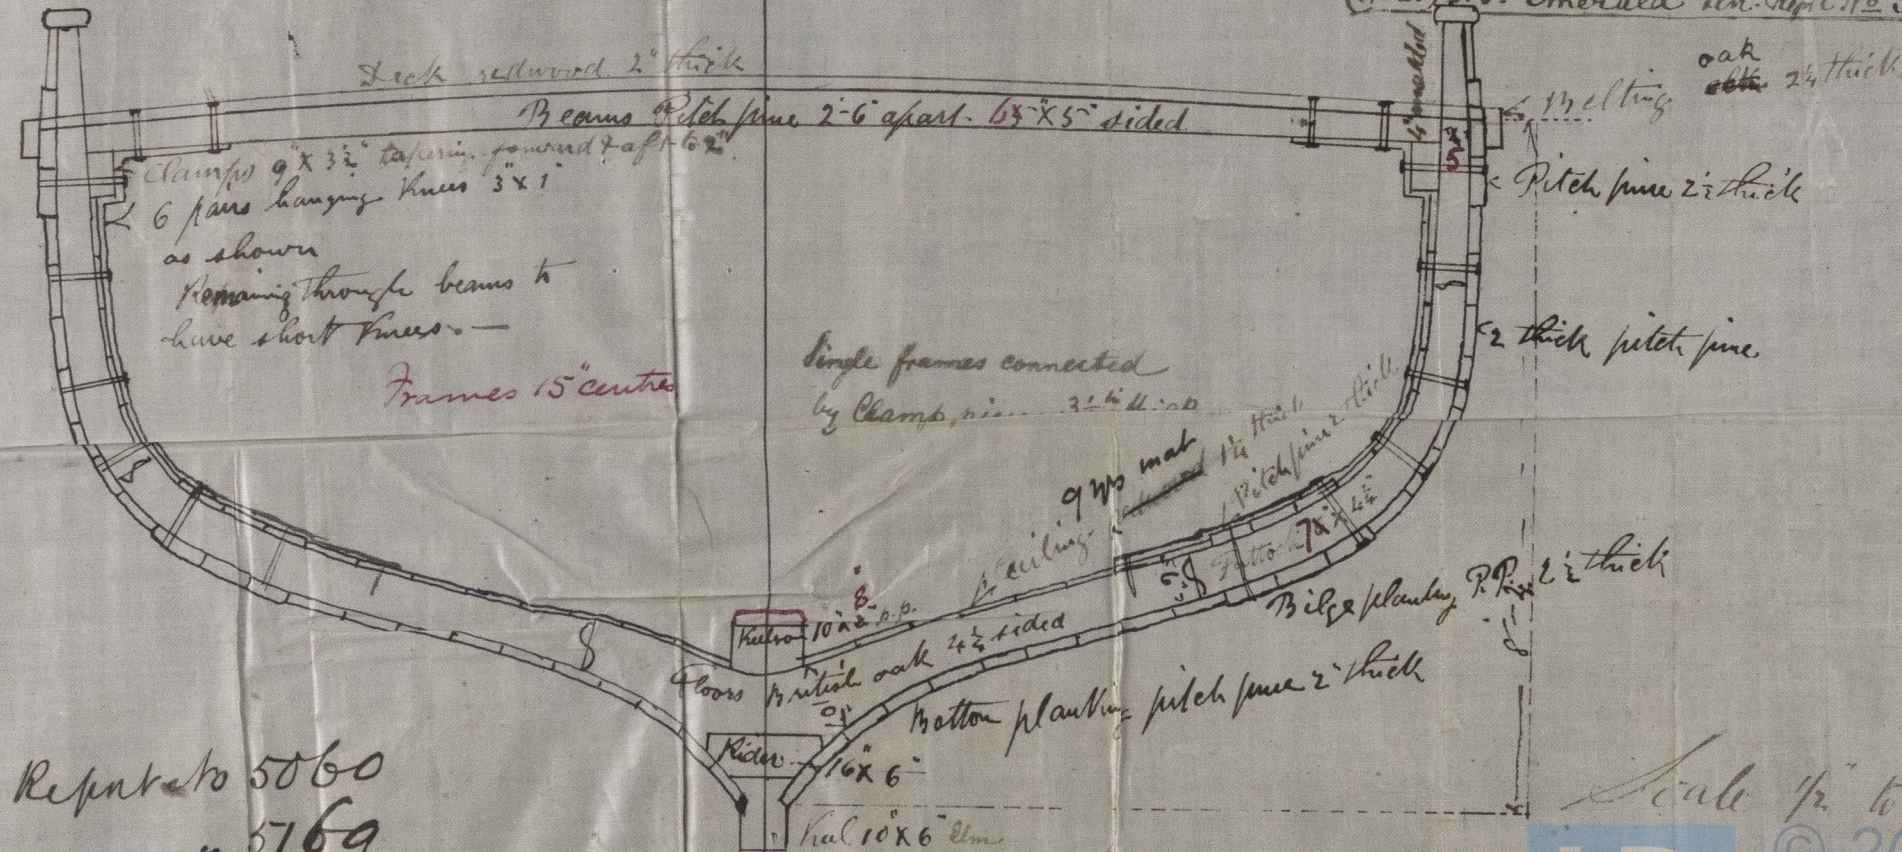

All fastenings galvanized - 1 through bolt in every butt & every third timber throughout.  
~~There is to be~~ all the remaining fastenings spikes.

Scale 1/2" to ft.

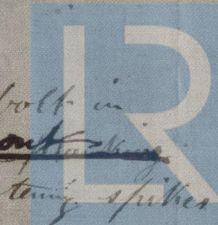

© 2019

Lloyd's Register Foundation

4/12/84