

Pivots to be steel  
Stem & Stem Post Iron  
Decks, bulkheads tanks, & bunkers Iron  
Pillars, Casings, Beamings & rail stanchions Iron.

MIDSHIP SECTION

Steel & Iron S.S. N<sup>o</sup> 55

Length 160' x 25' x 12.5'

$$\text{Breadth} \times 6.4 = \text{Length}$$
$$\text{Depth} \times 12.8 = "$$

CLASS 100A1


SCALE  $\frac{1}{2}" = 1 \text{ FOOT}$ .

December 29<sup>th</sup> = 1888.

S. S. "Mabel" Lm. Rept. No.

EQUIPMENT № 7856

|     |               |                            |             |   |
|-----|---------------|----------------------------|-------------|---|
| 3   | Bower anchors | Collecting weight ex stock | 23 1/2 cwt. | ✓ |
| 1   | Shear         | 2 1/2 cwt                  | ✓           |   |
| 1   | Redge         | 1 1/4 "                    | ✓           |   |
| 165 | Fathoms       | 1 1/16 stud chain cable    | ✓           |   |
| 60  | "             | 1 1/16 shear " "           | ✓           |   |
| 75  | "             | 7 1/2 hemp towline         | ✓           |   |
| 90  | "             | 5 1/2 " warp.              | ✓           |   |

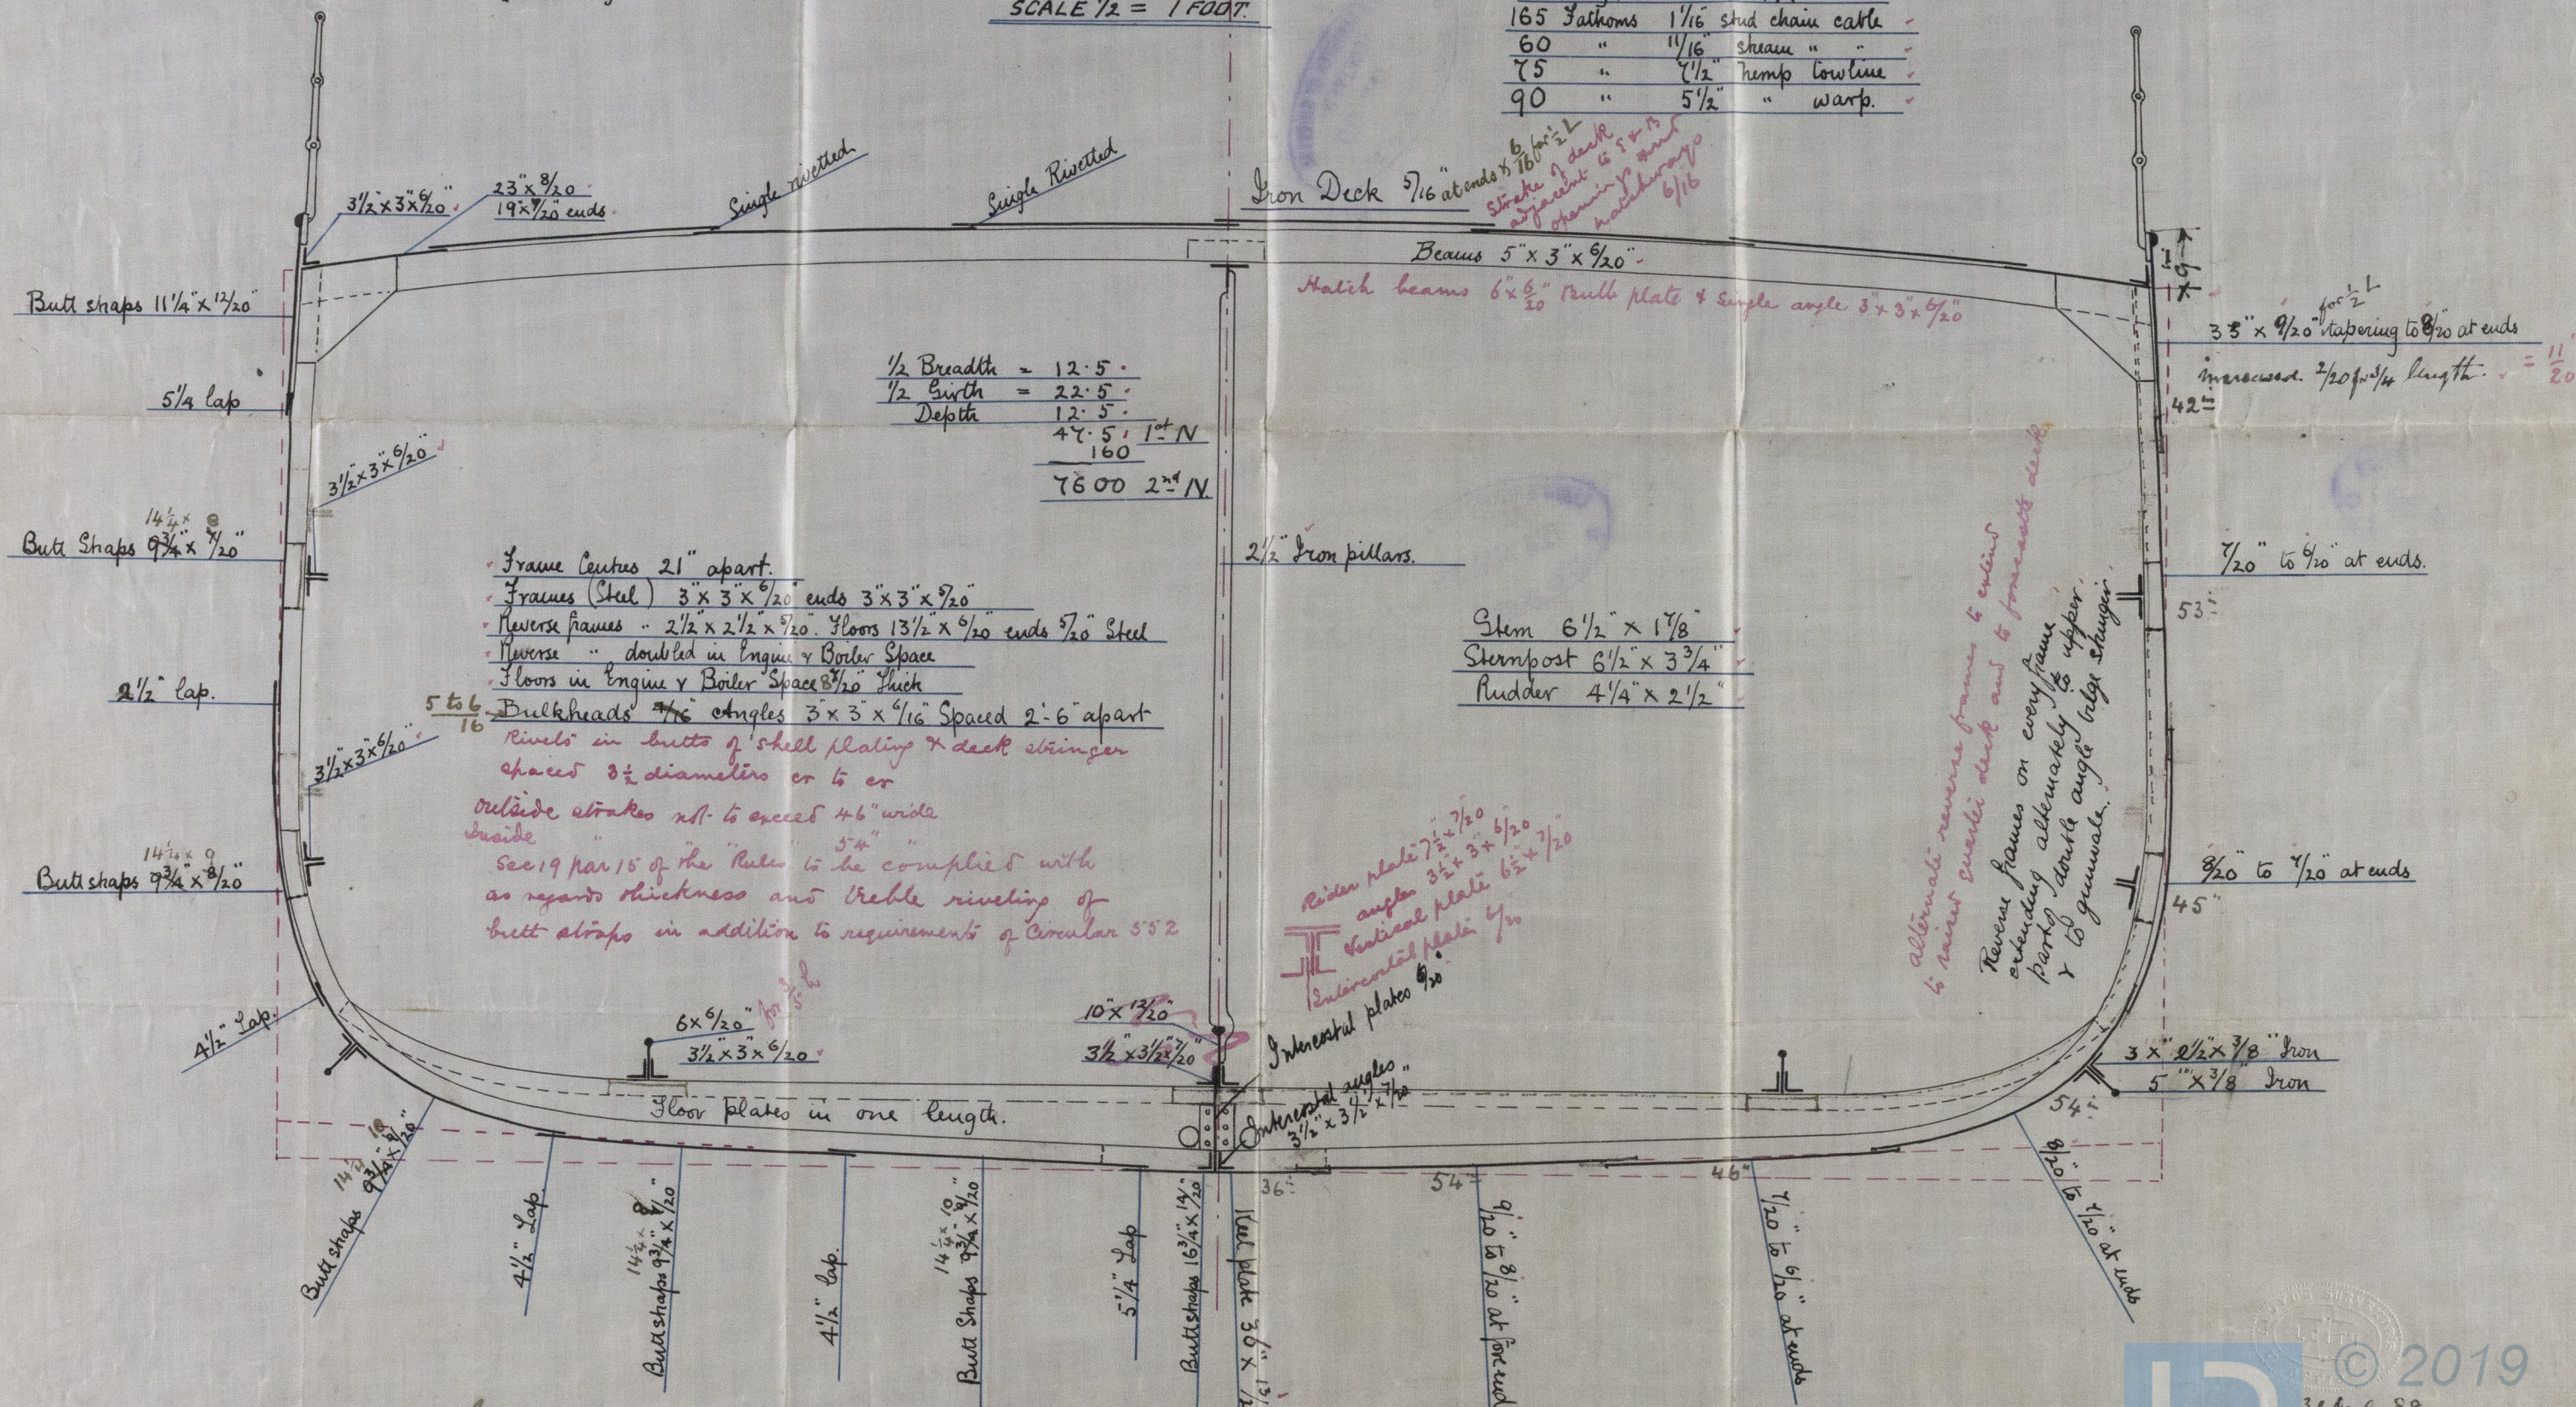

Alterations in ship from approved M. section: - All shell plating, except sheerstrake, is treble riveted at butto with  $\frac{1}{2}L$  thick straps in view of the breadth of plates as marked on section; the dk plating for  $\frac{1}{2}L$  is  $\frac{6}{16}$  & increased at hatchways; L & B. Room Bulkheads are  $\frac{5}{16}$  & end bulkheads  $\frac{7}{16}$ ; Room and L & B. are  $\frac{8}{20}$  ...  $\frac{11}{16}$  ...  
1 Bilge strake has  $\frac{3}{20}$  thick straps. -






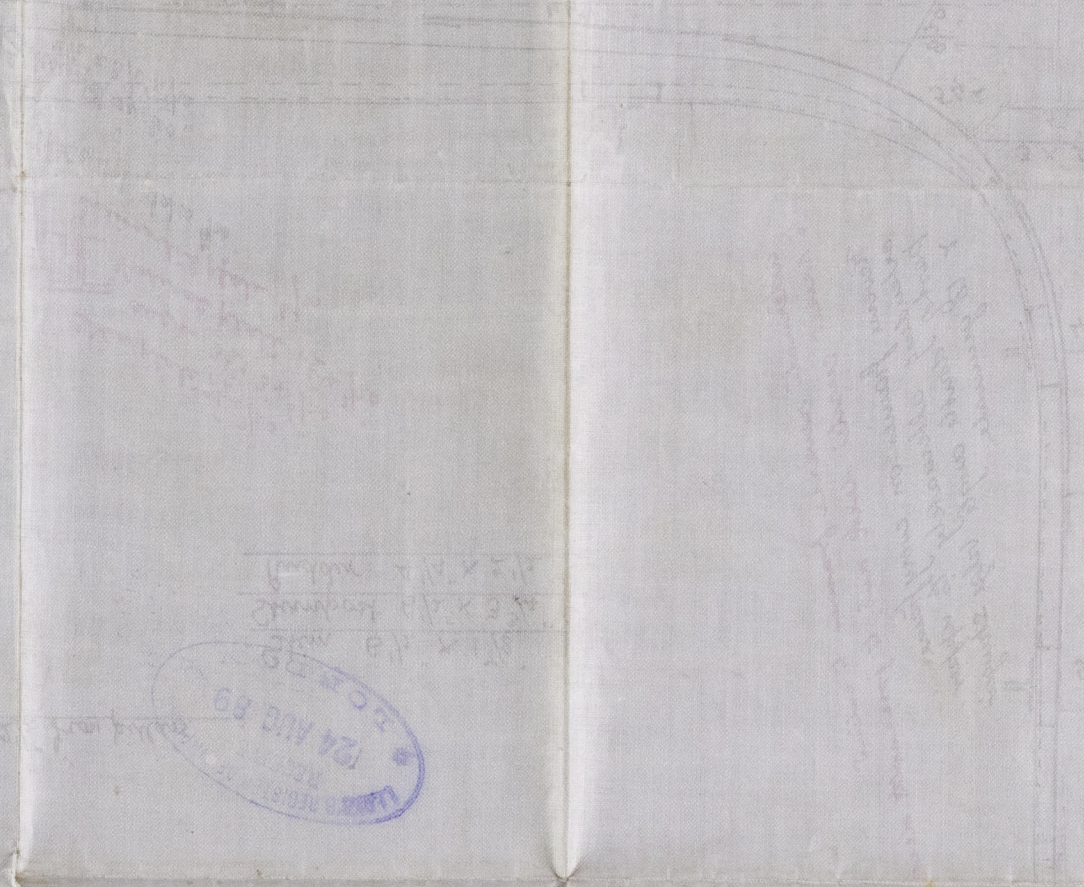





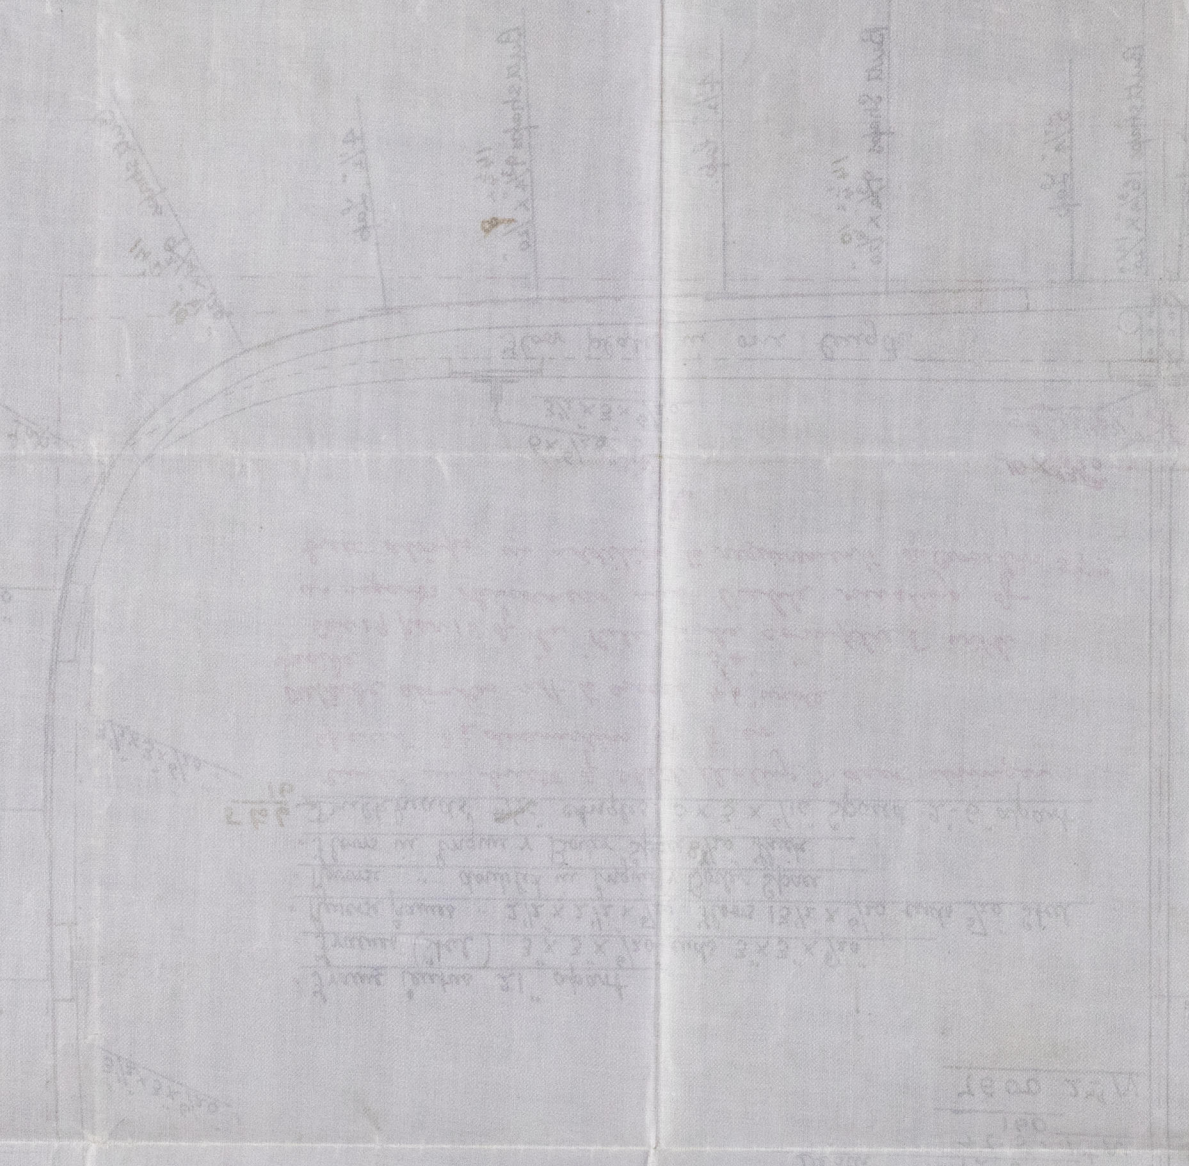




