

Lloyd's Register of British and Foreign Shipping.

(Received in the London Office, .)

P.

No. ²⁹ ~~127~~/A

REPORT ON SHIP FORGINGS.

Sir,

I beg leave to report that the undermentioned Forgings, manufactured by *Messrs John Spencer & Sons Ltd of Newcastle* for the Vessel No. 55, being built by *Messrs J. H. Morton & Co* of *Leith* have been inspected by ^{Mr. Cameron and} me in course of being forged and smithed, and found to be, so far as can be seen, *Sound*

Mark on Forging.

Lloyd's

No. 127/A

JC

The Secretary,
London.



I am, Sir,

Your Obedient Servant,

John B Craig Newcastle

	STERN FRAMES.	RUDDER FRAMES.	STEMS.
Material* - - - -	<i>Forged Scrap Iron</i>	<i>Scrap Iron</i>	
How made - - - -	<i>Forged</i>	<i>Forged</i>	
Dimensions - - - -	<i>6 1/2 - 3 3/4</i>	<i>4 1/4 - 2 3/4</i>	<i>Not seen</i>
Progress on Inspection -	<i>Forged & Smithed</i>	<i>Forged & smithed</i>	
Dates when Inspected -	<i>March 13-16-21-25-29</i> <i>April 4-8</i>	<i>July 13-16-19/89</i>	

SKETCHES OF FRAMES SHEWING POSITION AND DESCRIPTION OF WELDS.

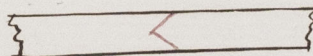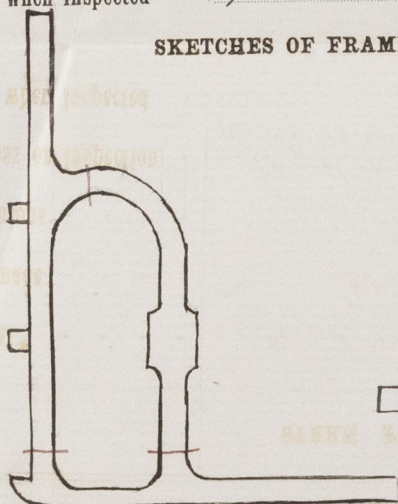

* If of iron, state whether scrap or puddled iron.