






THU 3 JAN 89

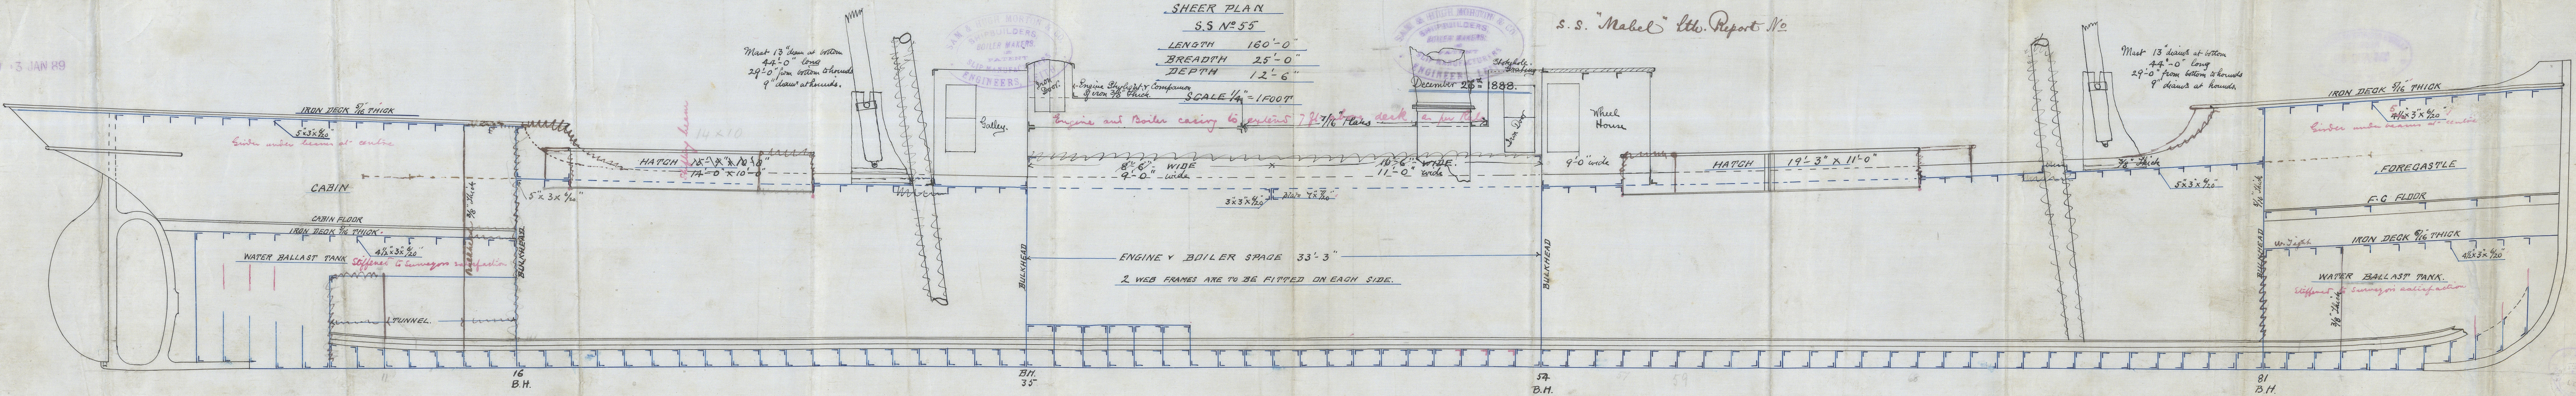

SHEER PLAN
S.S. N° 55
LENGTH 160'-0"
BREADTH 25'-0"
DEPTH 12'-6"
SCALE 1/4" = 1 FOOT

S.S. "Mabel" Lth. Report No.

December 28th 1888.

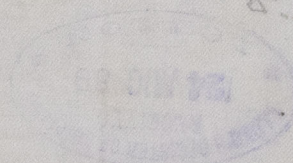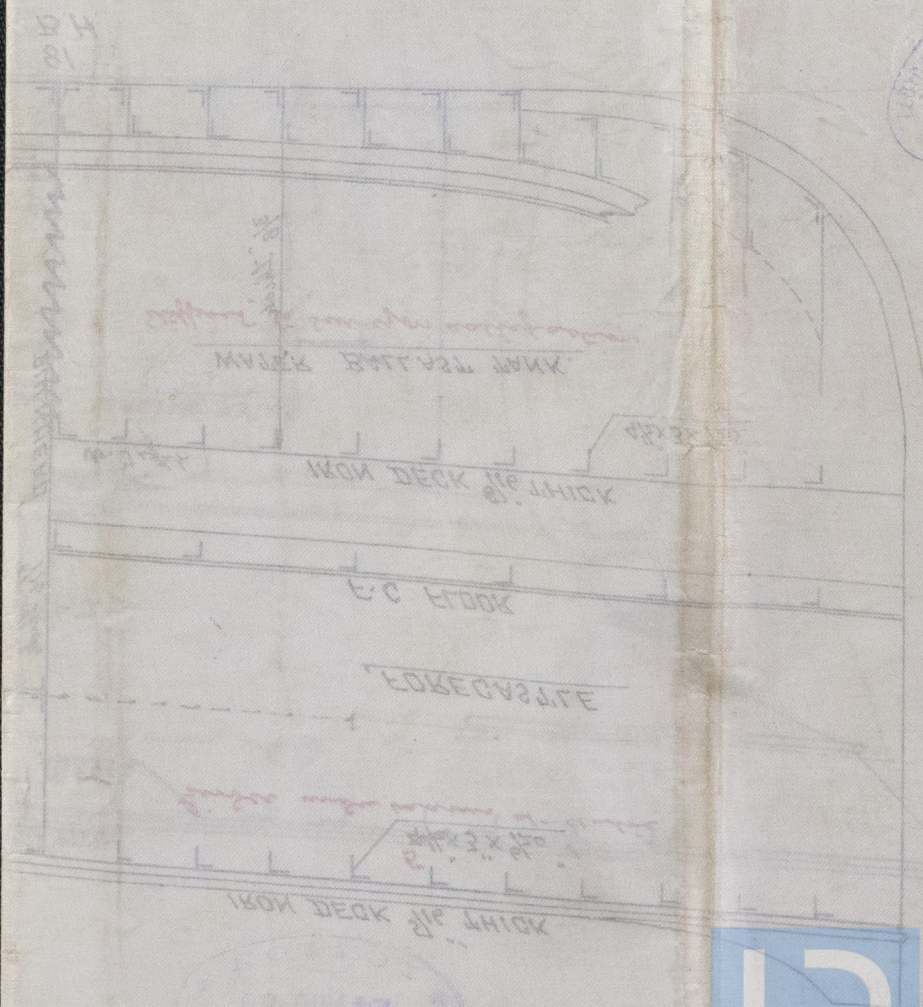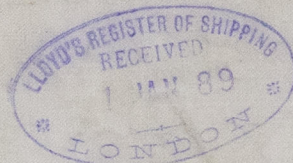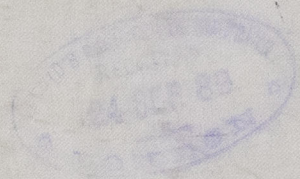

© 2021
Lloyd's Register
Foundation

71700-155117