



RECEIVED
5 FEB. 89
LLOYD'S REGISTER OF SHIPPING

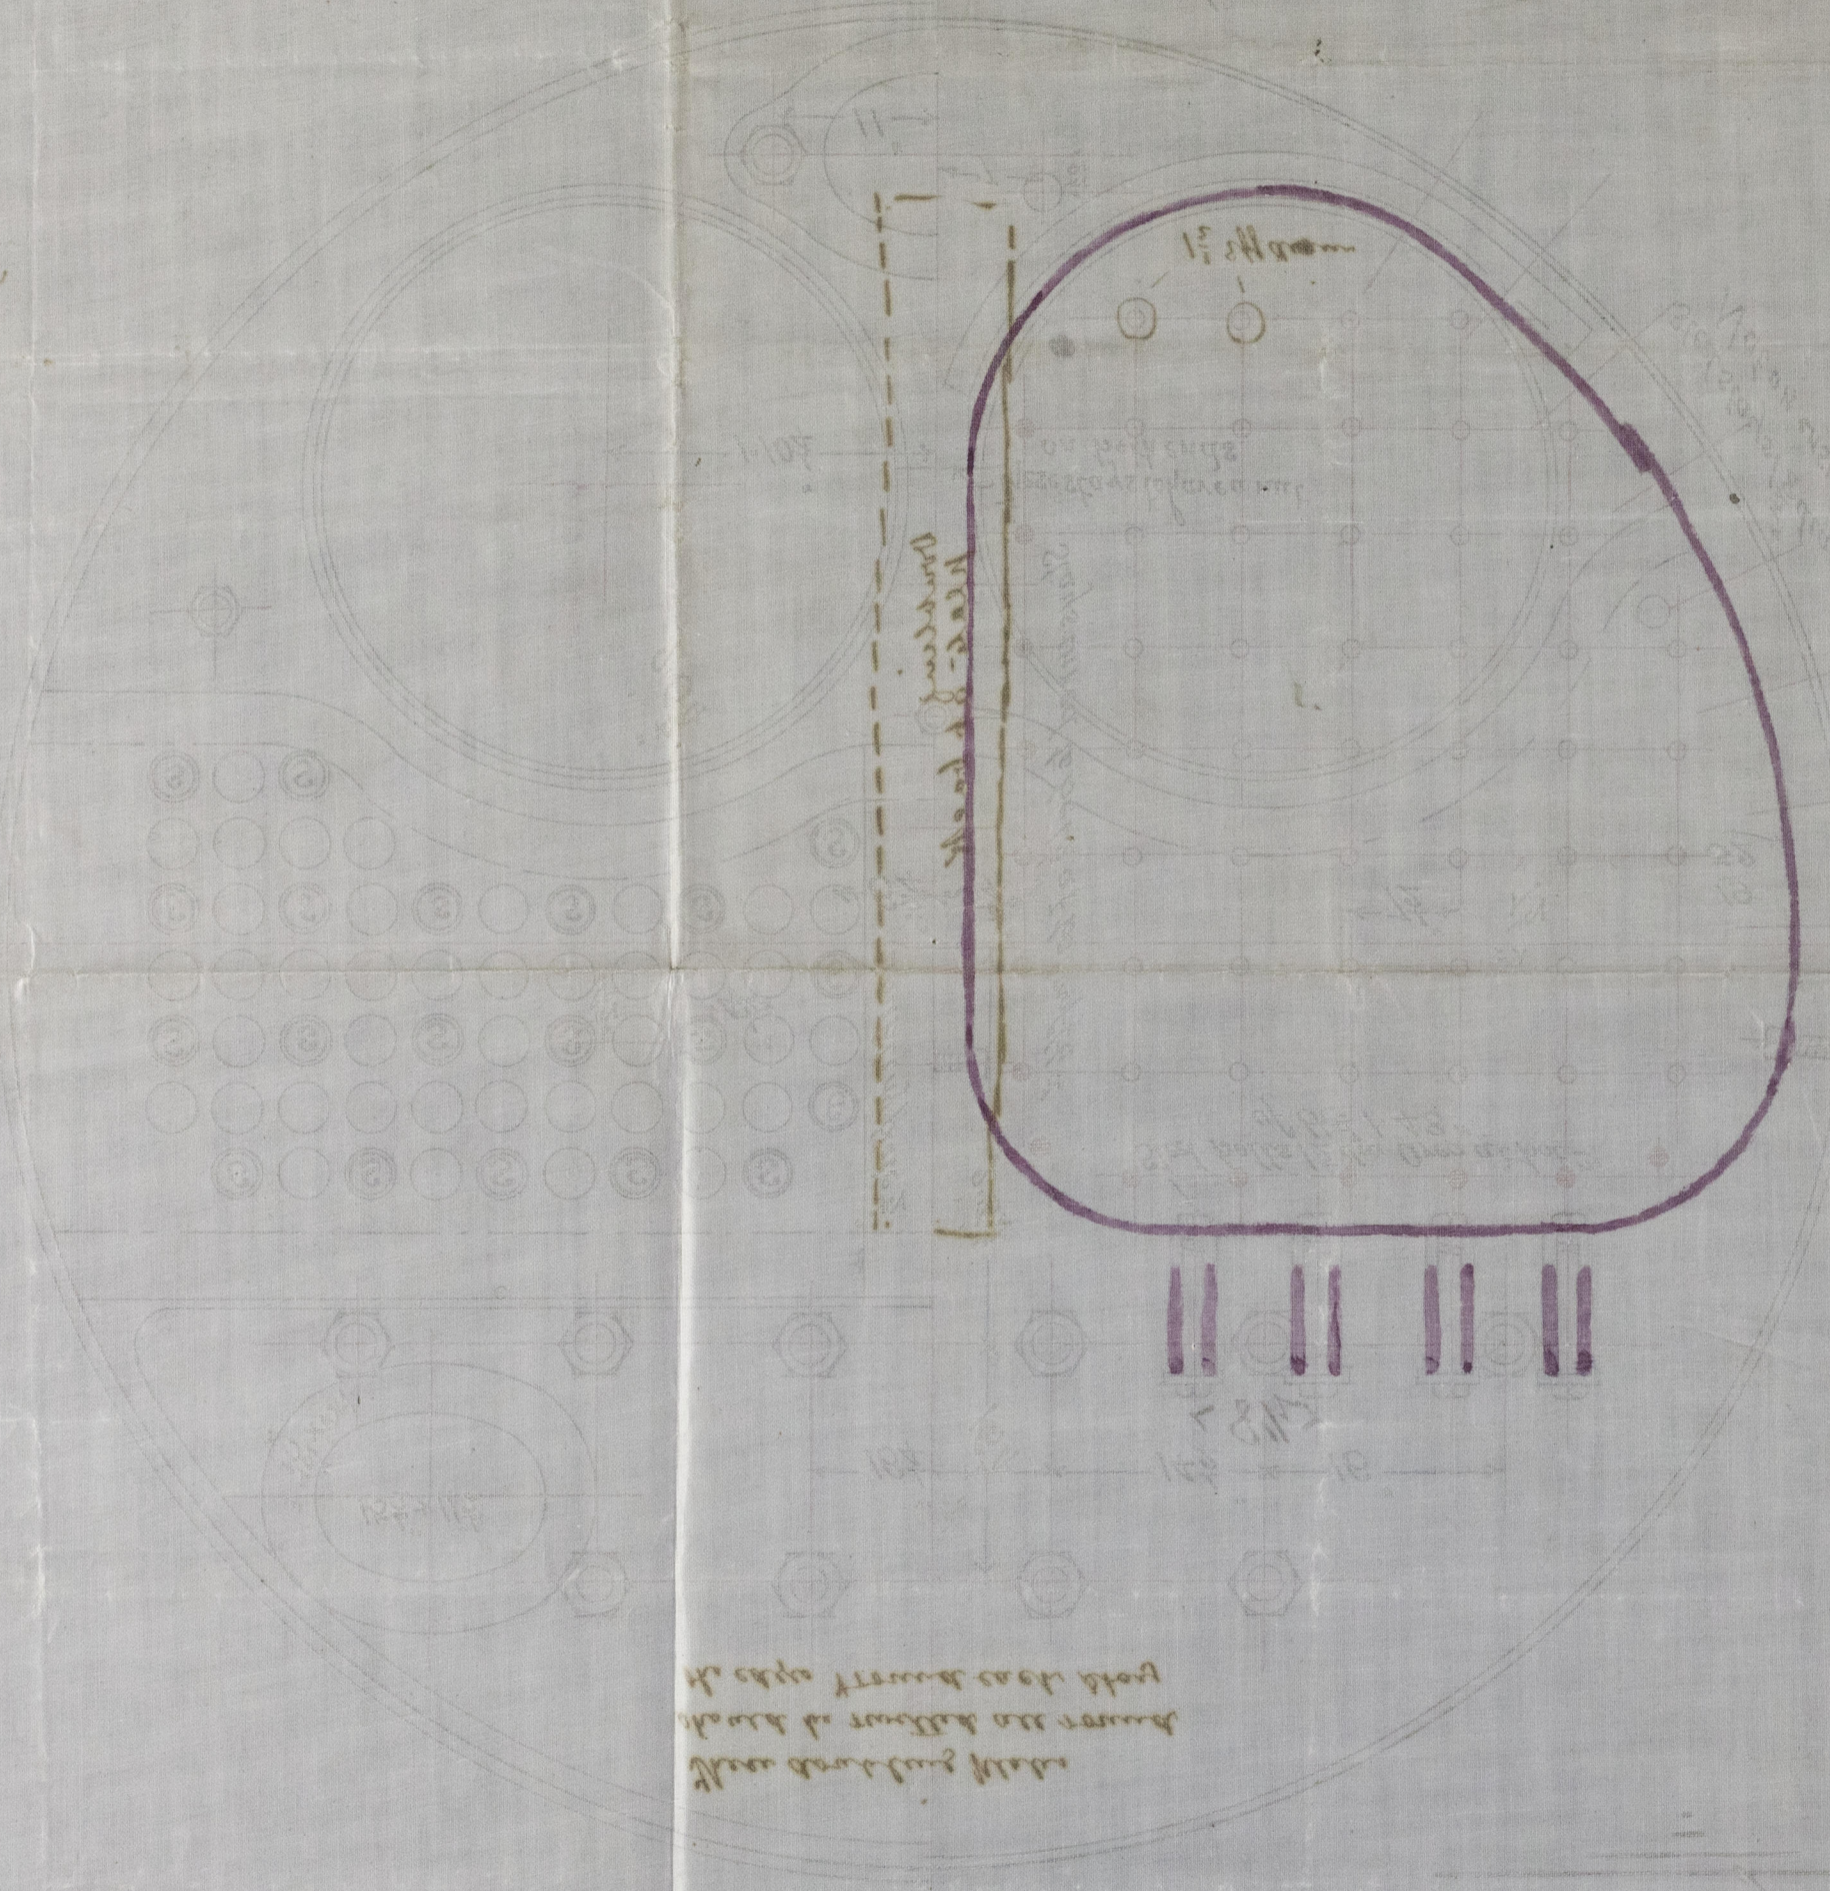


Boiler

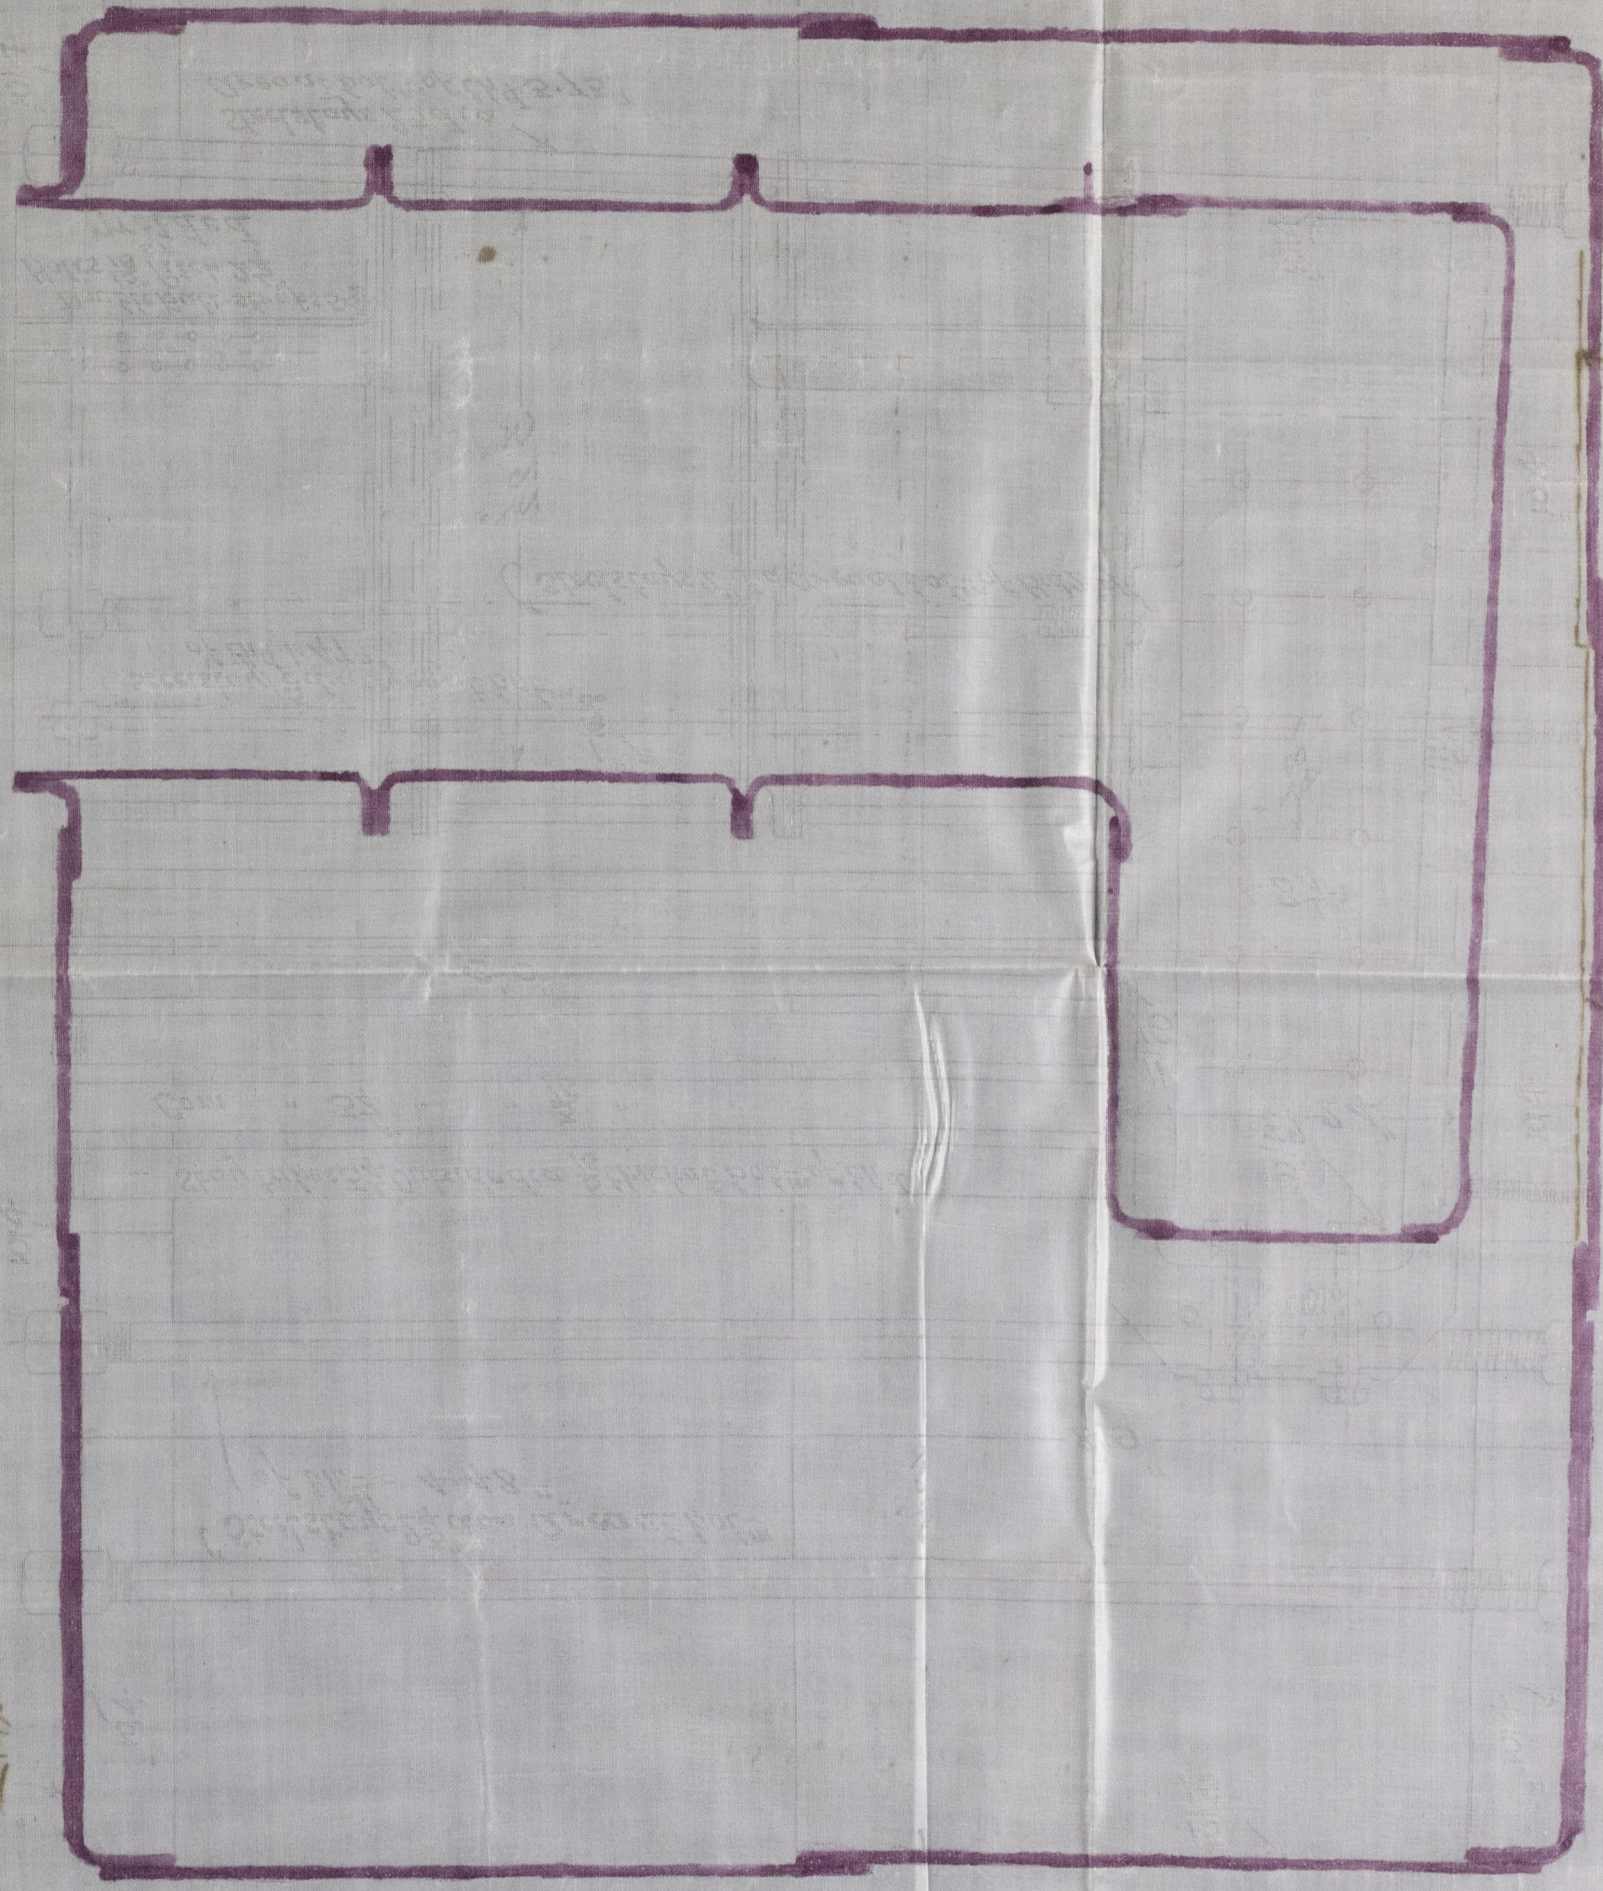


Boiler

Boiler
— *for* —
N^o 66
— *Working Pressure 150 lbs per sq* —
— *Scale 1" = 1 foot* —

S. S. "Scottish Queen"
Leith Report No 6012

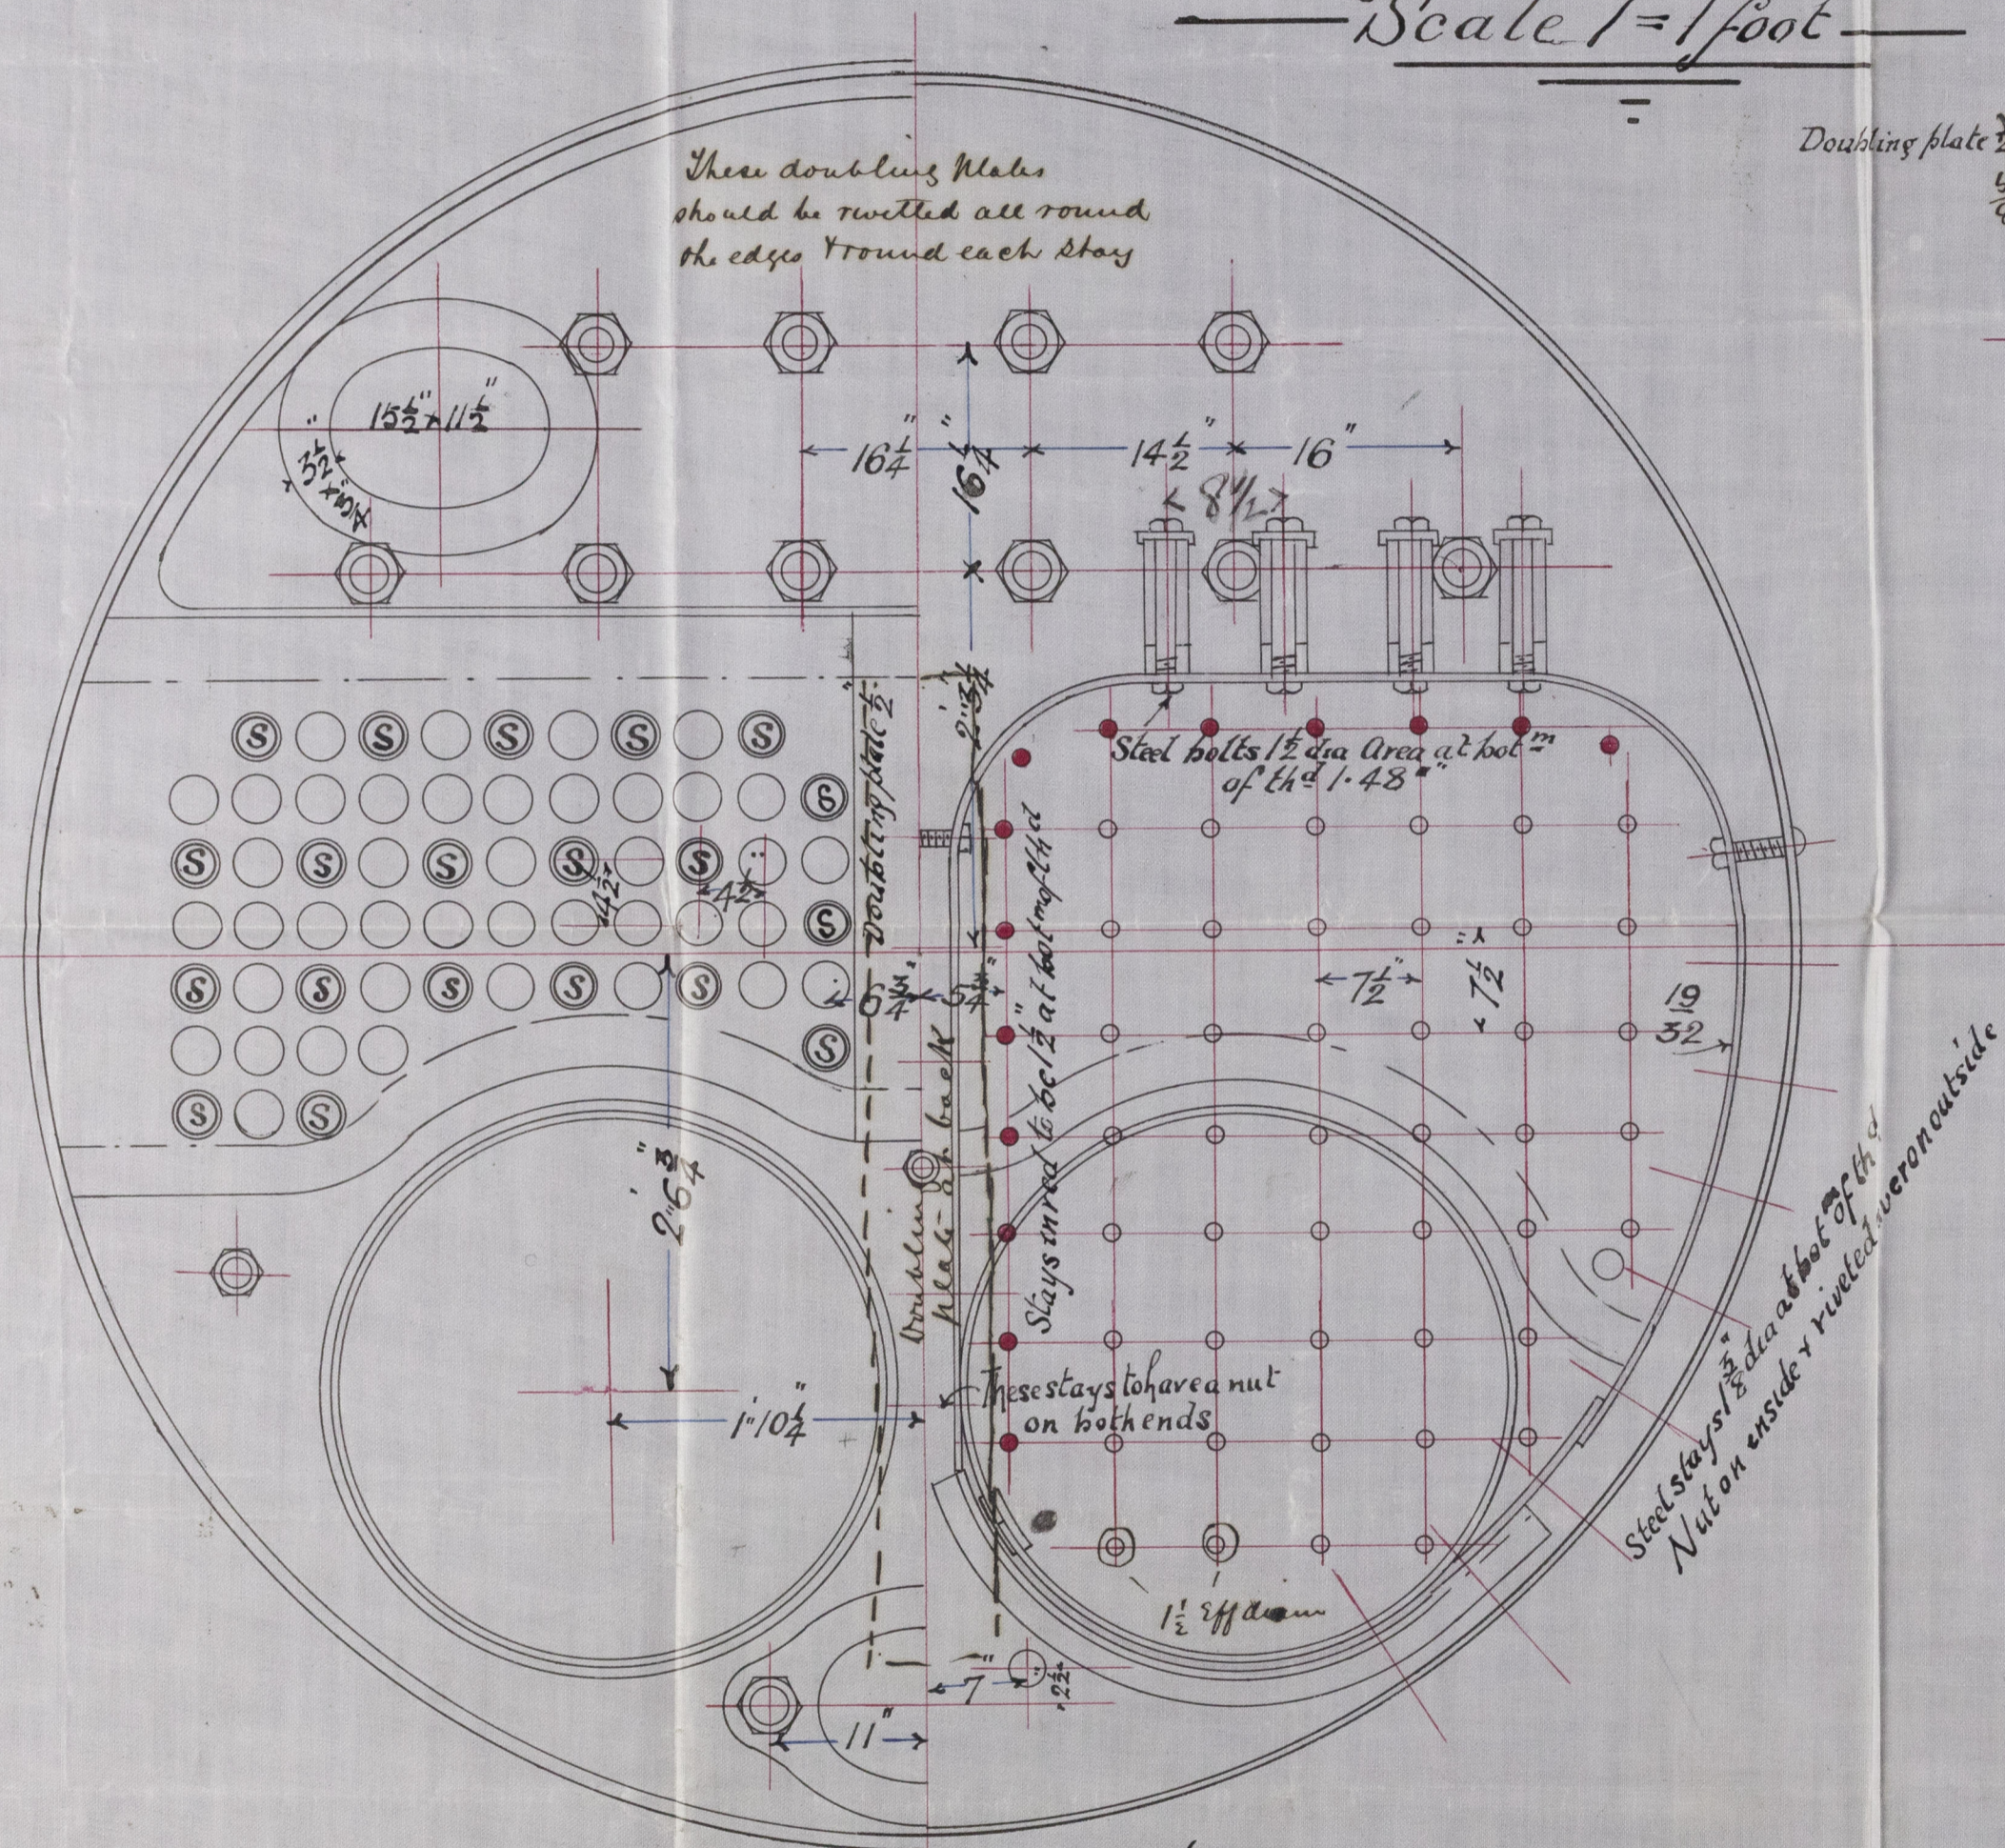

Steel to be manufact^d by Mess^{rs} D Colviler Sons

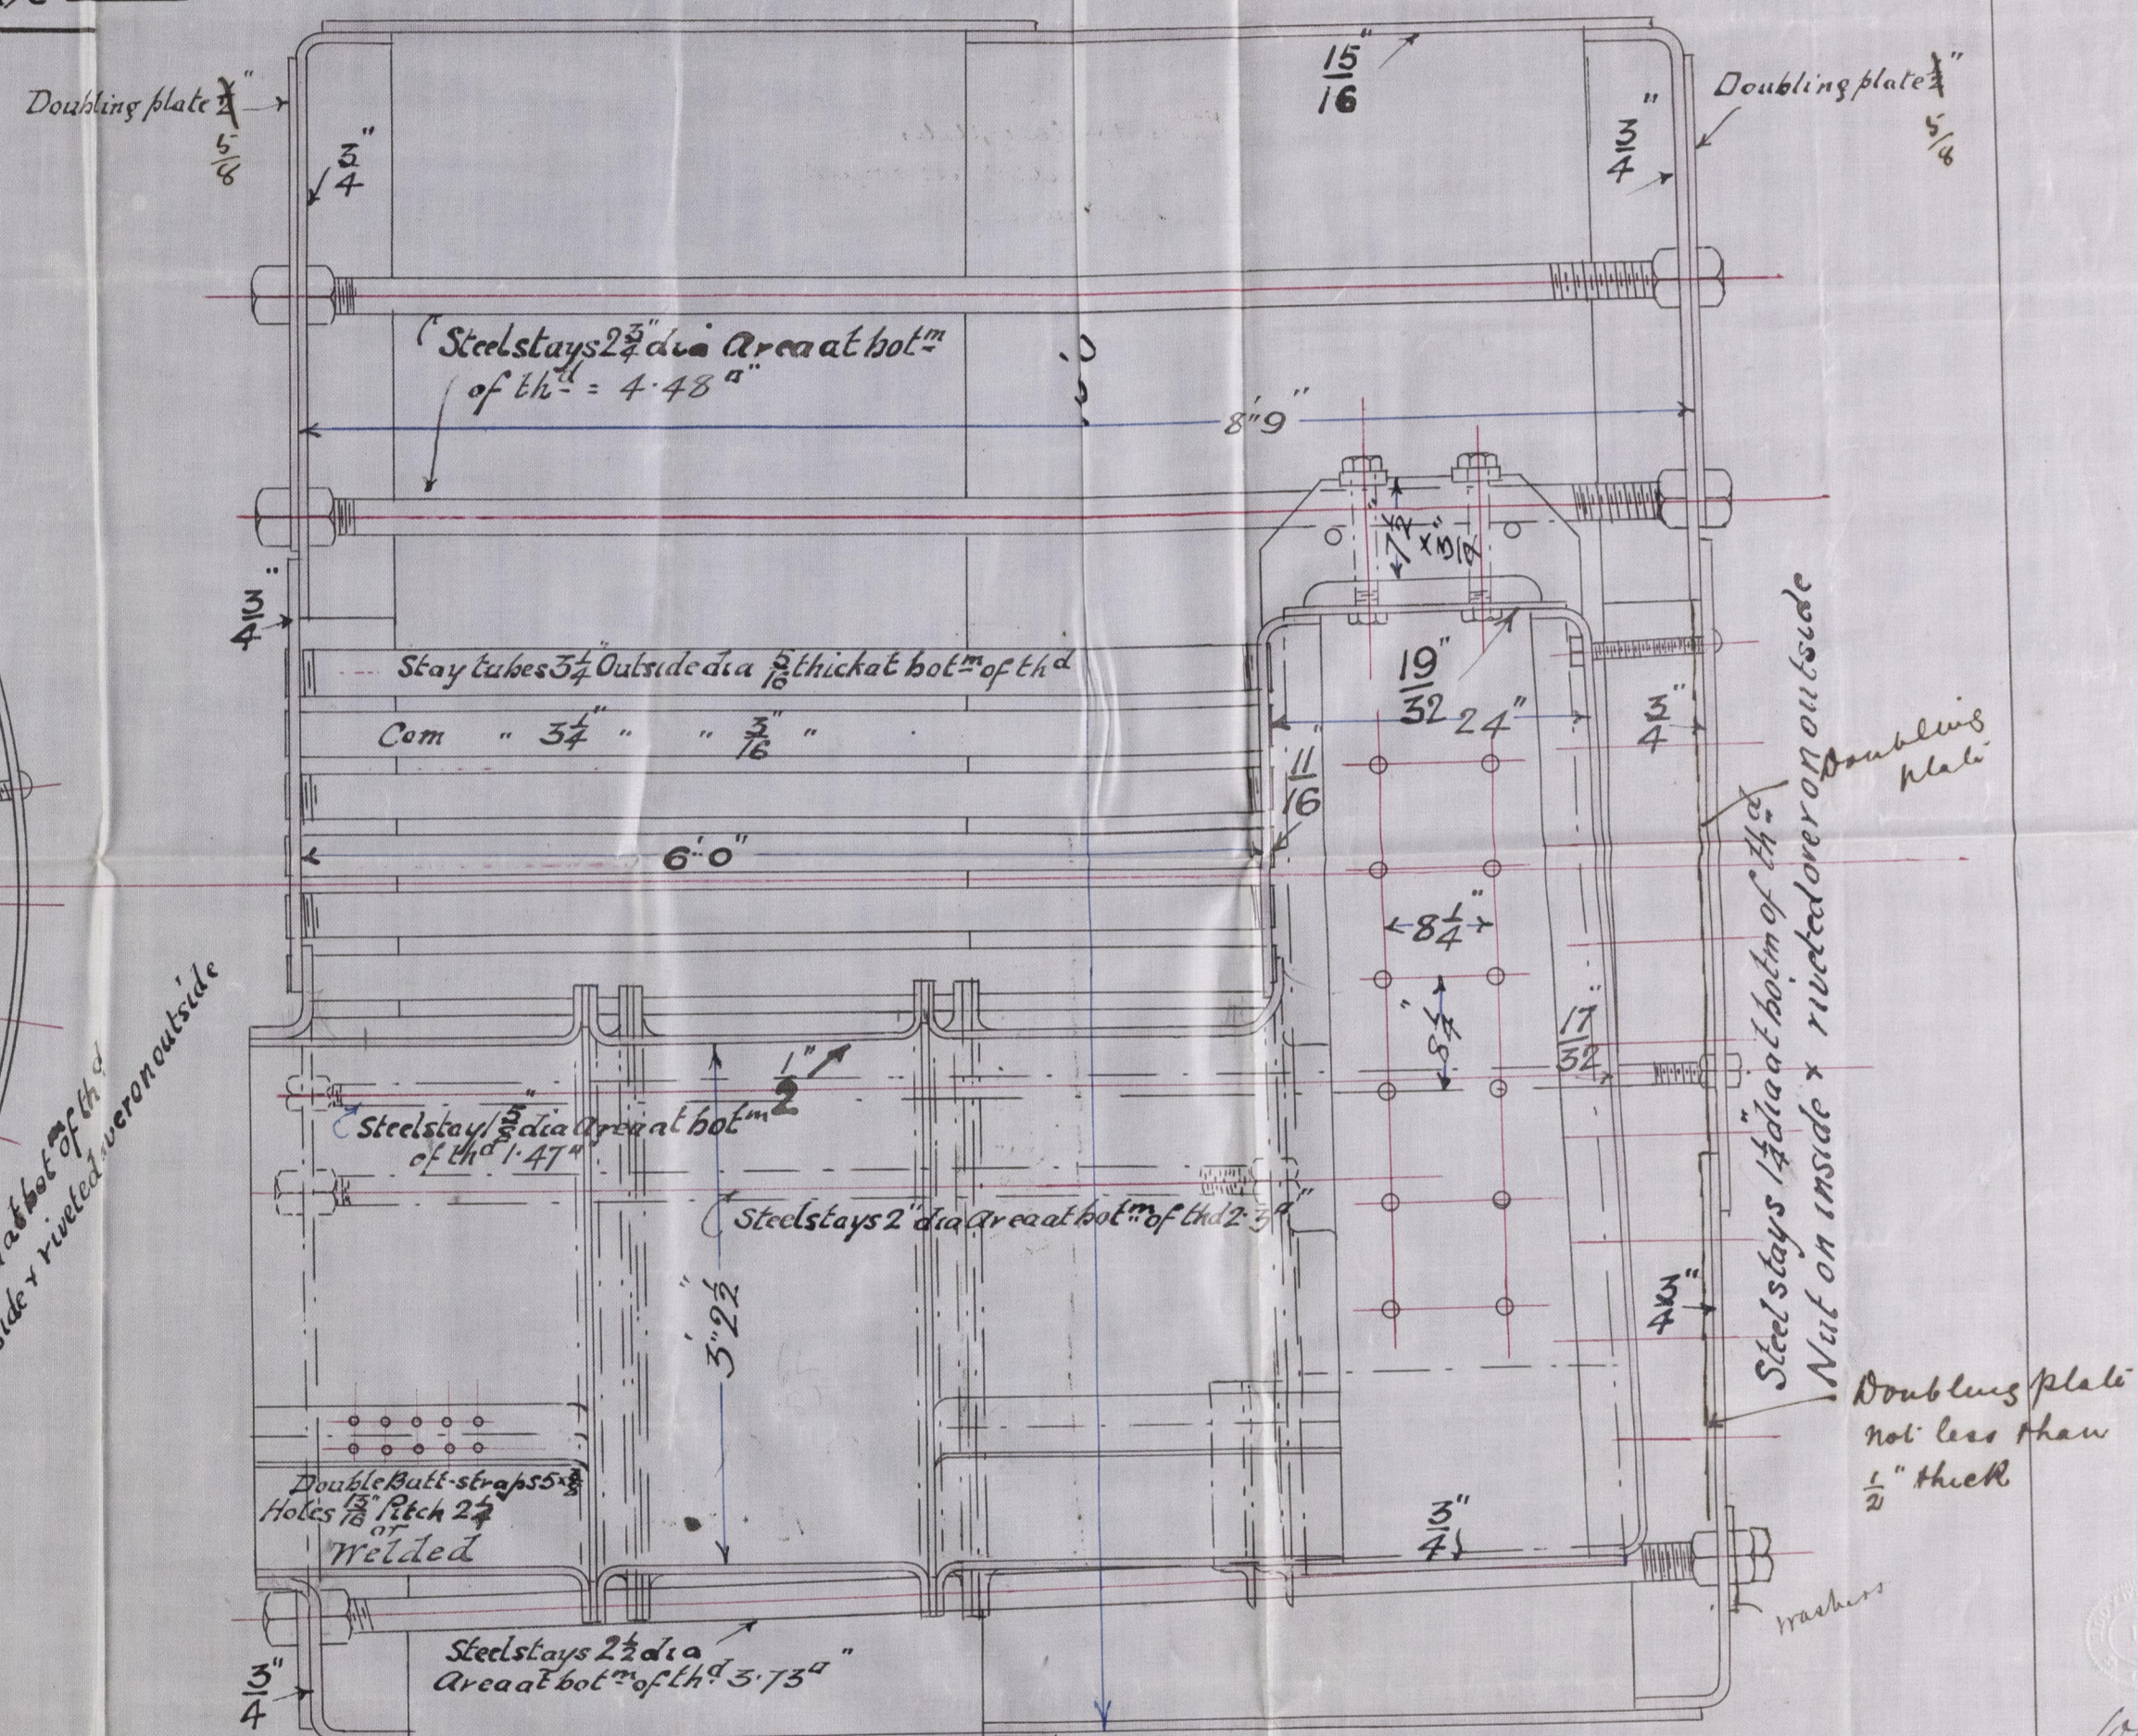

Double But straps 17" broad x $\frac{3}{4}$ "
Holes drilled $1\frac{1}{16}$ " in place $\frac{3}{4}$ but straps
Steel rivets.

The furnaces should be of $\frac{9}{16}$ plate or have 3 rings in each

ALD
5.2.89