

Lloyd's Register of British and Foreign Shipping.

(Report on Vessel No. 6033 Port Leith)

No. 2183 SHIP FORGINGS OR CASTINGS.

The words FORGINGS or CASTINGS, IRON or STEEL, should be struck out as may be required.

I have to report that the undermentioned Iron ~~or Steel~~ Forgings ~~or Castings~~, manufactured by Mess^{rs} Beardmore & Coy of Glasgow for the Vessel No. 117, being built by The Grangemouth Dockyard Coy of Grangemouth have been inspected by me as set forth below, and found to be, so far as can be seen, sound & efficient


Mark on Forgings.

Lloyd's
No. 2183

William Hamilton
Glasgow
7/10/89

	STERN FRAME.	RUDDER FRAME.	STEM.
Material* - - - -	/	Scrap iron	/
How made - - - -		Forged die die	
Dimensions - - - -		6 x 3	
Progress on Inspection -		Forging & Smithing	
Dates when Inspected		5. 10. 12. 16. 18. 20. 23. 24 26/9/89. 2. 4/10/89	

SKETCHES OF FRAMES SHEWING POSITION AND DESCRIPTION OF WELDS OF FORGINGS, OR PARTICULARS OF TESTS APPLIED TO CASTINGS.

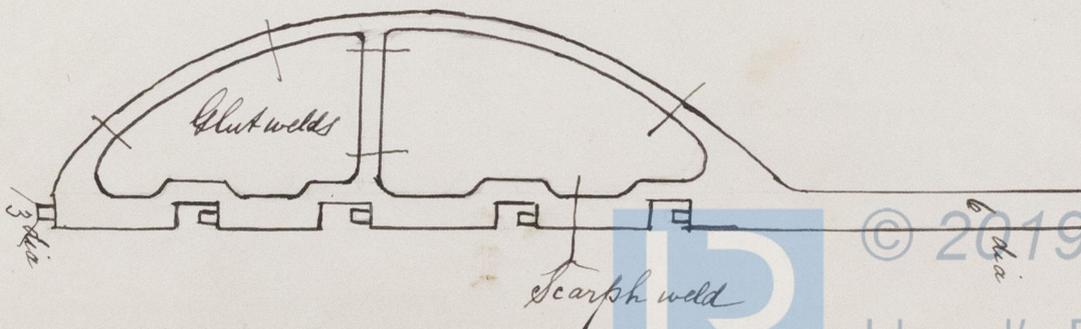

* If of Iron, state whether scrap or puddled Iron.