
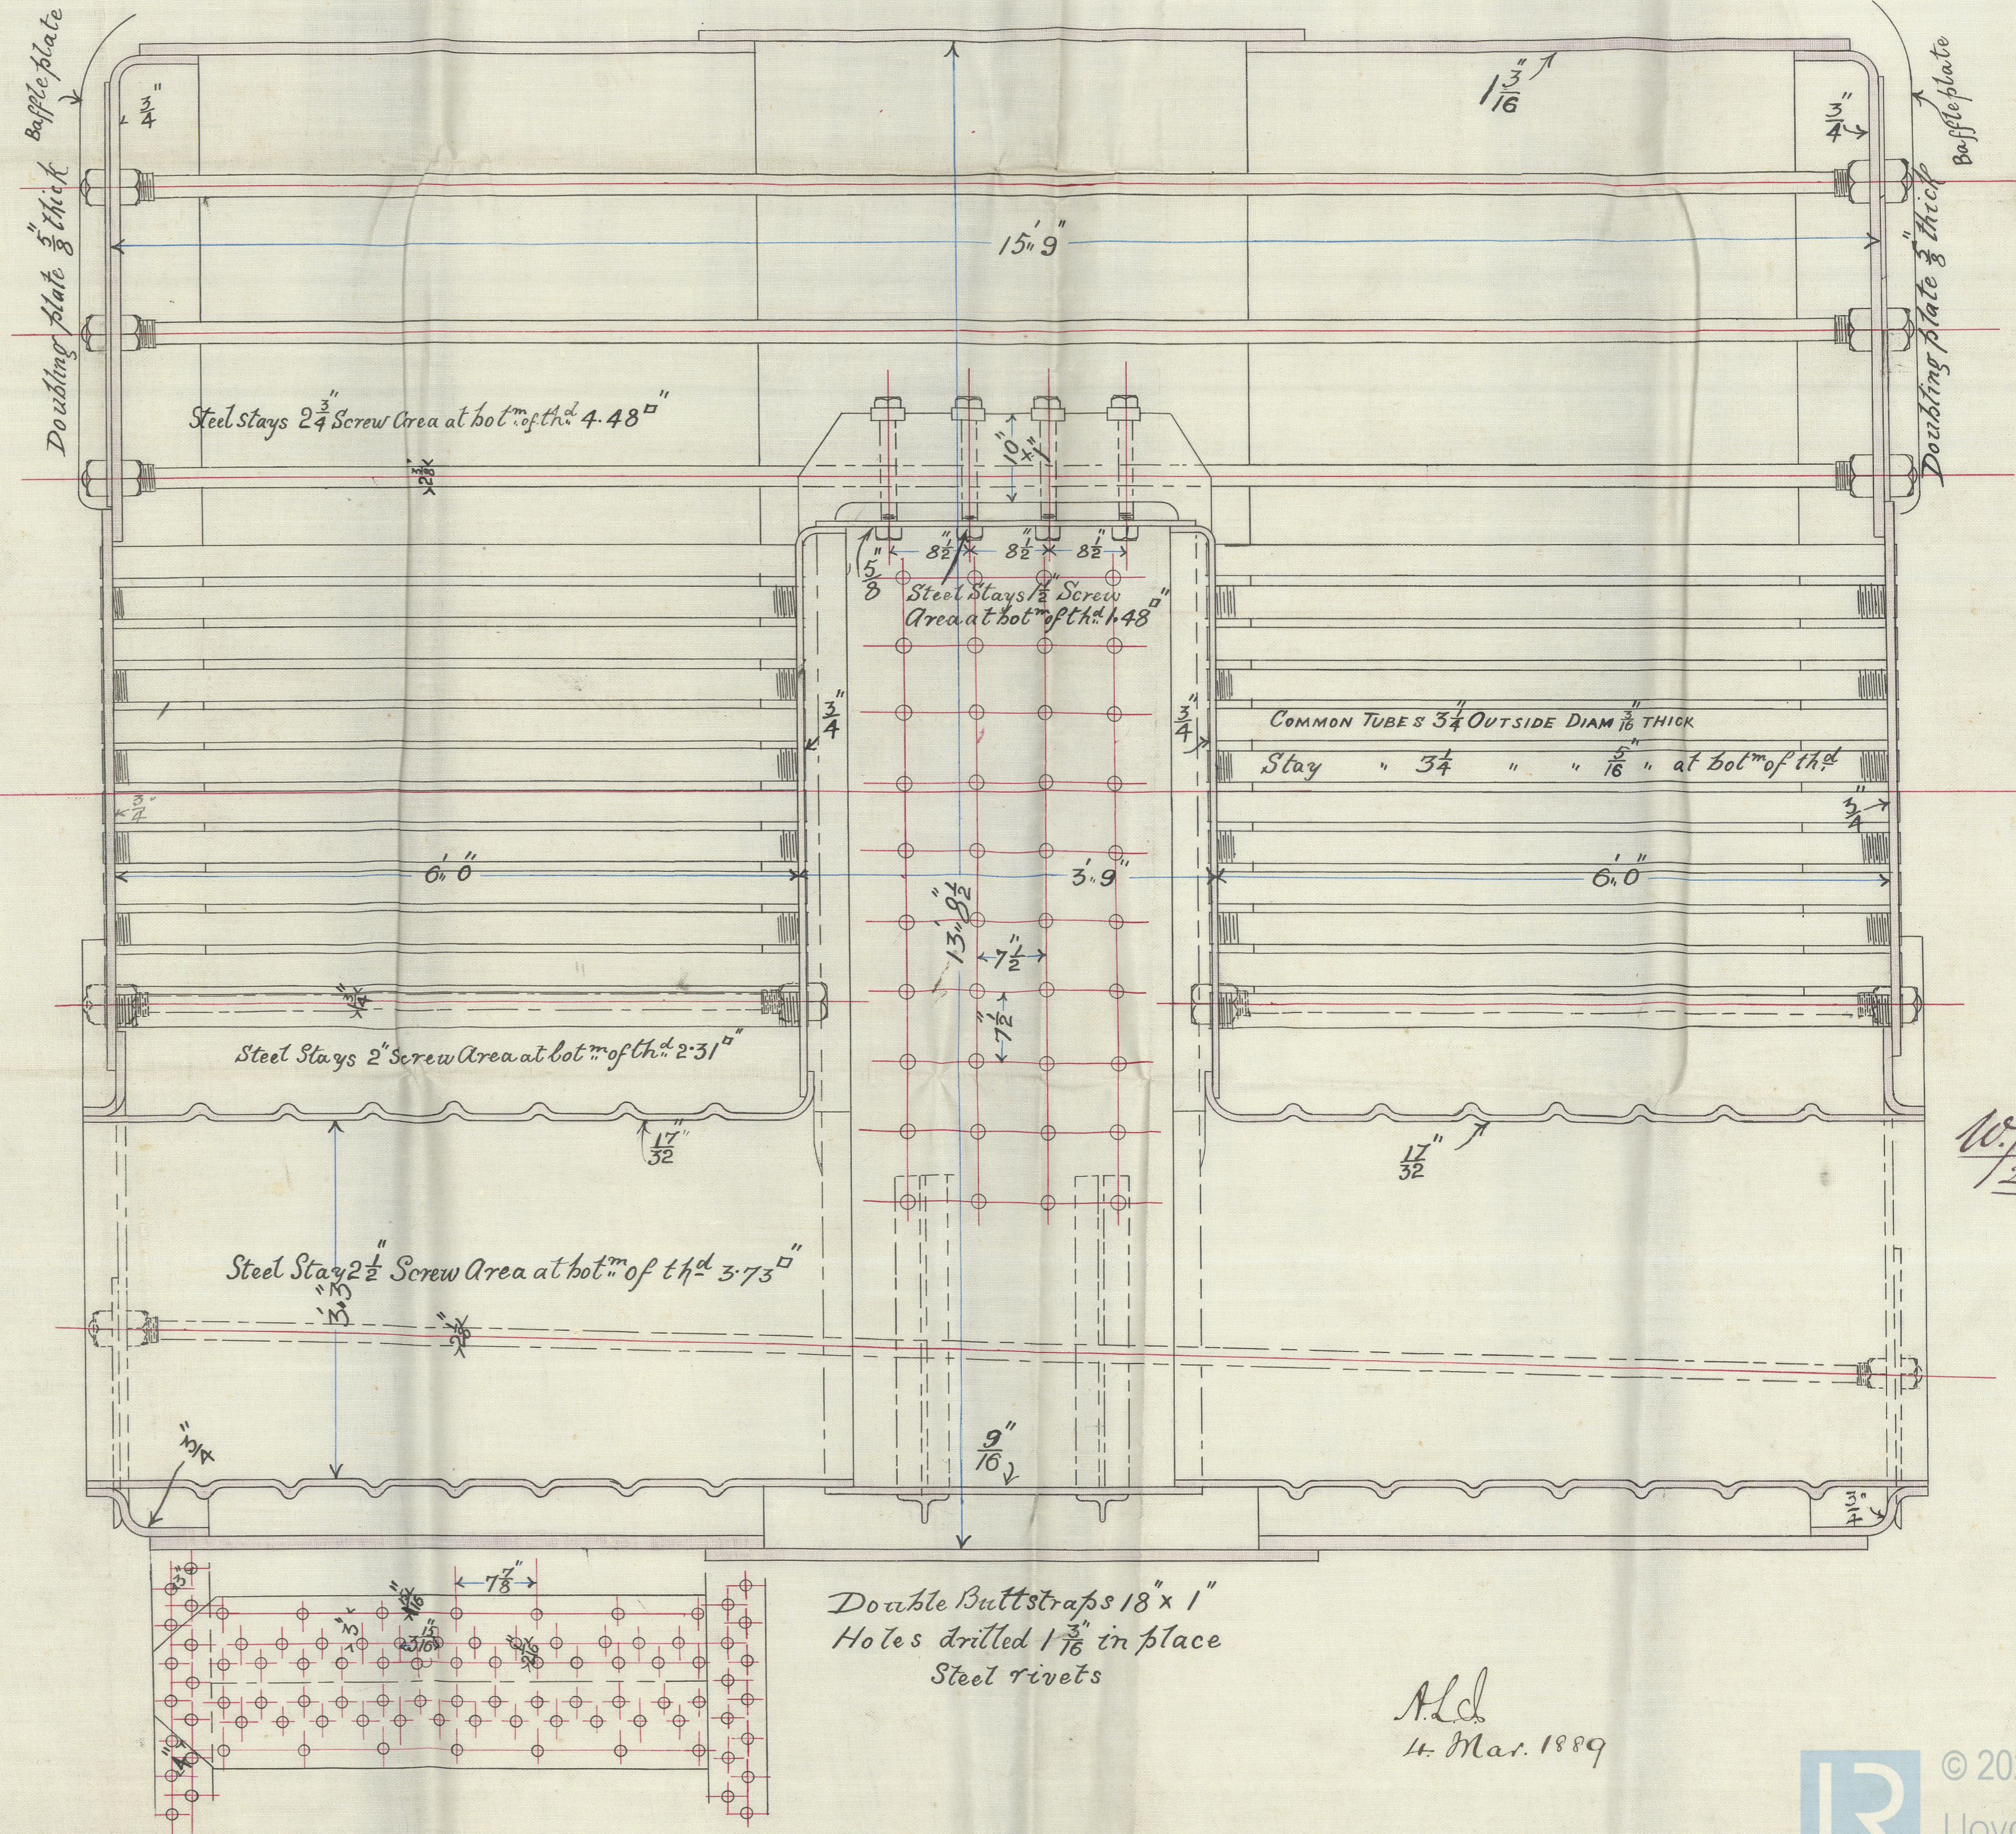


dh. 4/3/89

Boiler

Nº 67

WORKING PRESSURE = 156 lbs per sq in
Scale 1" = 1 ft.

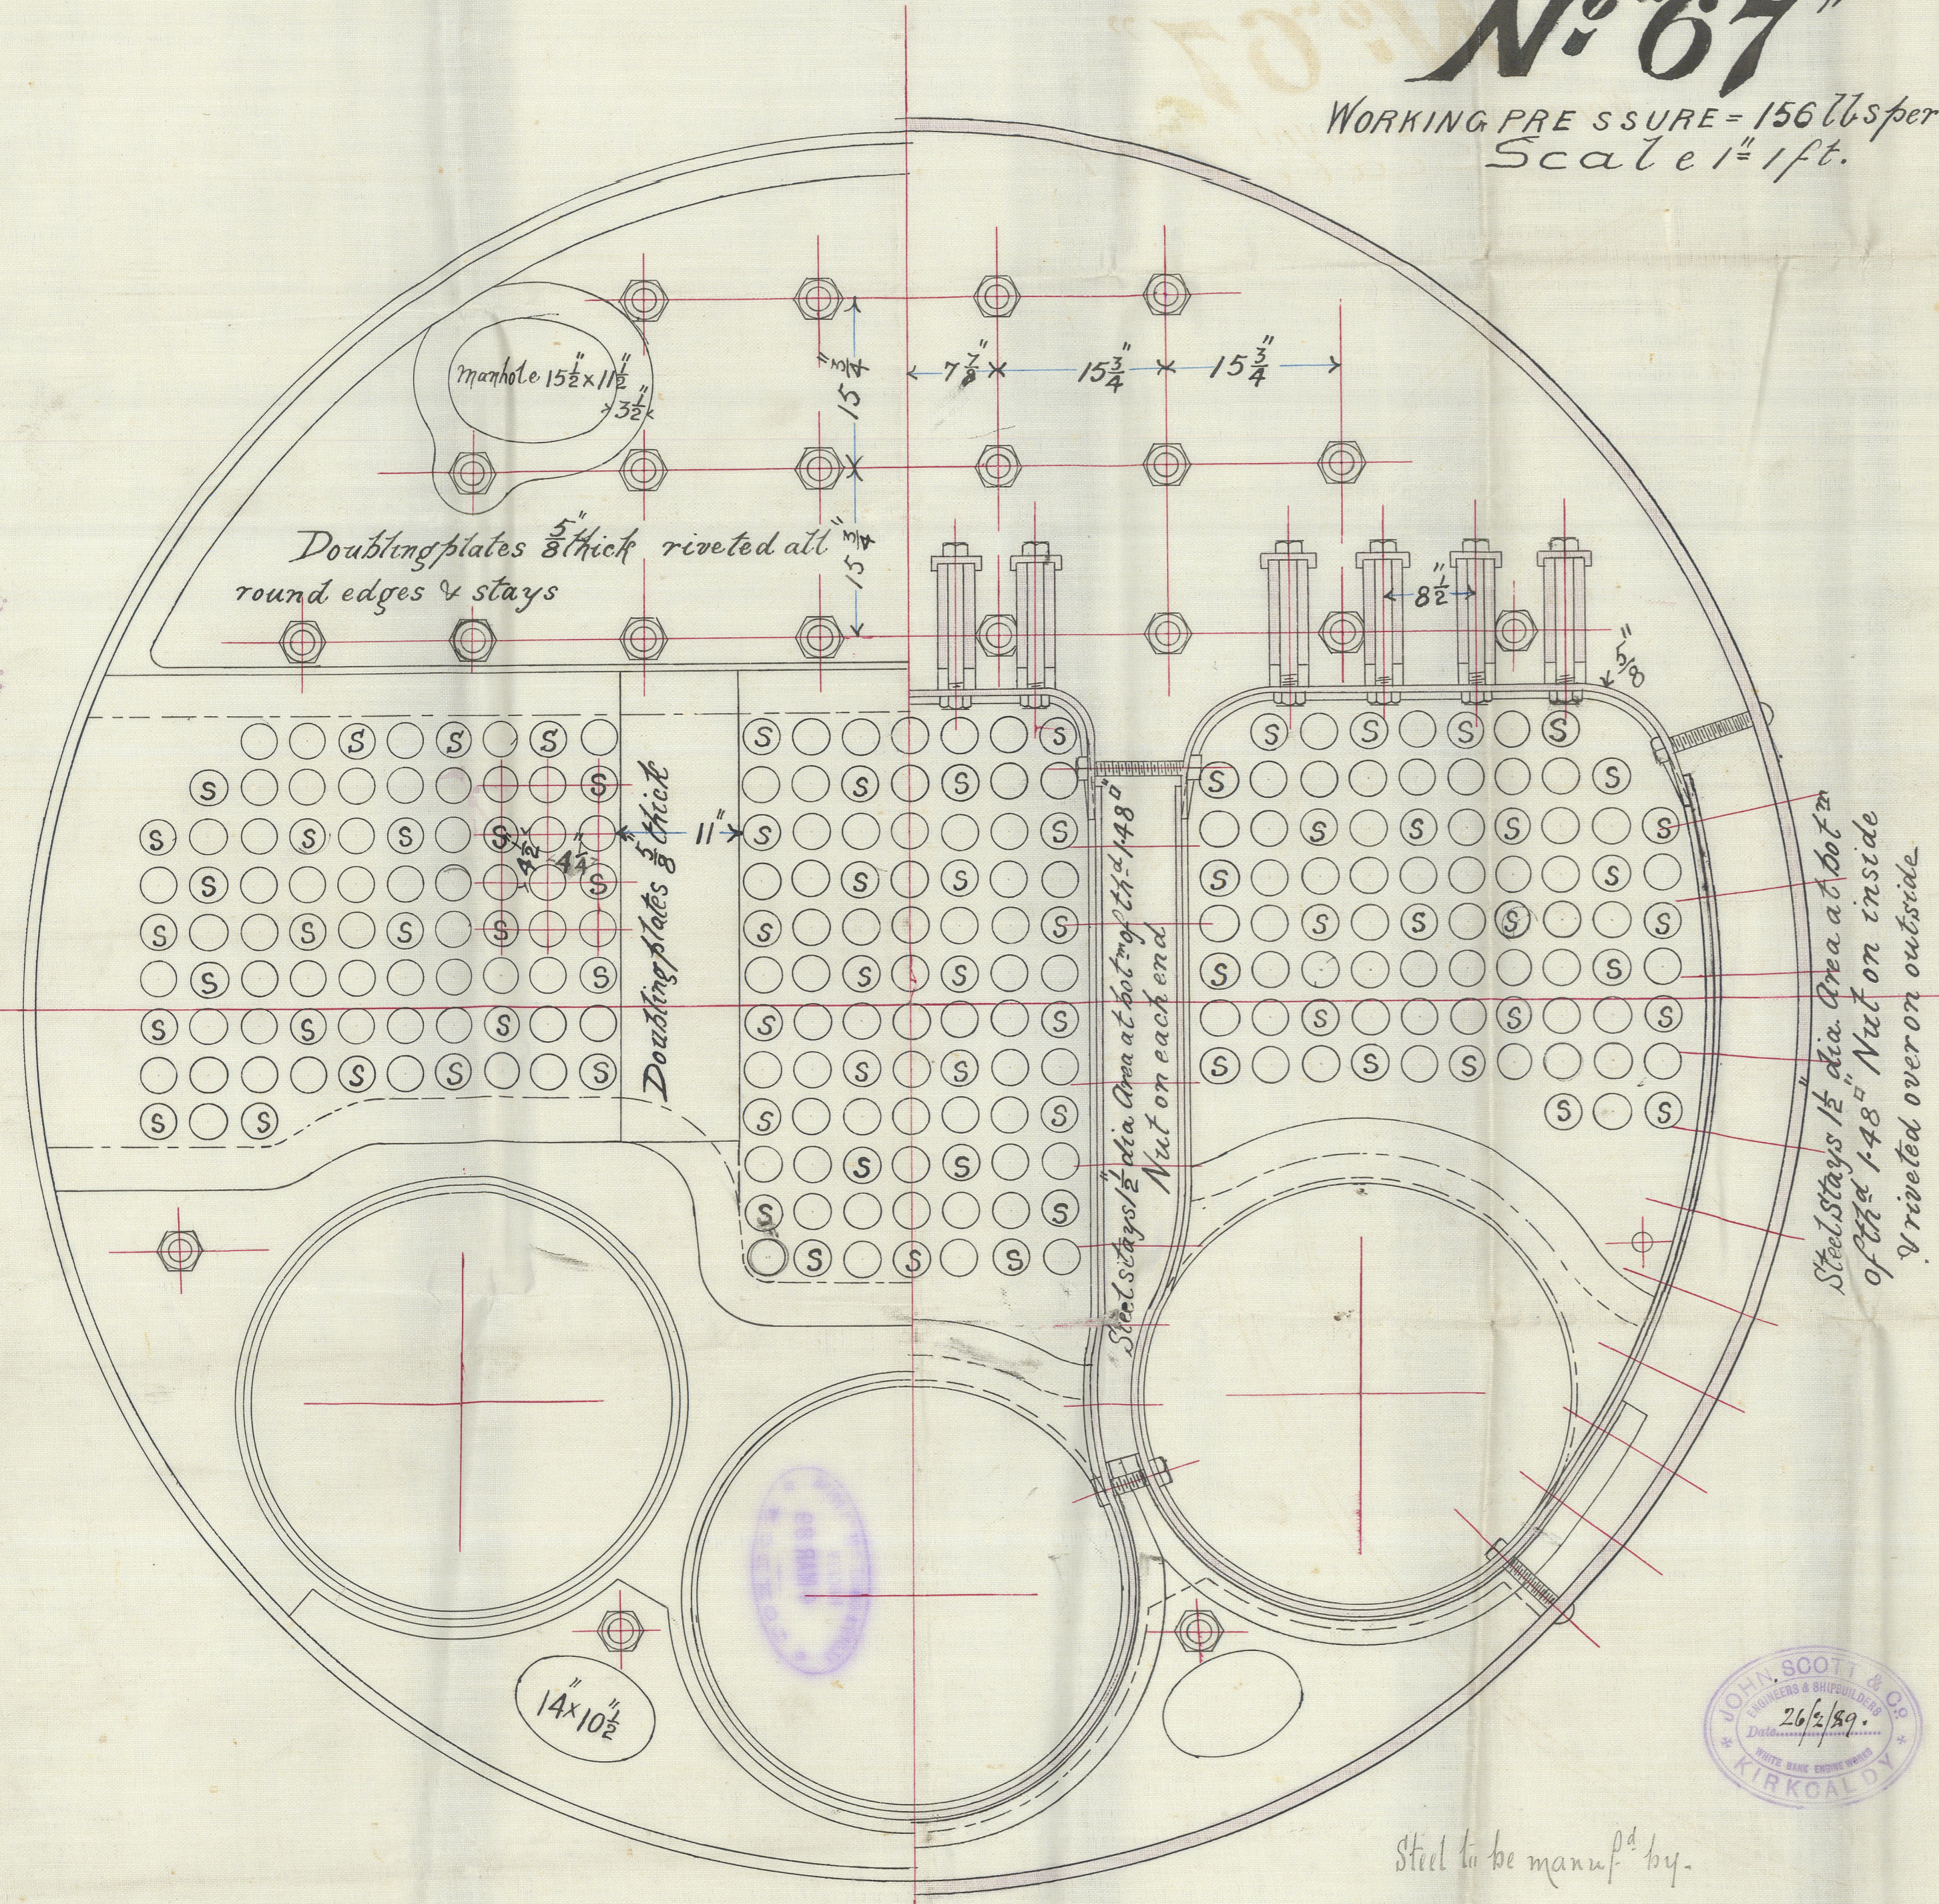

W.F.P.
12/3/89

Ald
14. Mar. 1889




© 2021

Lloyd's Register
Foundation

LTHT559-0195

S. P. Buccamer
 Lenth Report No. 6157

13 3 11 11

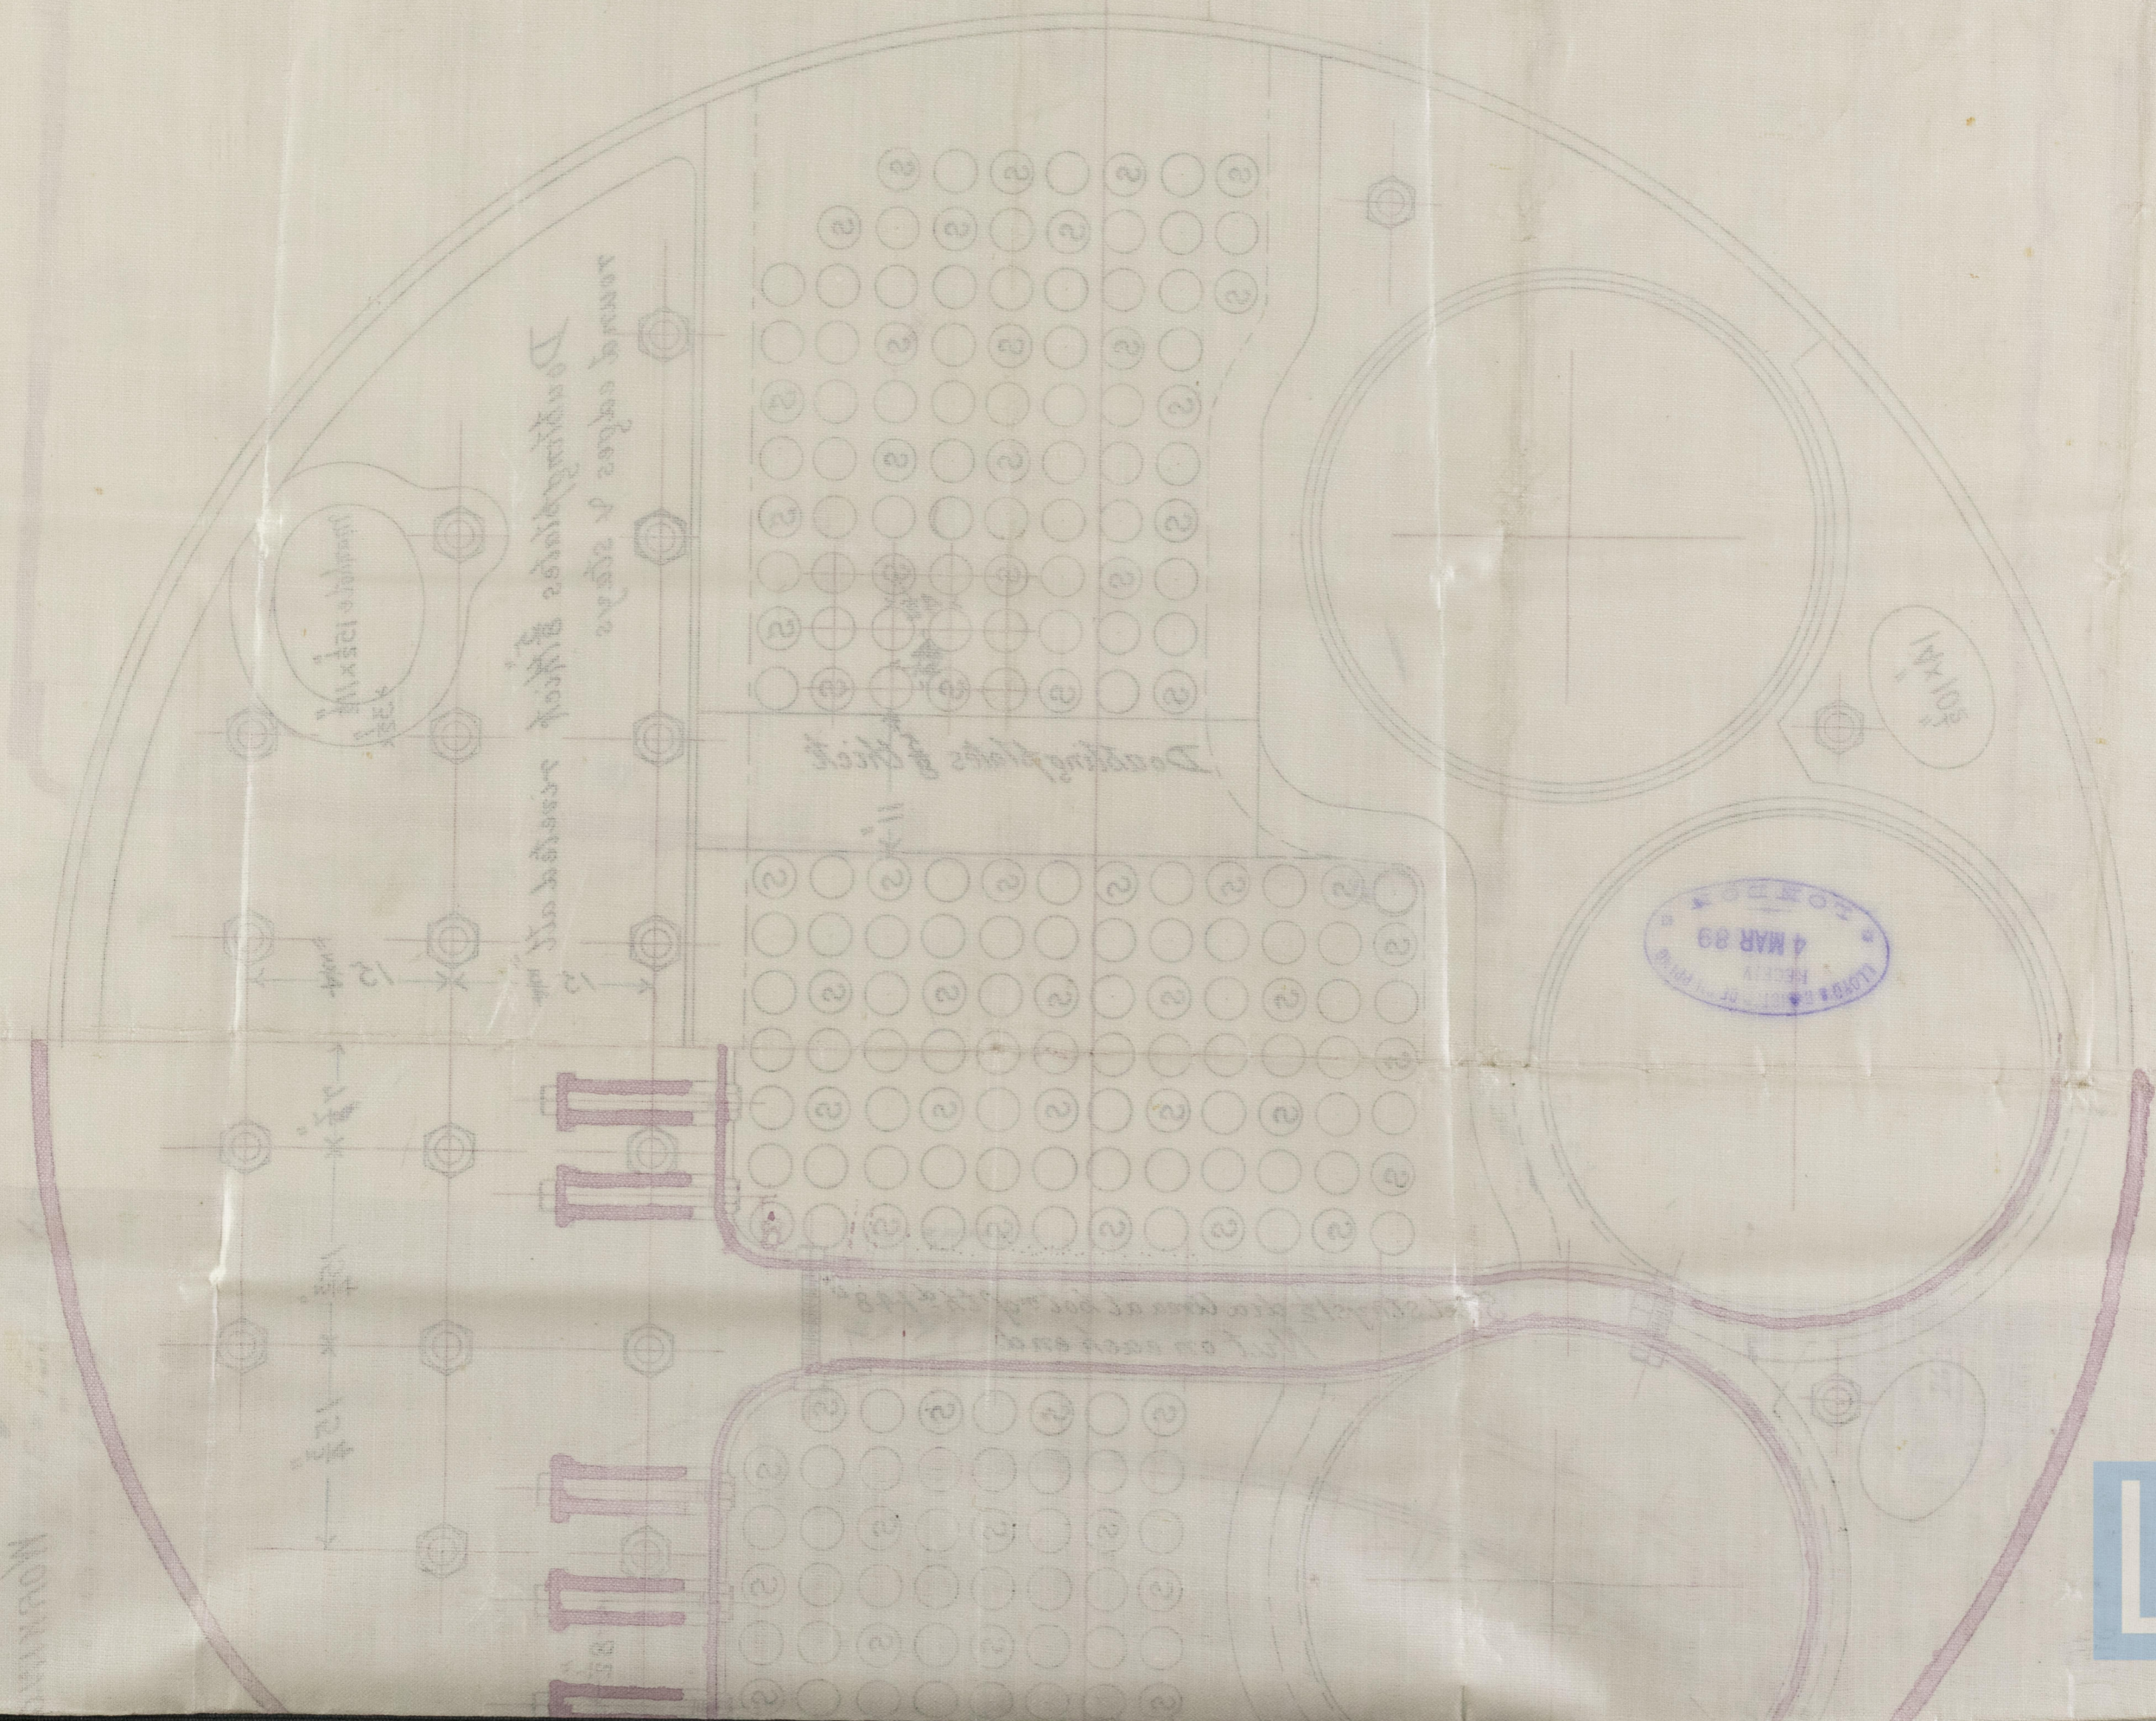

© 2021
 Lloyd's Register
 Foundation