






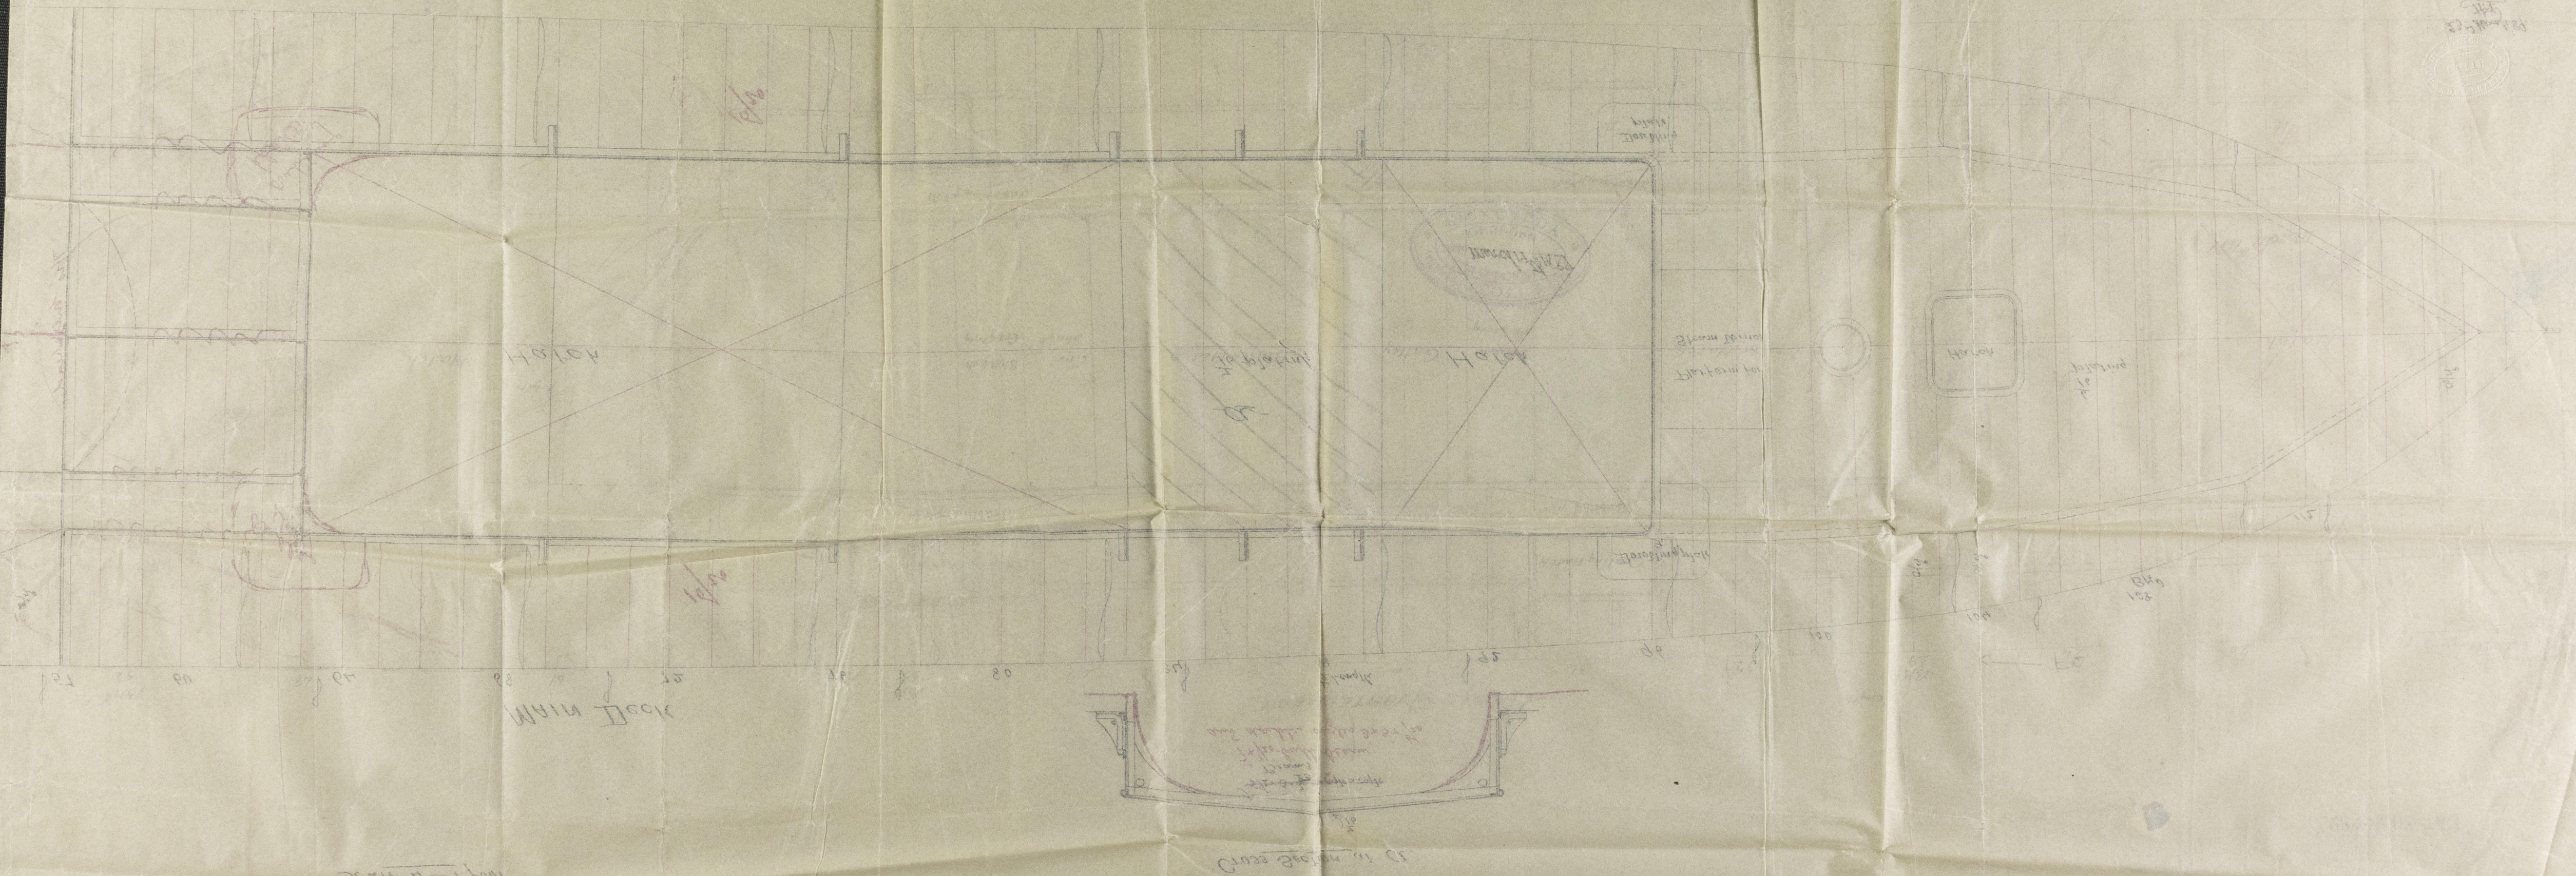

© 2021
Lloyd's Register
Foundation

2020 - LS5417

233 No 67
Plan of Deck
Scale 1/4" = 1 ft

SAT 30 MAR 89



J. S. P. D. 1889
L. S. P. D. 1889

LLOYD'S REGISTER OF SHIPPING
25 MAR 89

LLOYD'S REGISTER OF SHIPPING
1 NOV 90



© 2021
Lloyd's Register
Foundation