


22 V-67
 217-0 x 30-0 x 10-4 Mon
 Proprietary Section
2nd Floor

LODGE'S REGISTER OF SHIPPING
 RECEIVED
 25 MAR. 89

S.P. Buccannan
 Little Report No 6157

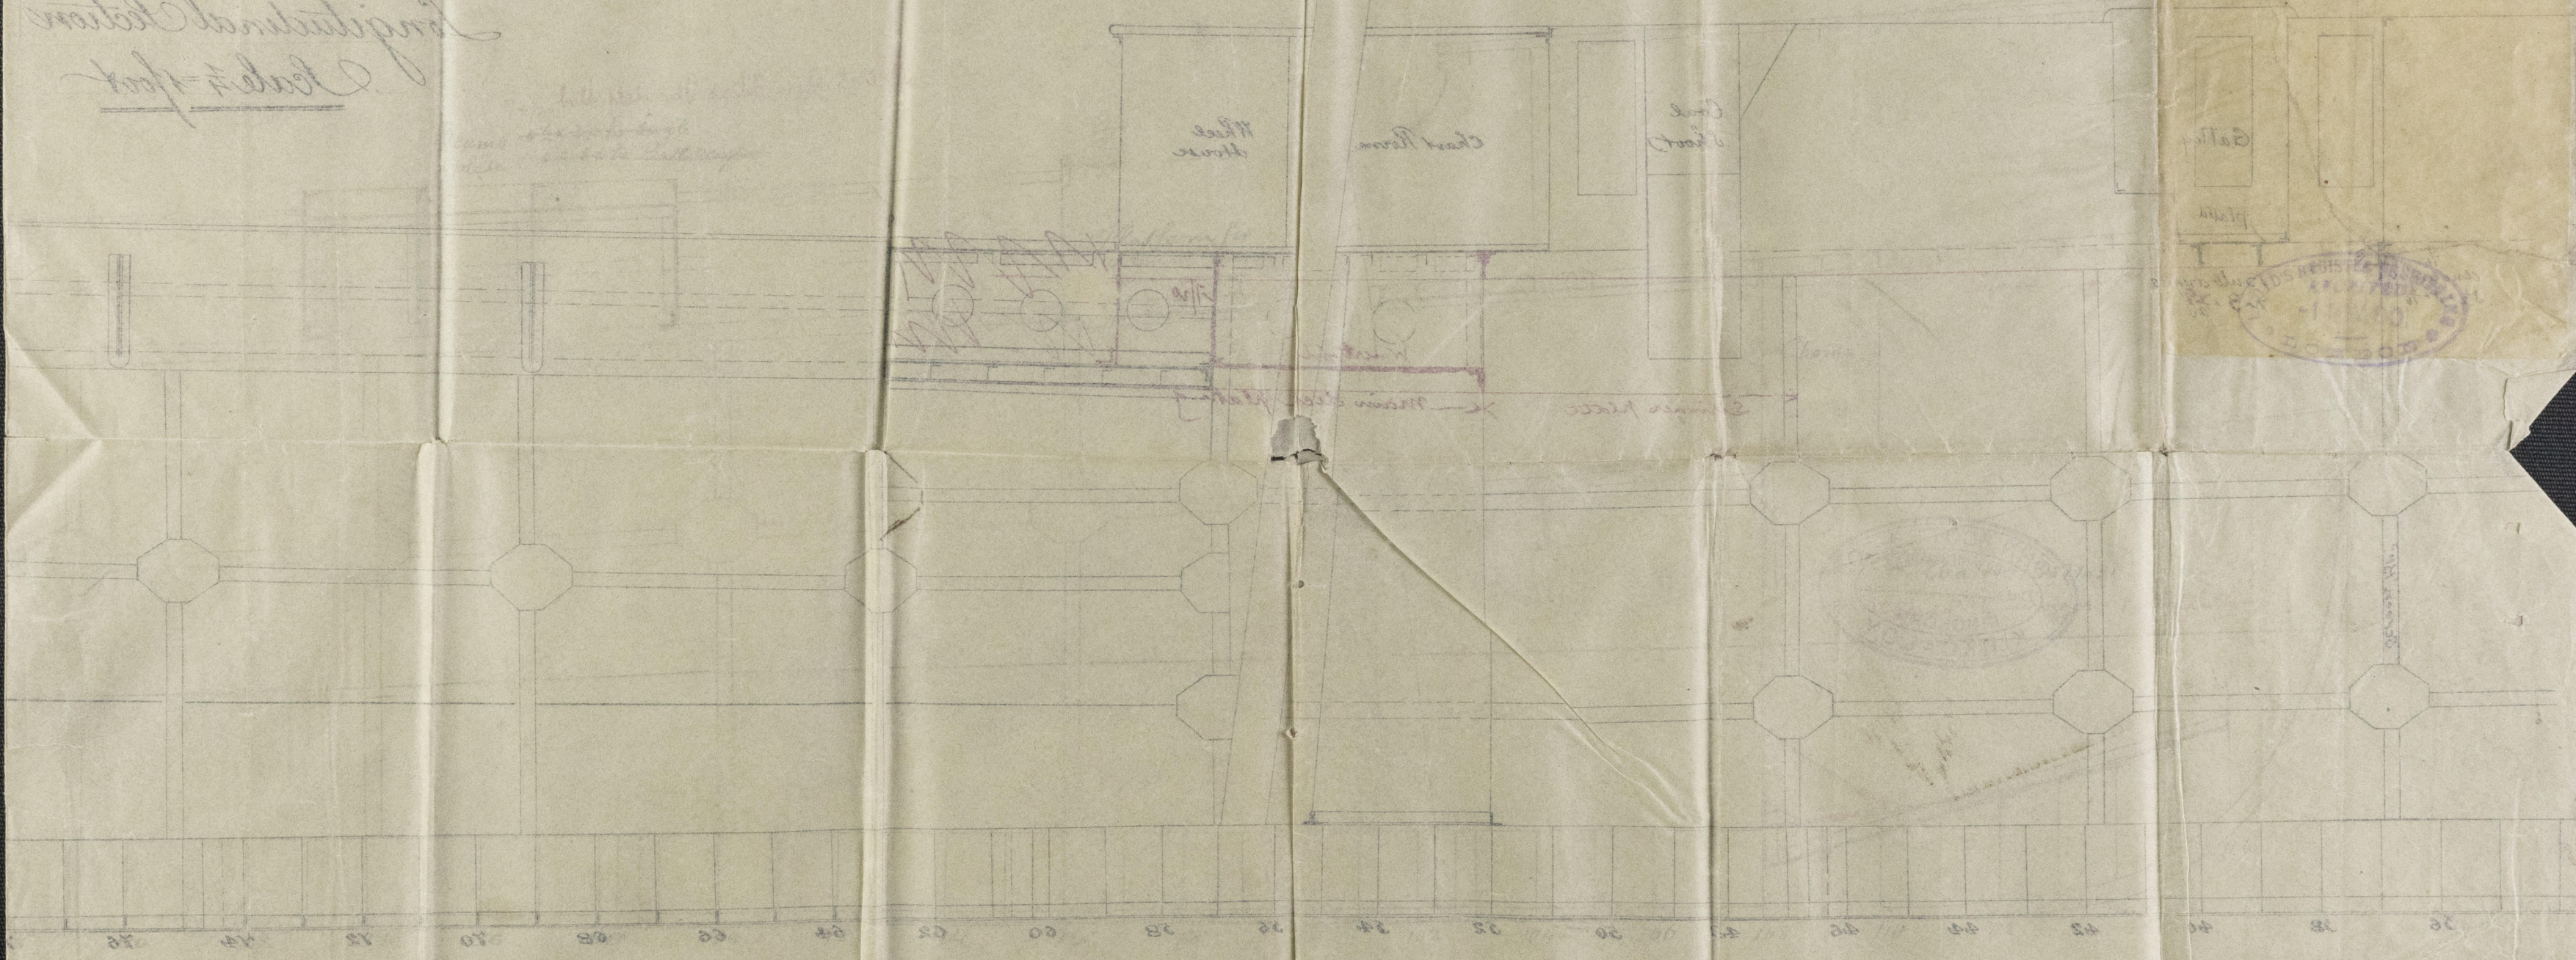

LODGE'S REGISTER OF SHIPPING
 RECEIVED
 25 MAR. 89