


"Faith"

Scale $\frac{1}{4}'' = 1 \text{ foot.}$

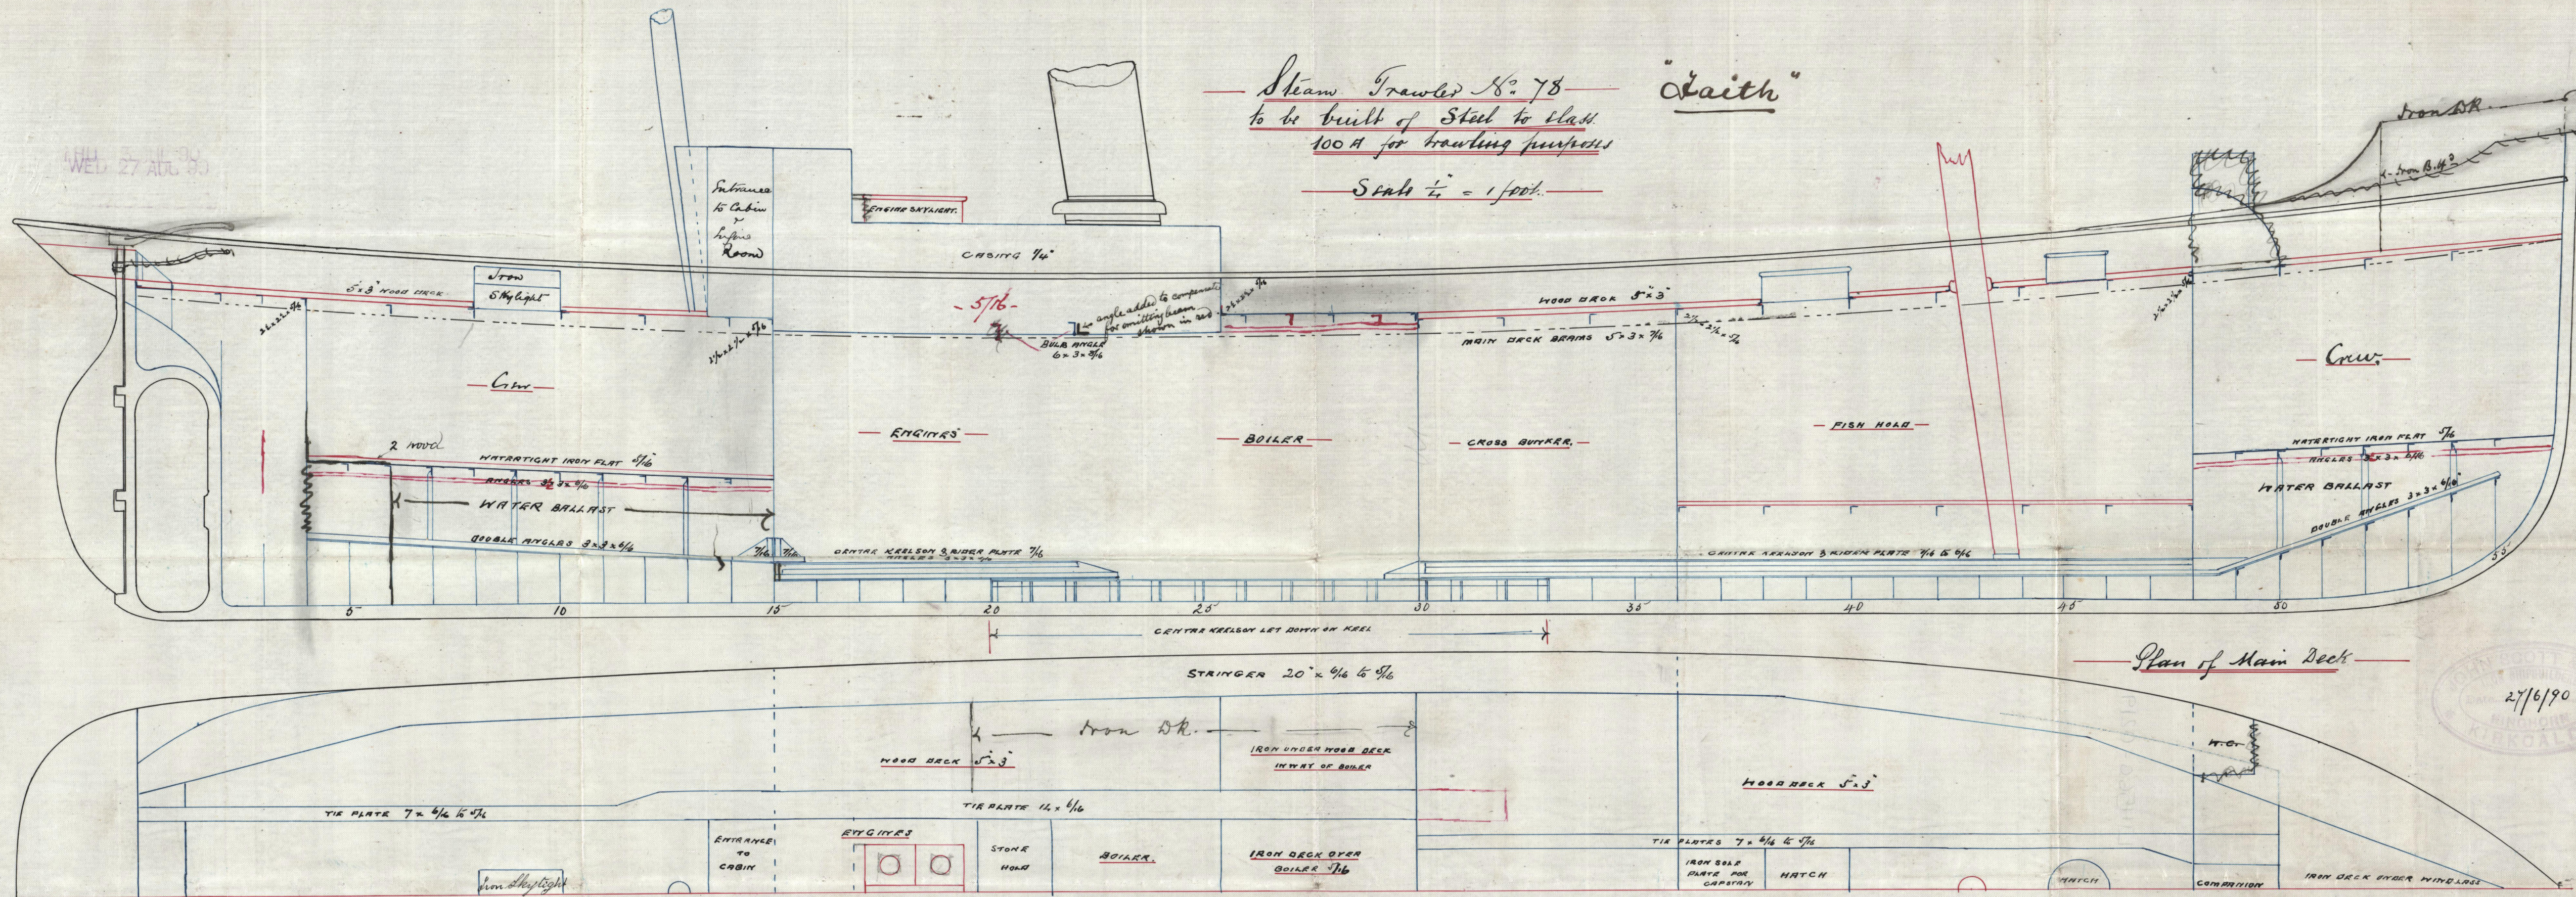

- W. J. R. M.


J.H.L.
2/7/90

10/P.
1306/90
© 2020

Screw Steam Trawler "Faith"
Lth. Rept. No.

5/16/80


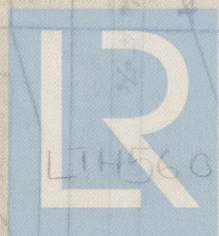

© 2020

LTH560-0219

Lloyd's Register
Foundation