


12.3.91.

summit A.P.
p872 211. 12/3/91

— ELEVATION —
— SAILING BARQUE N^o 156 —
— DIMENSIONS —
— 204' B.P. x 33'-10" x 20'-10" ML² —
— SCALE $\frac{1}{8}$ " INCH PER FOOT. —

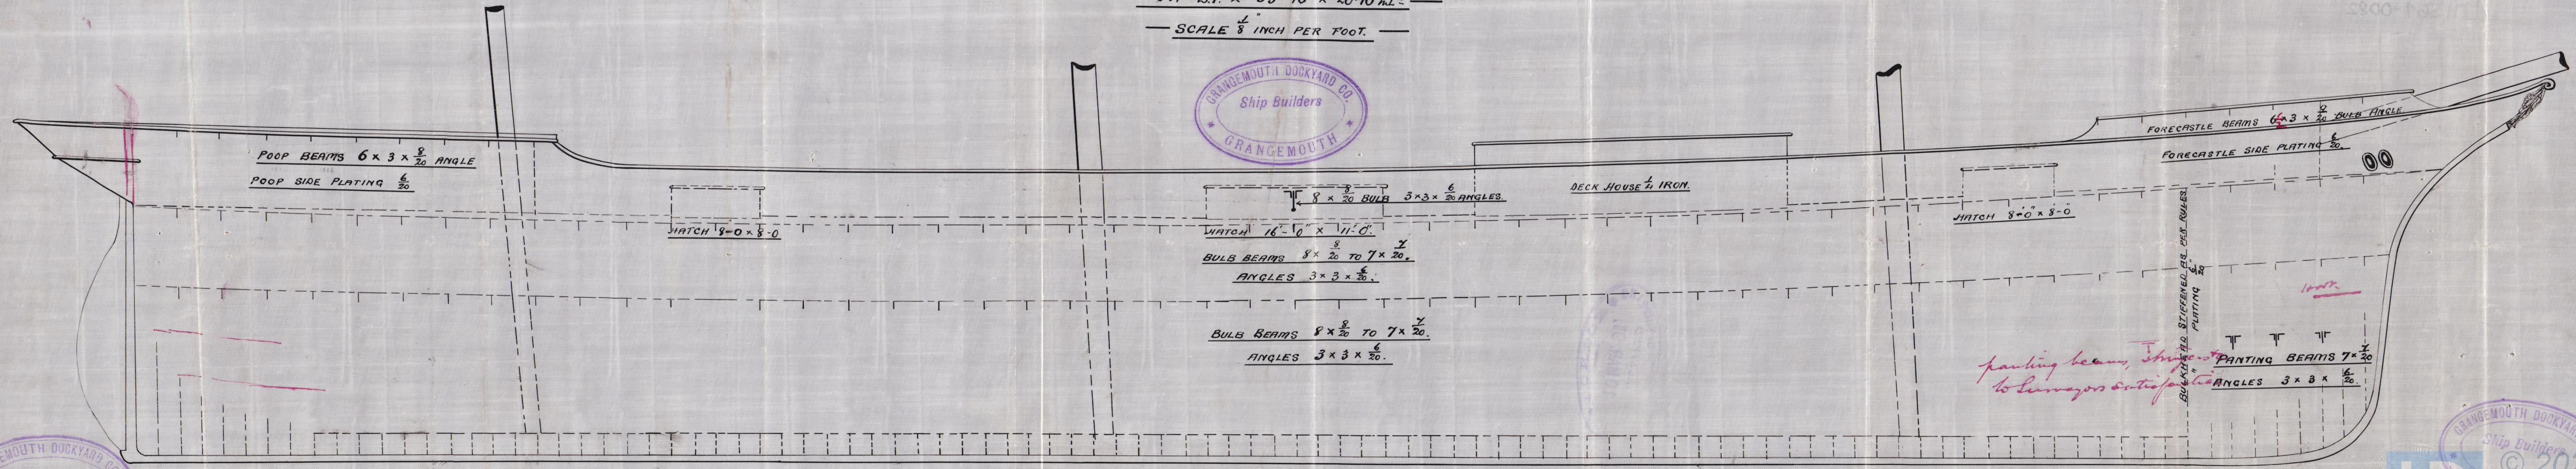

H.B.
12/3/91



94 March 91.
Lloyd's Register Foundation

LTH567-0082

Lth. Report No 6789

LTW 561-0082

10 MAR 91

© 2020

Lloyd's Register
Foundation