

Lloyd's Register of British and Foreign Shipping.

Leith (Report on Vessel No. *6789* Port *Leith*)

The words FORGINGS or CASTINGS, IRON or STEEL, should be struck out as may be required.

No. *1486a* SHIP FORGINGS OR CASTINGS.

I have to report that the undermentioned Iron or Steel Forgings or Castings, manufactured by *The North Quay Forge Co.* of *Sunderland* for the Vessel No. *156*, being built by *The Grangemouth Dockyard Co.* of *Grangemouth* have been inspected by me as set forth below, and found to be, so far as can be seen, *sound*


Mark on Forgings.

Lloyd's
No. *1486a*
10.6


W. H. Cannon
Sunderland
16/9/91

	STERN FRAME.	RUDDER FRAME.	STEM.
Material*	<i>Scrap iron</i>	<i>Scrap iron</i>	<i>Scrap iron</i>
How made	<i>Faged</i>	<i>Faged</i>	<i>Faged</i>
Dimensions	<i>7 1/4" x 2 3/8"</i>	<i>5 7/8" - 3"</i>	<i>7 1/4" x 2 3/8"</i>
Progress on Inspection	<i>Faged & smithed</i>	<i>Faged & smithed</i>	<i>Faged</i>
Dates when Inspected	<i>June 11-17-20/91</i>	<i>July 29 Aug 1-14-19/91</i>	<i>June 20/91</i>

SKETCHES OF FRAMES SHEWING POSITION AND DESCRIPTION OF WELDS OF FORGINGS, OR PARTICULARS OF TESTS APPLIED TO CASTINGS.

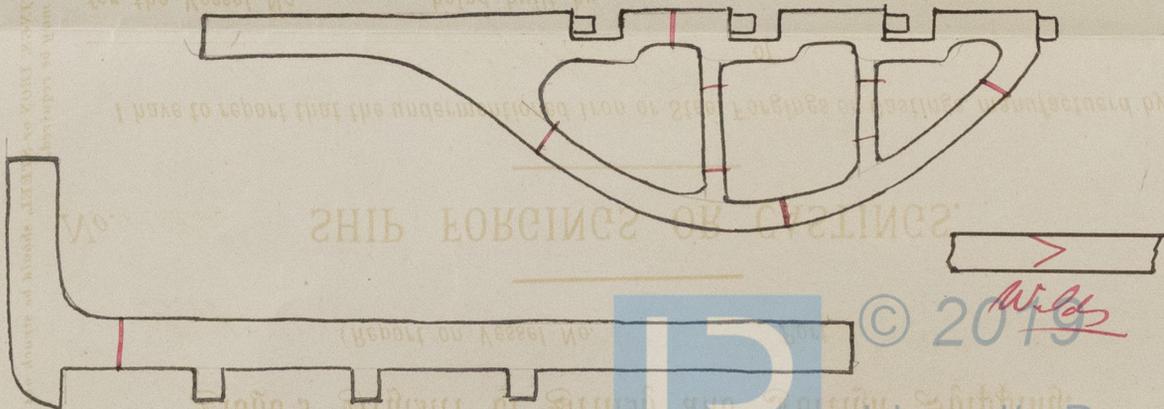

B.R. "Primus"
Lth. Report. No. 6789

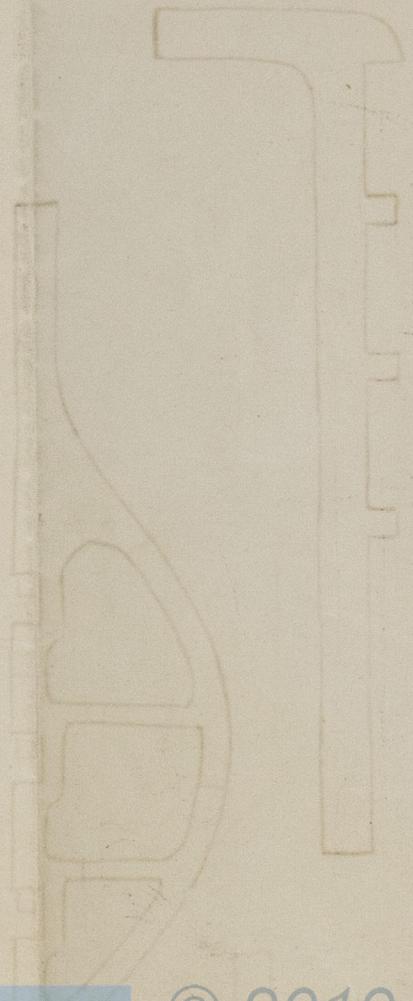

© 2019

Lloyd's Register
Foundation