


5.6.91.

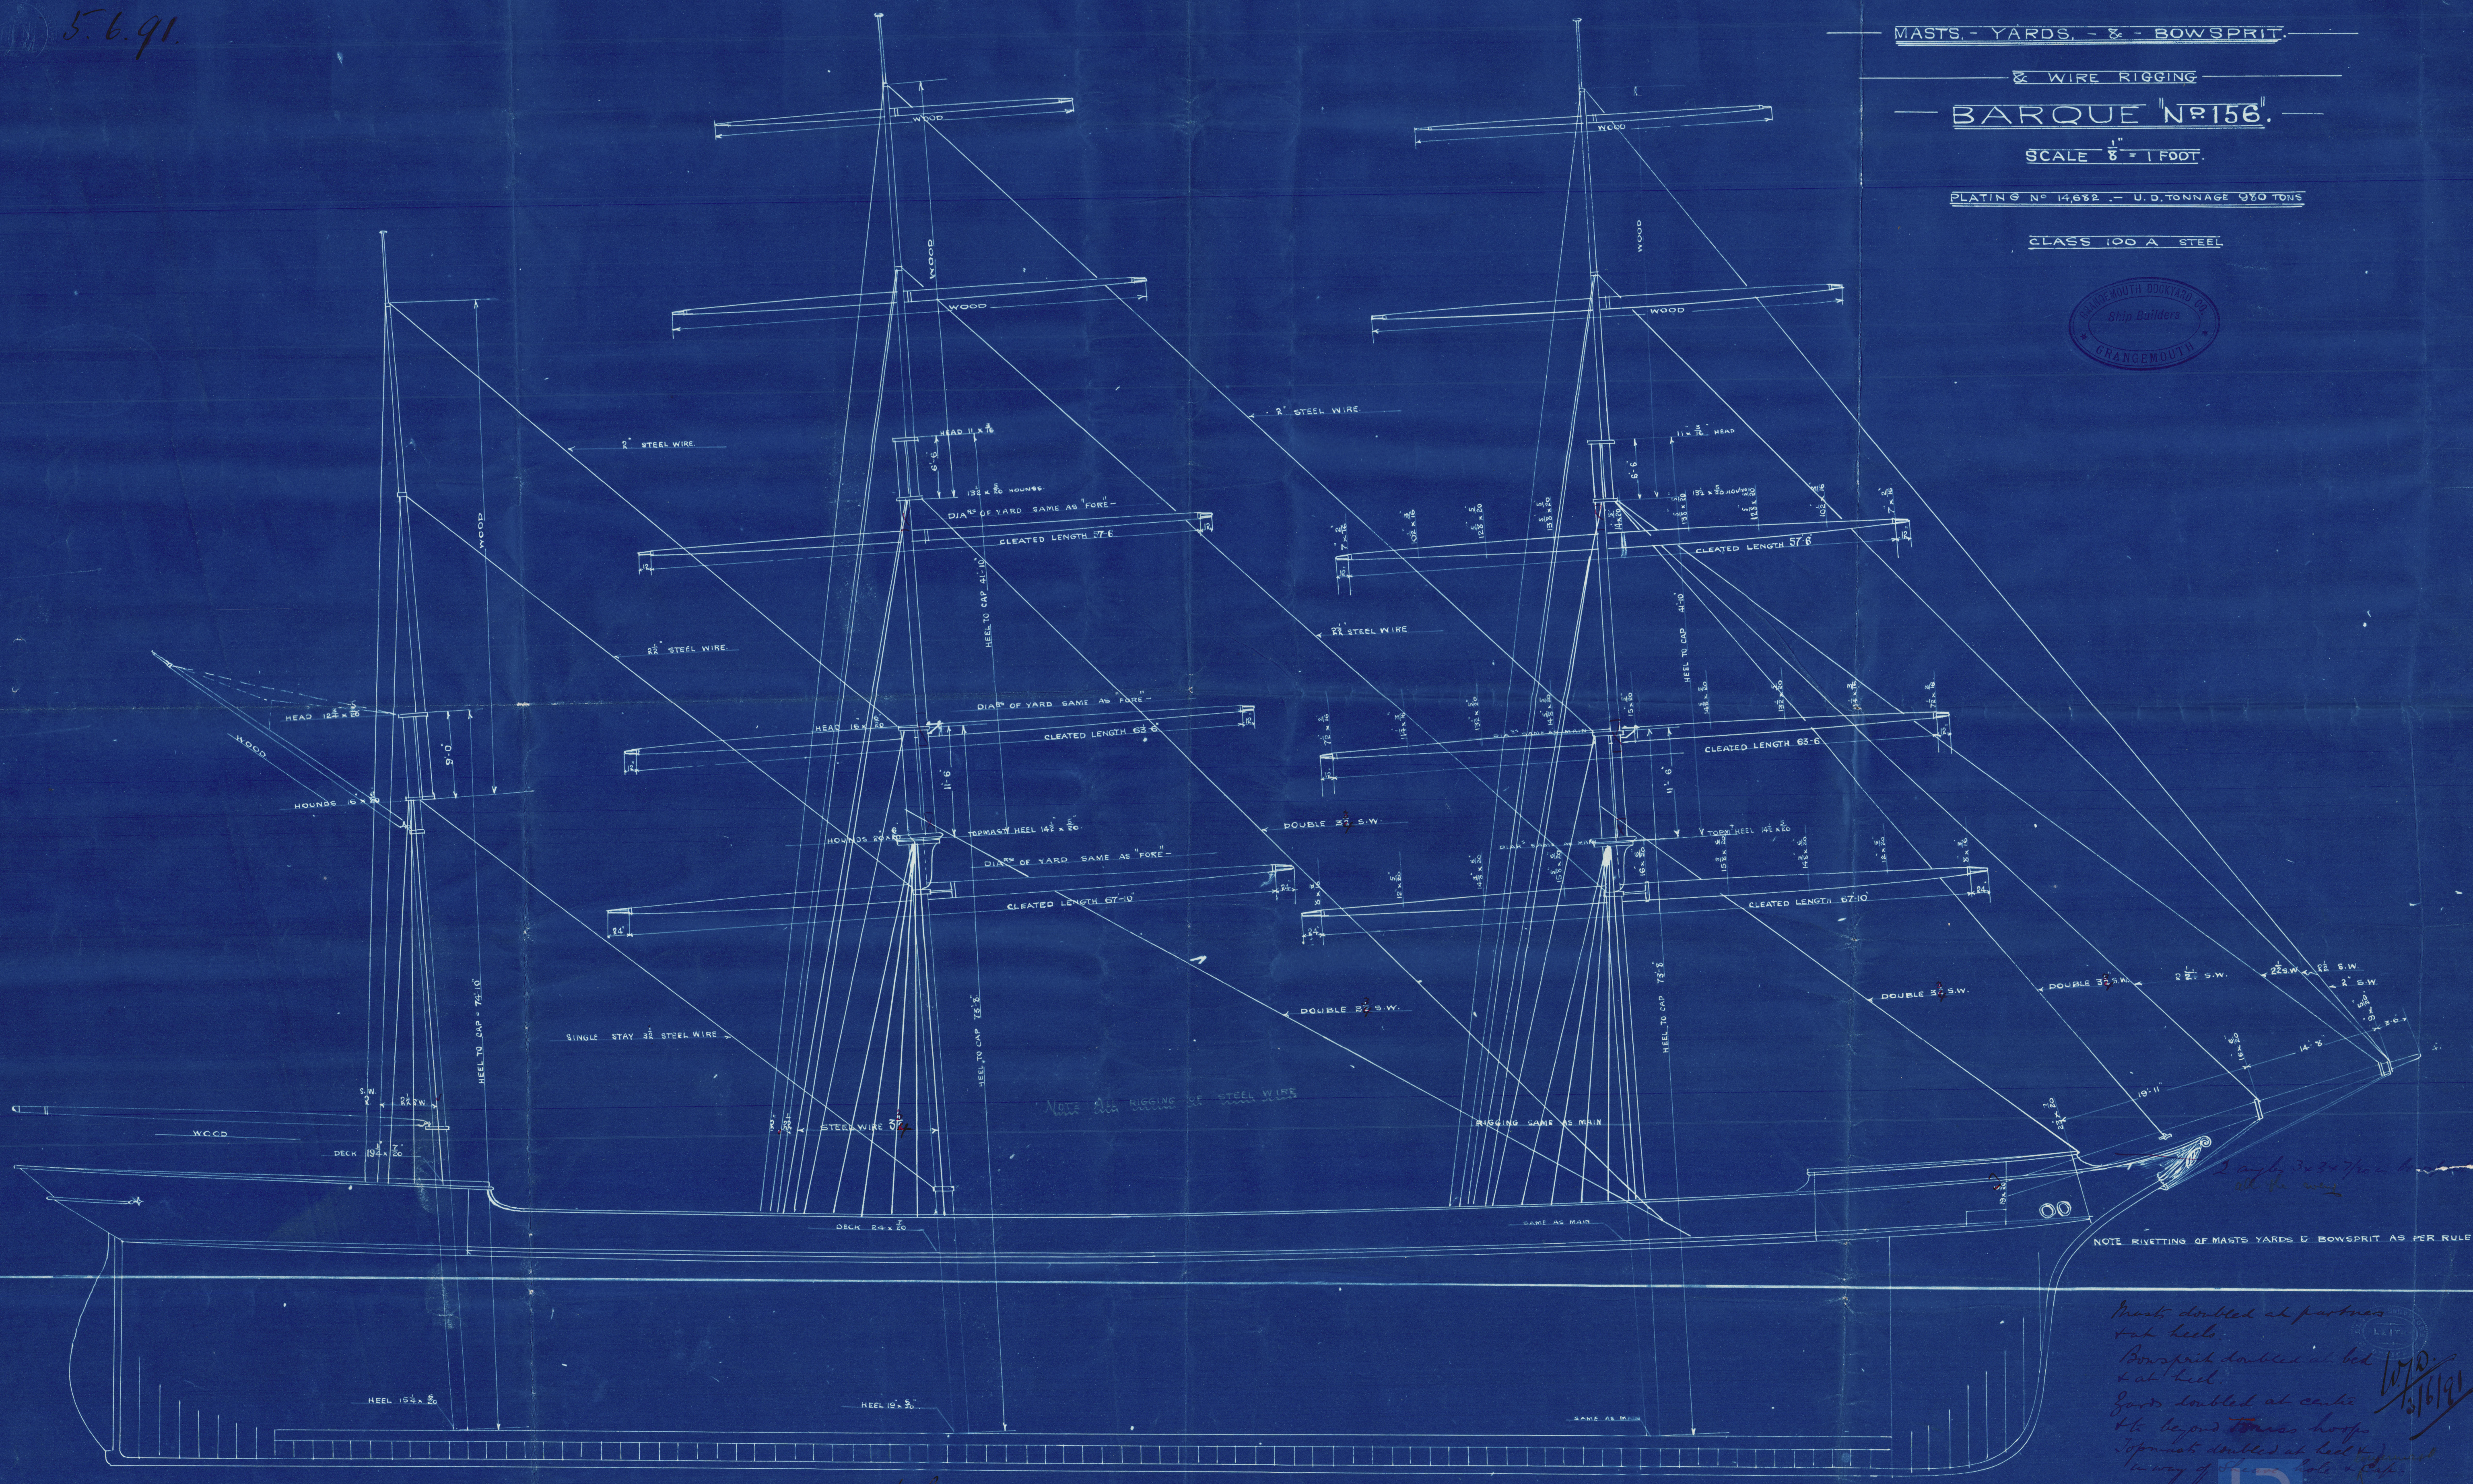

MASTS, - YARDS, - & - BOWSPRIT.


& WIRE RIGGING

BARQUE "N°156."

SCALE $\frac{1}{8}$ " = 1 FOOT.

PLATING N° 14882 - U.D. TONNAGE 980 TONS

CLASS 100 A STEEL

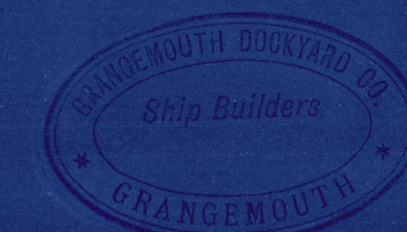

NOTE ALL RIGGING OF STEEL WIRE

NOTE RIVETTING OF MASTS YARDS & BOWSPRIT AS PER RULE.

Masts doubled at partures
at heels.
Bowsprit doubled at heel
at heel.
Gords doubled at carke
to be good to mass hoops
Topmast doubled at heel to
in way of steel wire & rope.



LTH 561-0089

LTH564-0089(112)

September 7th 1891

GRANGEMOUTH DOCKYARD CO.,
GRANGEMOUTH AND ALLOA.

This Enclosure is to be Sent to

Ships No. 156

Wm. Paulsen Esq.

Tracing No. 80

Leith

5.6.91.




© 2020

Foundation

BR. "Primus"

Lth. Report. No 6789

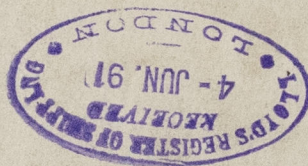

© 2020

Lloyd's Register
Foundation

LTH 561-0089