

22.5.86
19.11.91



N:162


N:162 "Marco Polo"
Lm. Rept. N:

— STEEL SAILING BARQUES Nos 162 & 163 —

— DIMENSIONS 240'-0" x 38'-0" x 23'-9" MLD x 22'-3" HOLD —

— CLASS 100 A1 AT LLOYDS. —

— SCALE 1/8" INCH = ONE FOOT —

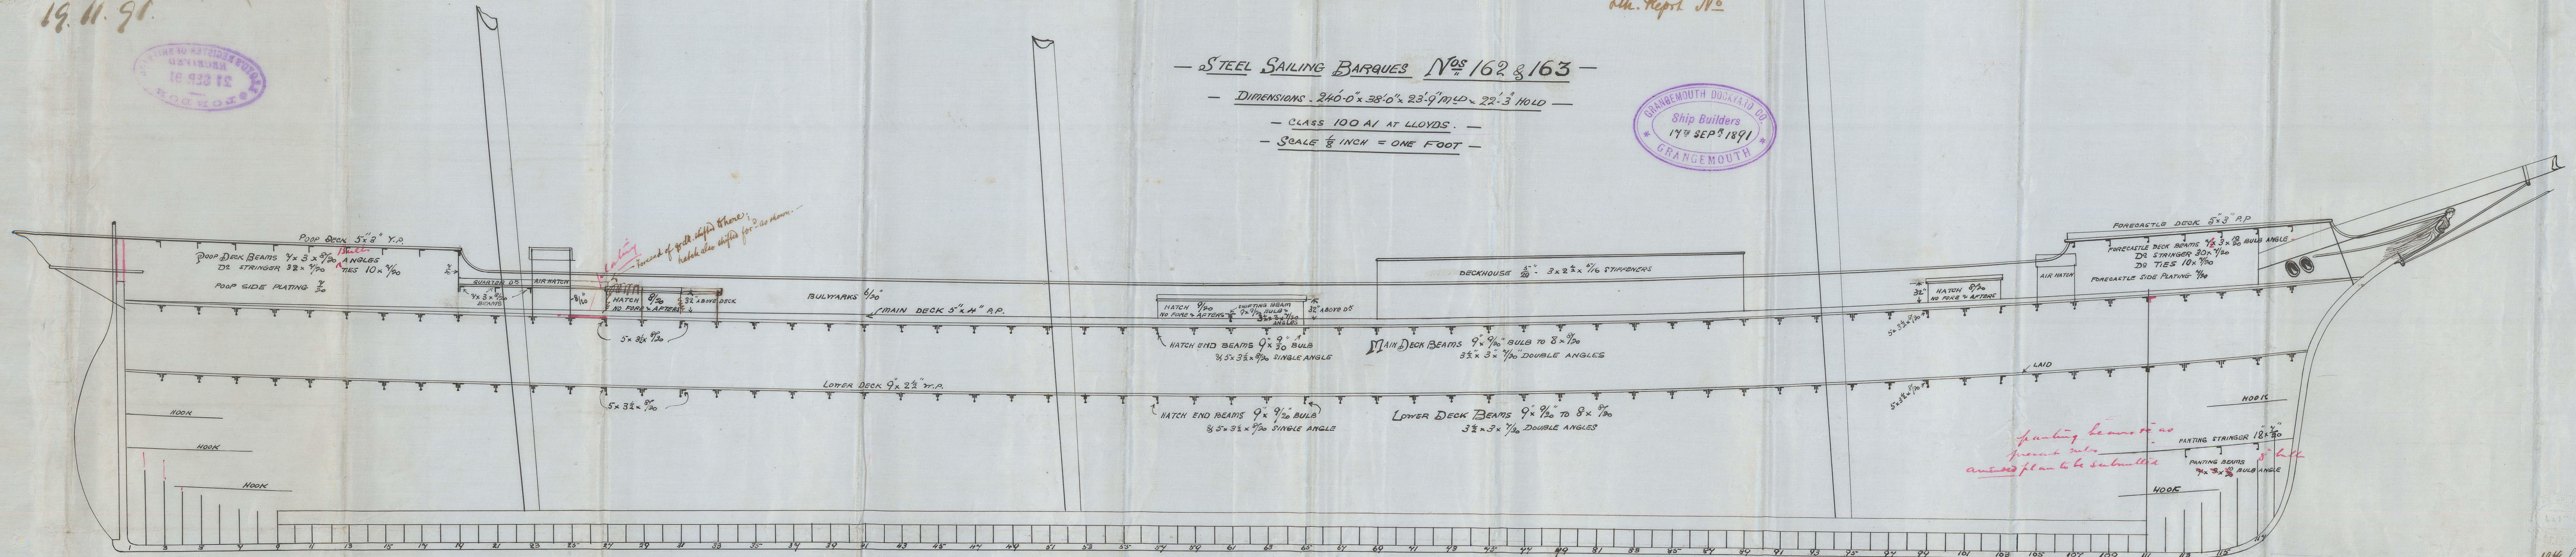

Painting beams as present into amended plan to be submitted



1944 Rept. 1891
22/9/91



LTH 562-0044

N^o 162 "Marco Polo"

Lth. Rept. N^o 6922

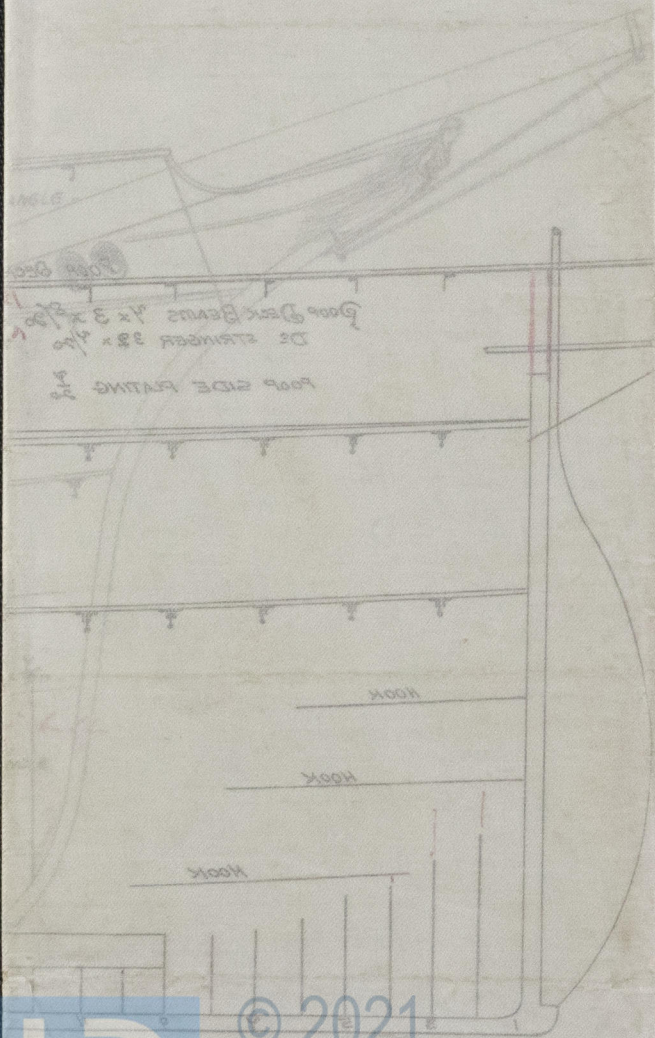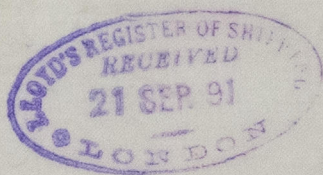

© 2021

Lloyd's Register
Foundation

LTH 562-0044