
 


TH562-0045

162x163 Mid. Lat.


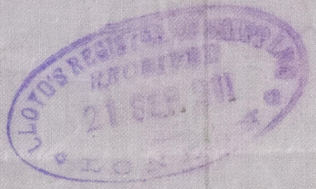


162x163 Mid. Lat.

No. 162 "Marco Polo"
Sta. Reg. No. 6922

LTH 562-075

162x163

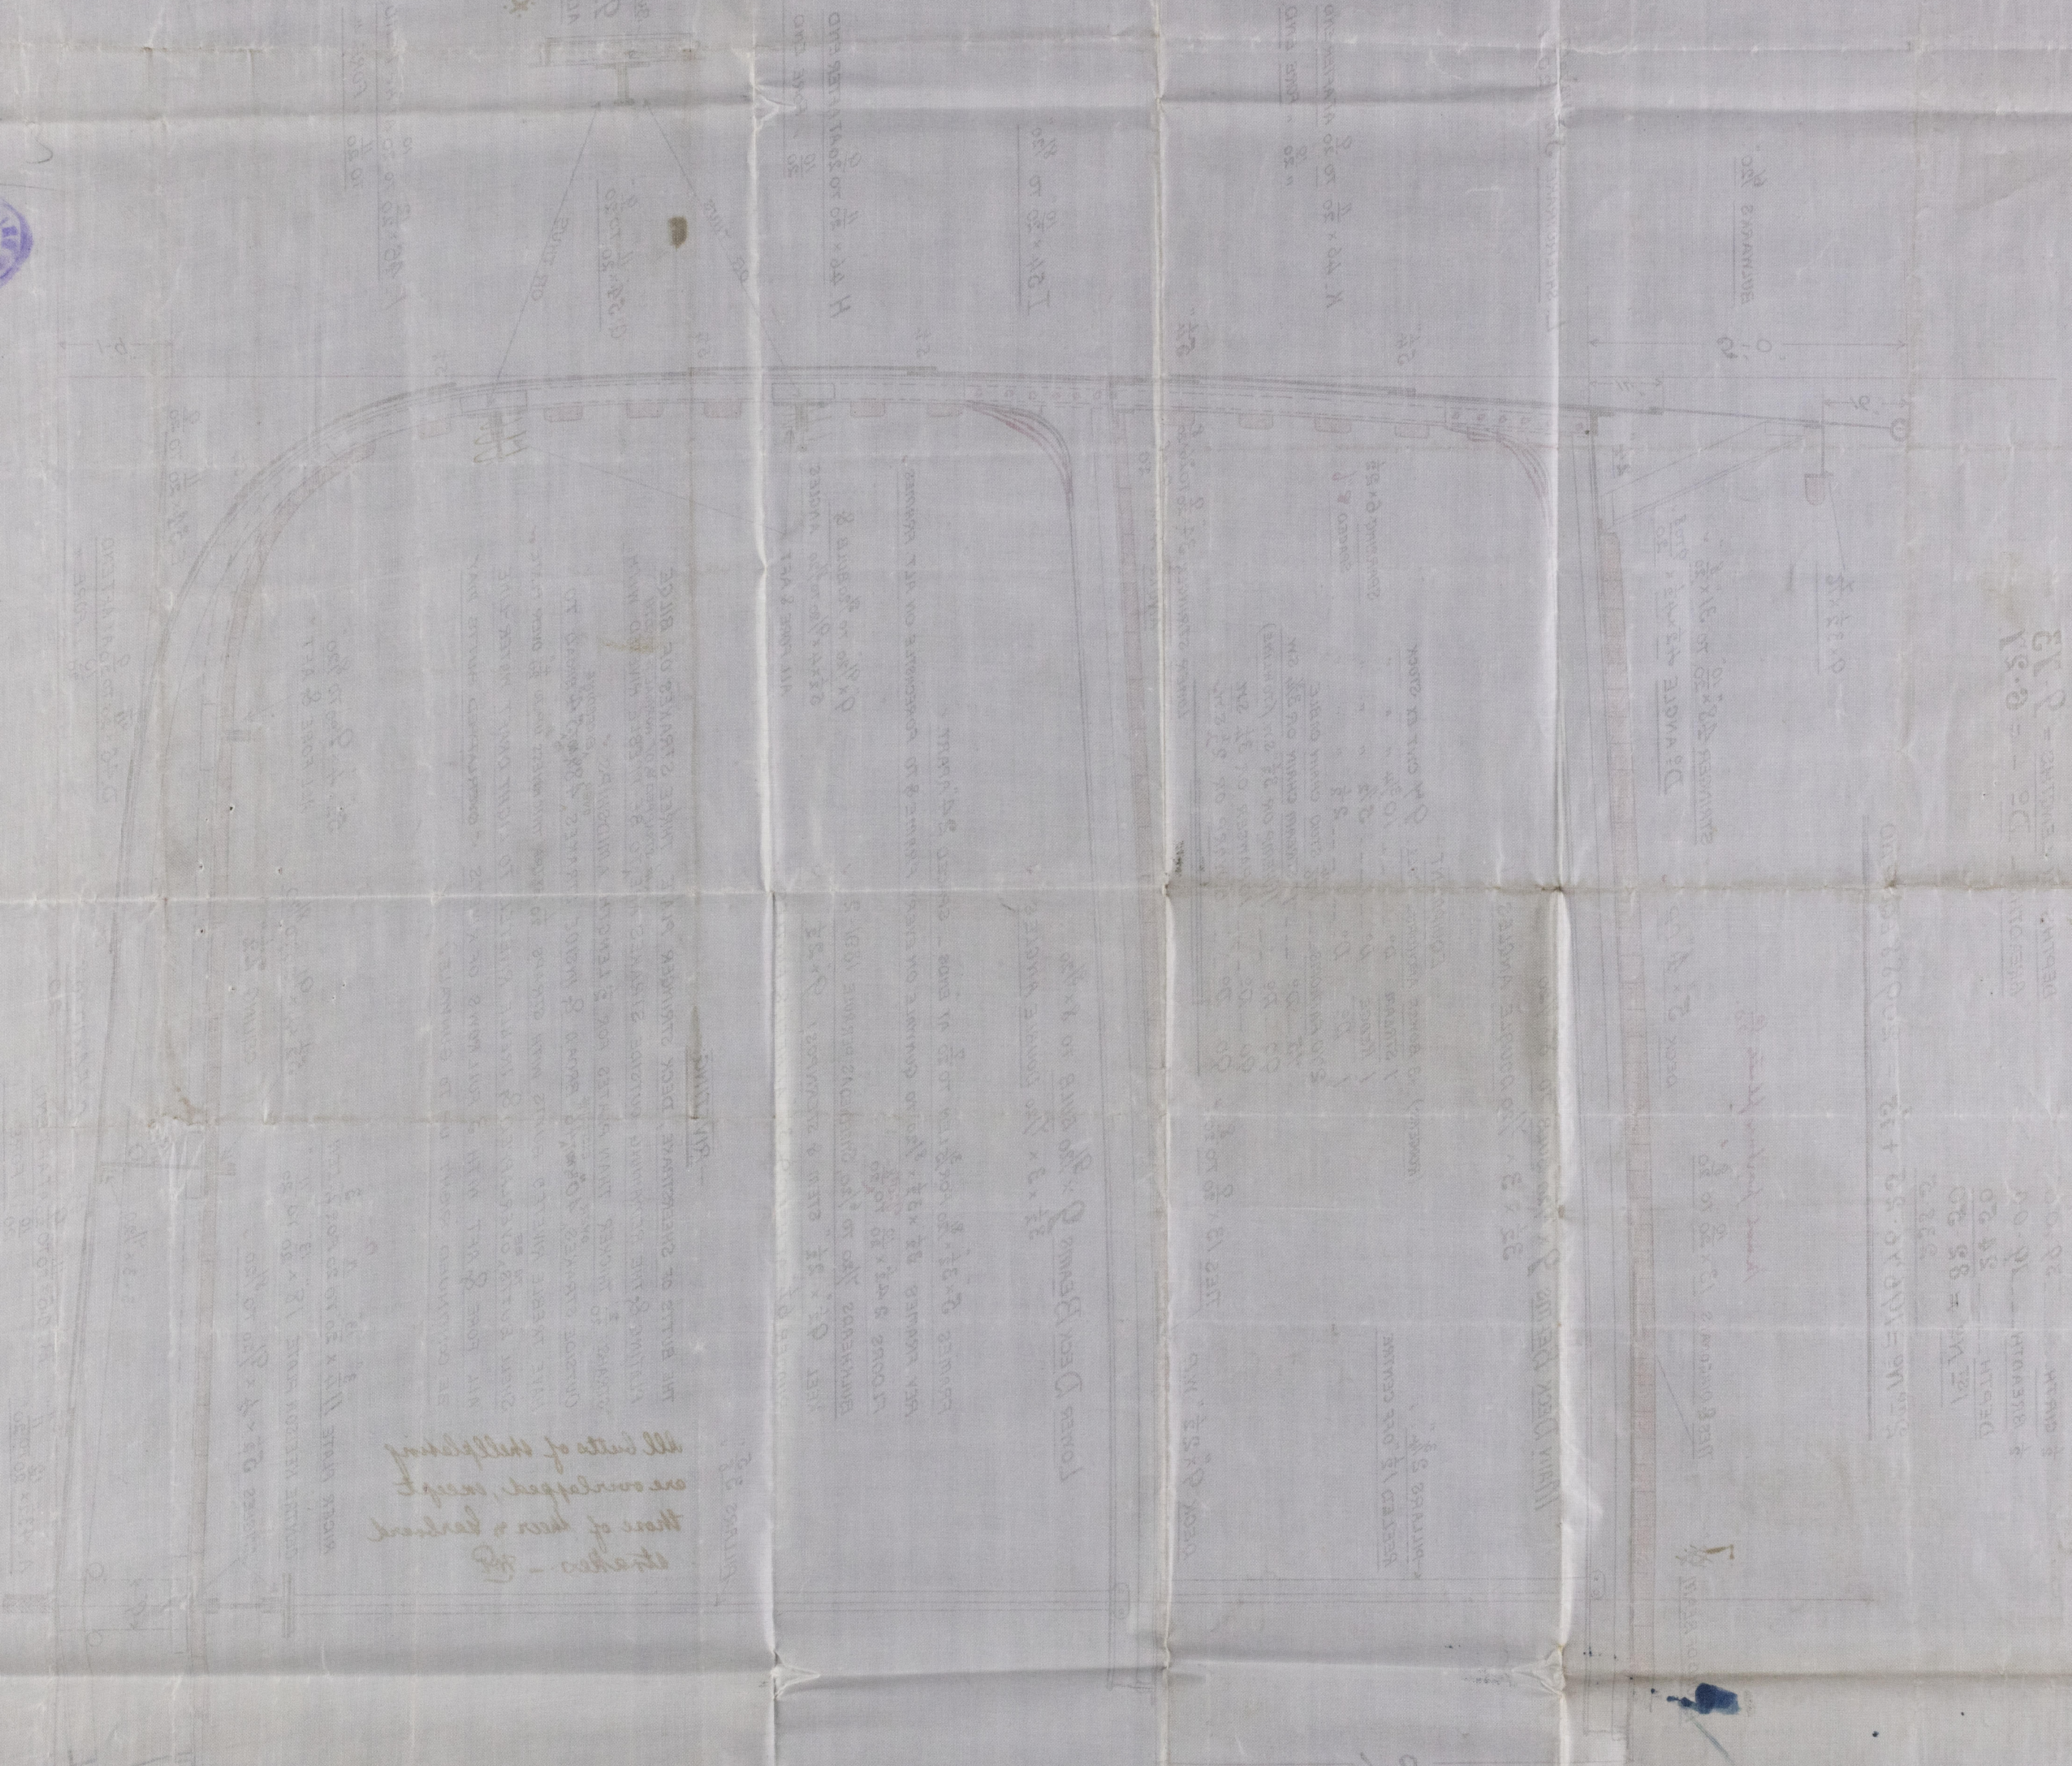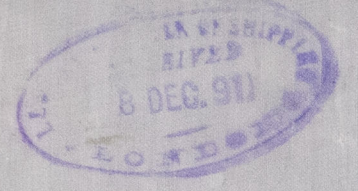

