





19.10.91.

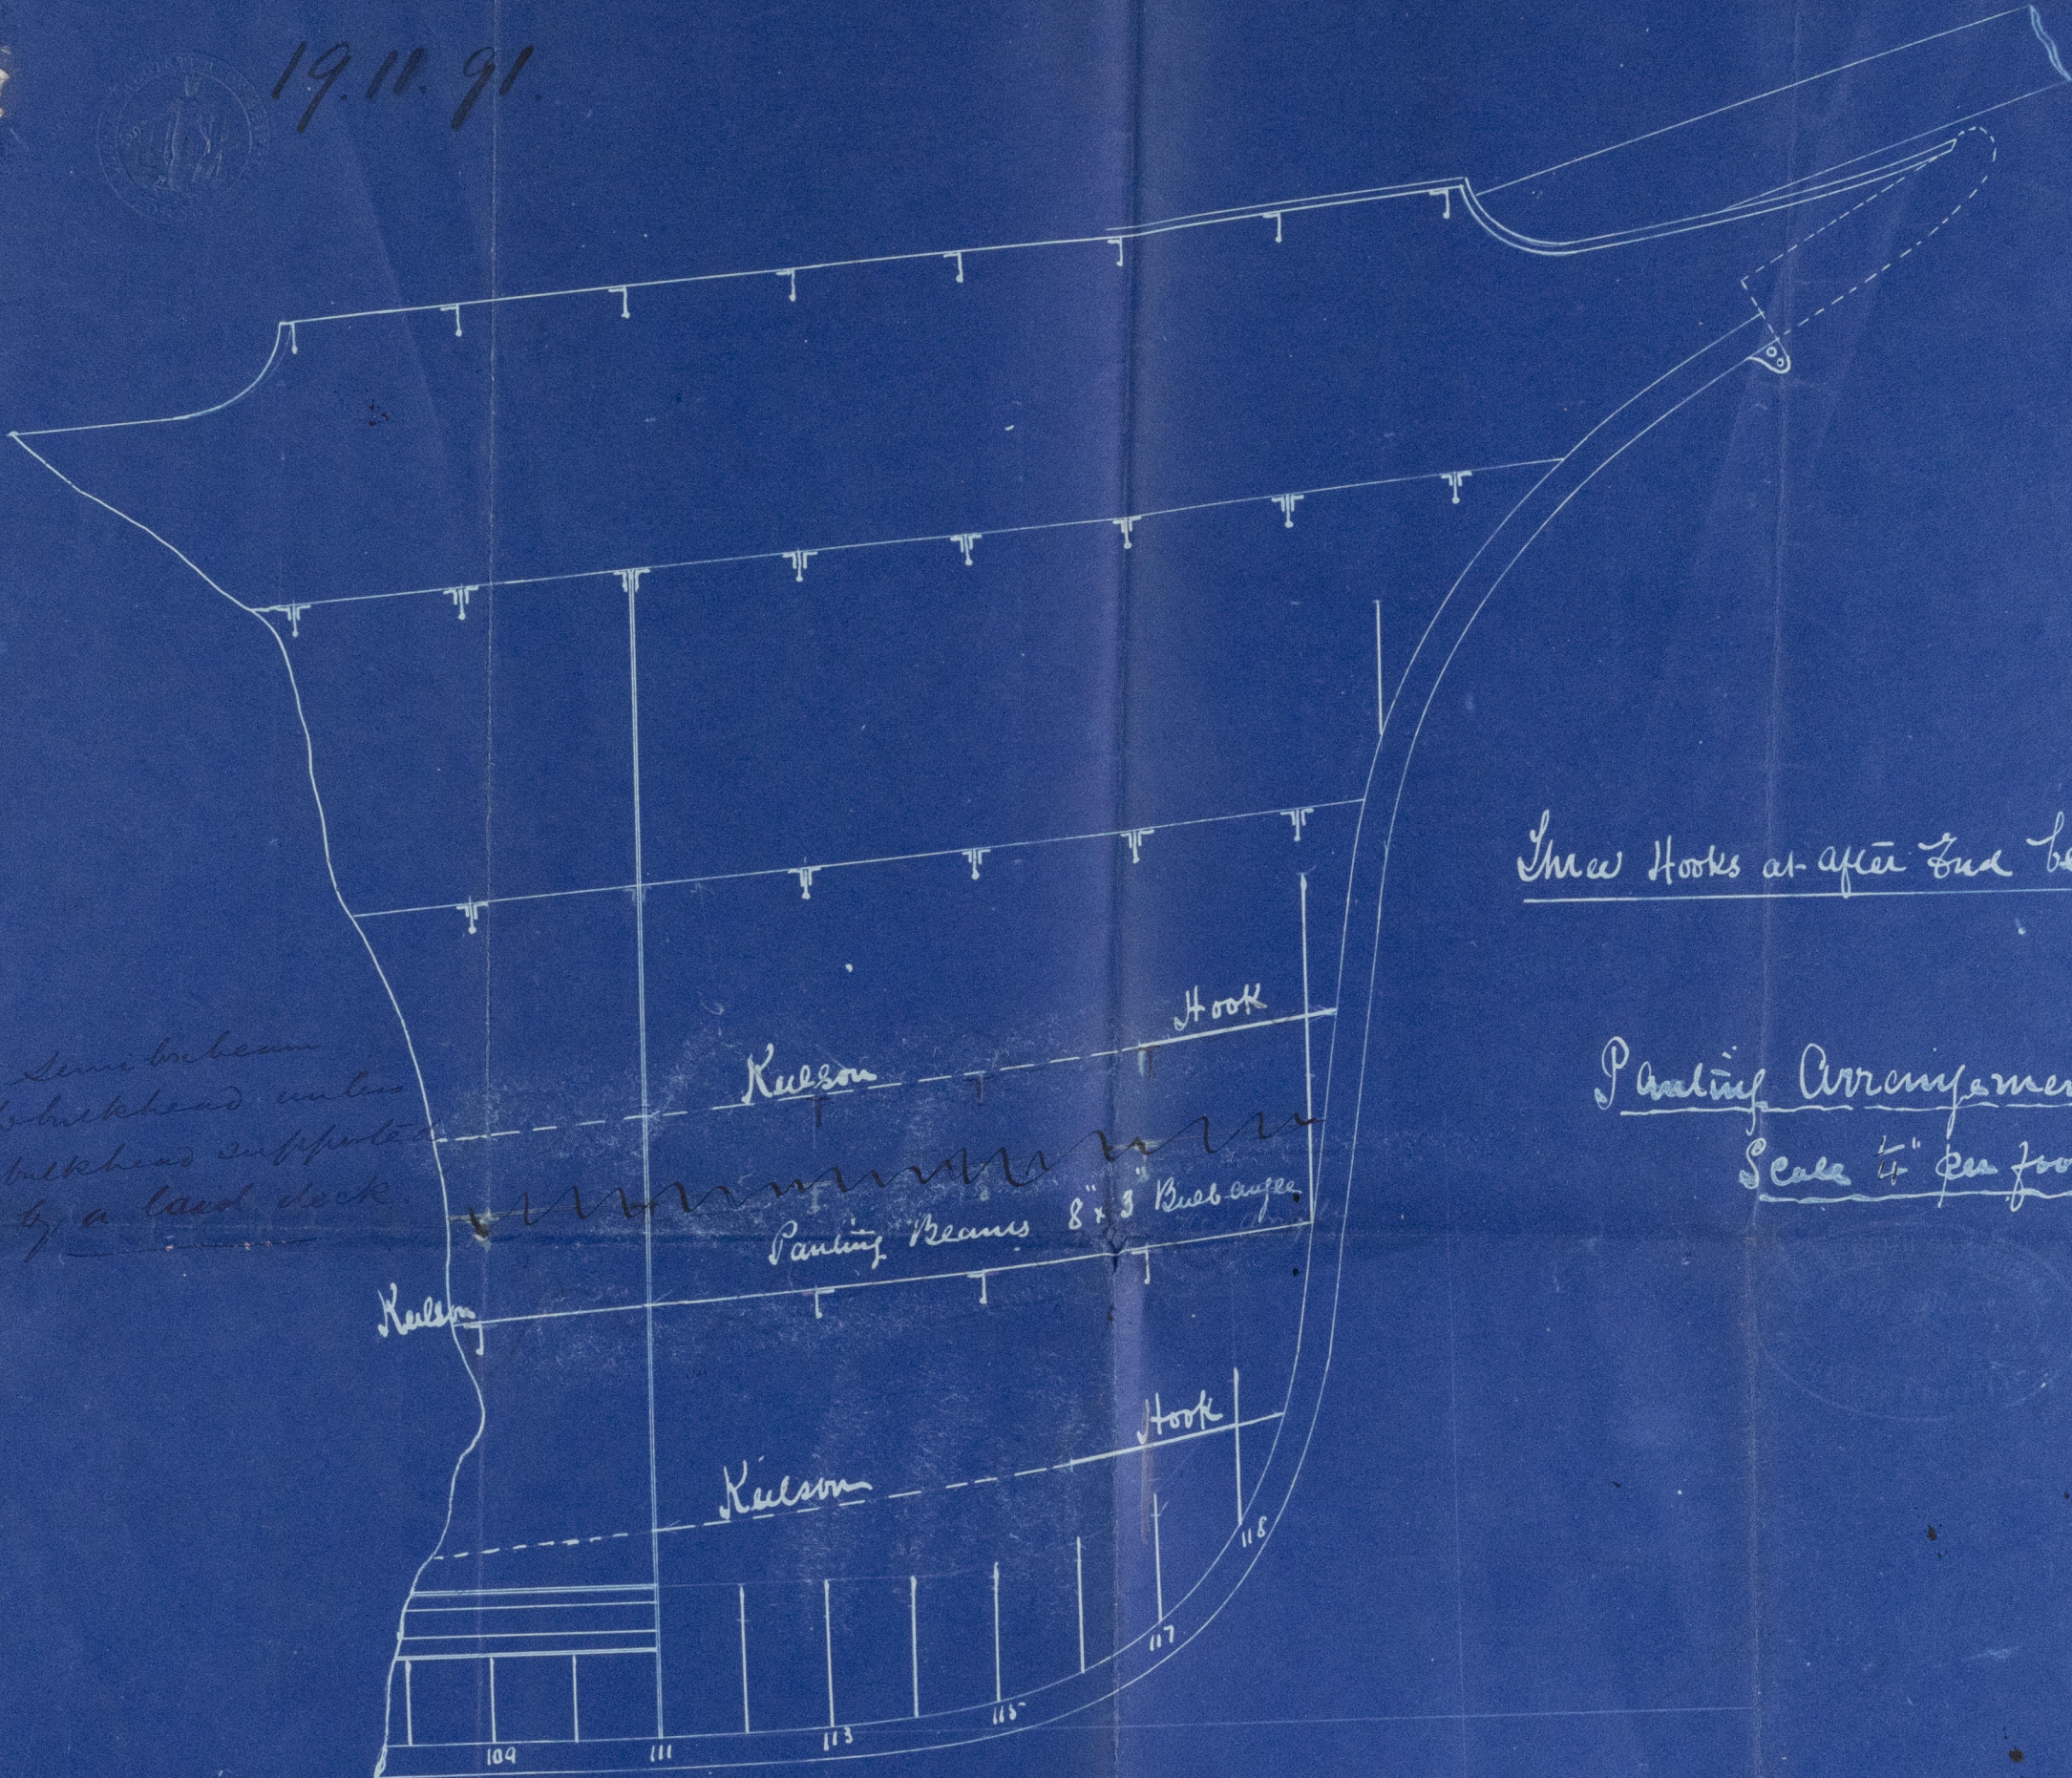

Three Hooks at after End below Tween Deck

Plating Arrangement - No. 162-3
Scale 1/4" per foot

Some beams
to bulkhead under
bulkhead supported
by a load deck.

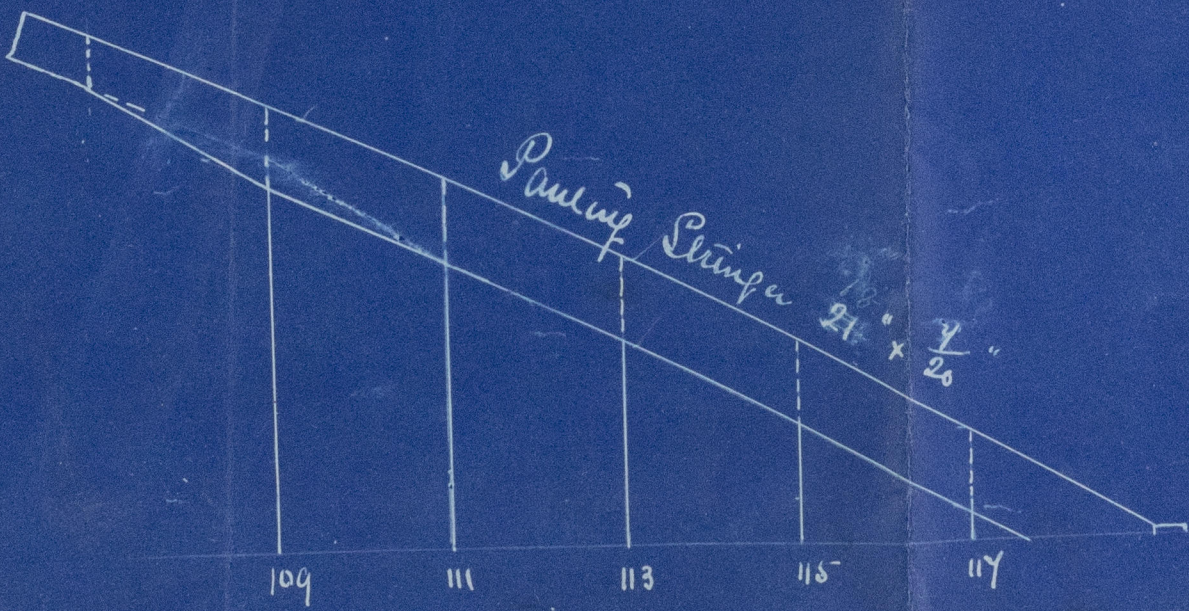

J.H.B.
19/11/91



17th Nov 91
J.H.B.

LTH 562-0050

BK. "Marco Polo"
Lth. Rept 6922



© 2019

Lloyd's Register
Foundation

LTH 562-0050