

## Lloyd's Register of British and Foreign Shipping.

(Report on Vessel No. 6922 Port Leith)No. 118

## SHIP FORGINGS OR CASTINGS.

I have to report that the undermentioned Iron or Steel Forgings or Castings, manufactured by

The Life Forge Co. of North Shieldsfor the Vessel No. 162, being built by Graysmouth Dryd: Co  
of Graysmouth have been inspected by me as set forth below, and found  
to be, so far as can be seen, sound forgings

The words FORGINGS or CASTINGS, IRON or STEEL, should be struck out as may be required.


Mark on Forgings.

Lloyd's

No. 113W.J.D.W. J. Darling.Leith.10/- Expenses Chargeable at Leith.

	STERN FRAME.	RUDDER FRAME.	STEM.
Material* - - - -	<u>Scrap iron</u>		
How made - - - -	<u>Forged &amp; smithed</u>		
Dimensions - - - -	<u>9" x 2 1/2"</u>		
Progress on Inspection -	<u>Forged &amp; finished</u>		
Dates when Inspected	<u>From Novbr 10 to Decbr 11</u> <u>1891, 5 visits. -</u>		

SKETCHES OF FRAMES SHEWING POSITION AND DESCRIPTION OF WELDS OF FORGINGS, OR PARTICULARS OF TESTS APPLIED TO CASTINGS.

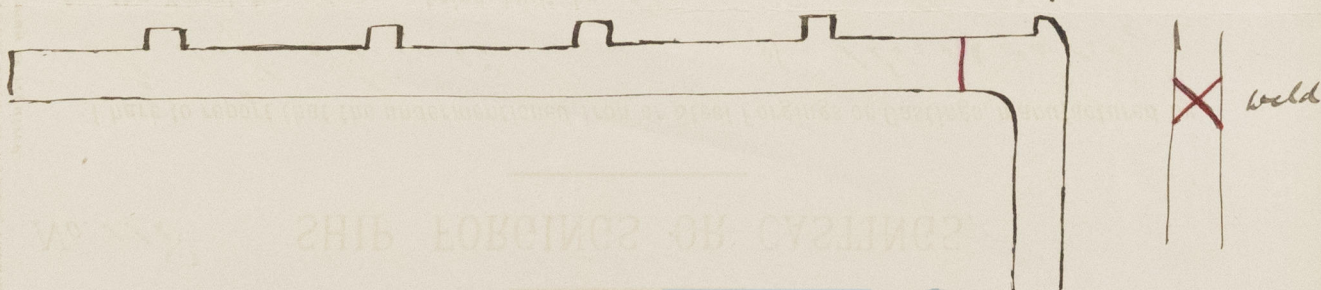



Bk. "Marco Polo"  
Lth. Rept. № 6922



© 2019

Lloyd's Register  
Foundation