

Lloyd's Register of British and Foreign Shipping.

Litt

(Report on Vessel No. 6922 Port Leith)

No. 2235.a

SHIP FORGINGS OR CASTINGS.

The words FORGINGS or CASTINGS, IRON or STEEL, should be struck out as may be required.

I have to report that the undermentioned Iron or Steel Forgings or Castings, manufactuerd by

Mr Thomas Ray

of Pallin

for the Vessel No. 112, being built by The Grangemouth Dockyard Co

of Grangemouth have been inspected by me as set forth below, and found

to be, so far as can be seen, sound.

Mark on Forgings.

Lloyd's
No. 2235.a
116



Wm Cameron

Sundaland

5.5.92


	STERN FRAME.	RUDDER FRAME.	STEM.
Material*		<i>Scrap iron</i>	
How made		<i>faced</i>	
Dimensions		<i>6 1/2 - 3 1/2</i>	
Progress on Inspection		<i>faced & smithed</i>	
Dates when Inspected		<i>Feb 24 to April 12/92</i>	

SKETCHES OF FRAMES SHEWING POSITION AND DESCRIPTION OF WELDS OF FORGINGS, OR PARTICULARS OF TESTS APPLIED TO CASTINGS.

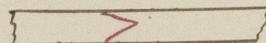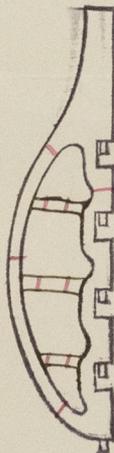

Wills

© 2019

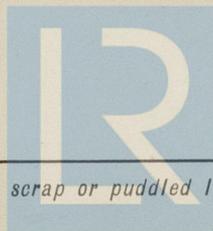

Lloyd's Register
Foundation

* If of Iron, state whether scrap or puddled Iron.

2235

Bk. "Marco Polo"
Lth. Report No. 6922



© 2019

Lloyd's Register
Foundation