

No 14 "Rob the Ranter" Lth. Rpt. No 6950

No 15

Midship Section of Wood Steam Fishing Boat, to class 9 & 4 "for fishing purposes"


21.11.91.

Scale Half inch to Foot

Length of Keel 88 Feet

Breadth moulded 18 "

Depth " 9 " 9 in.

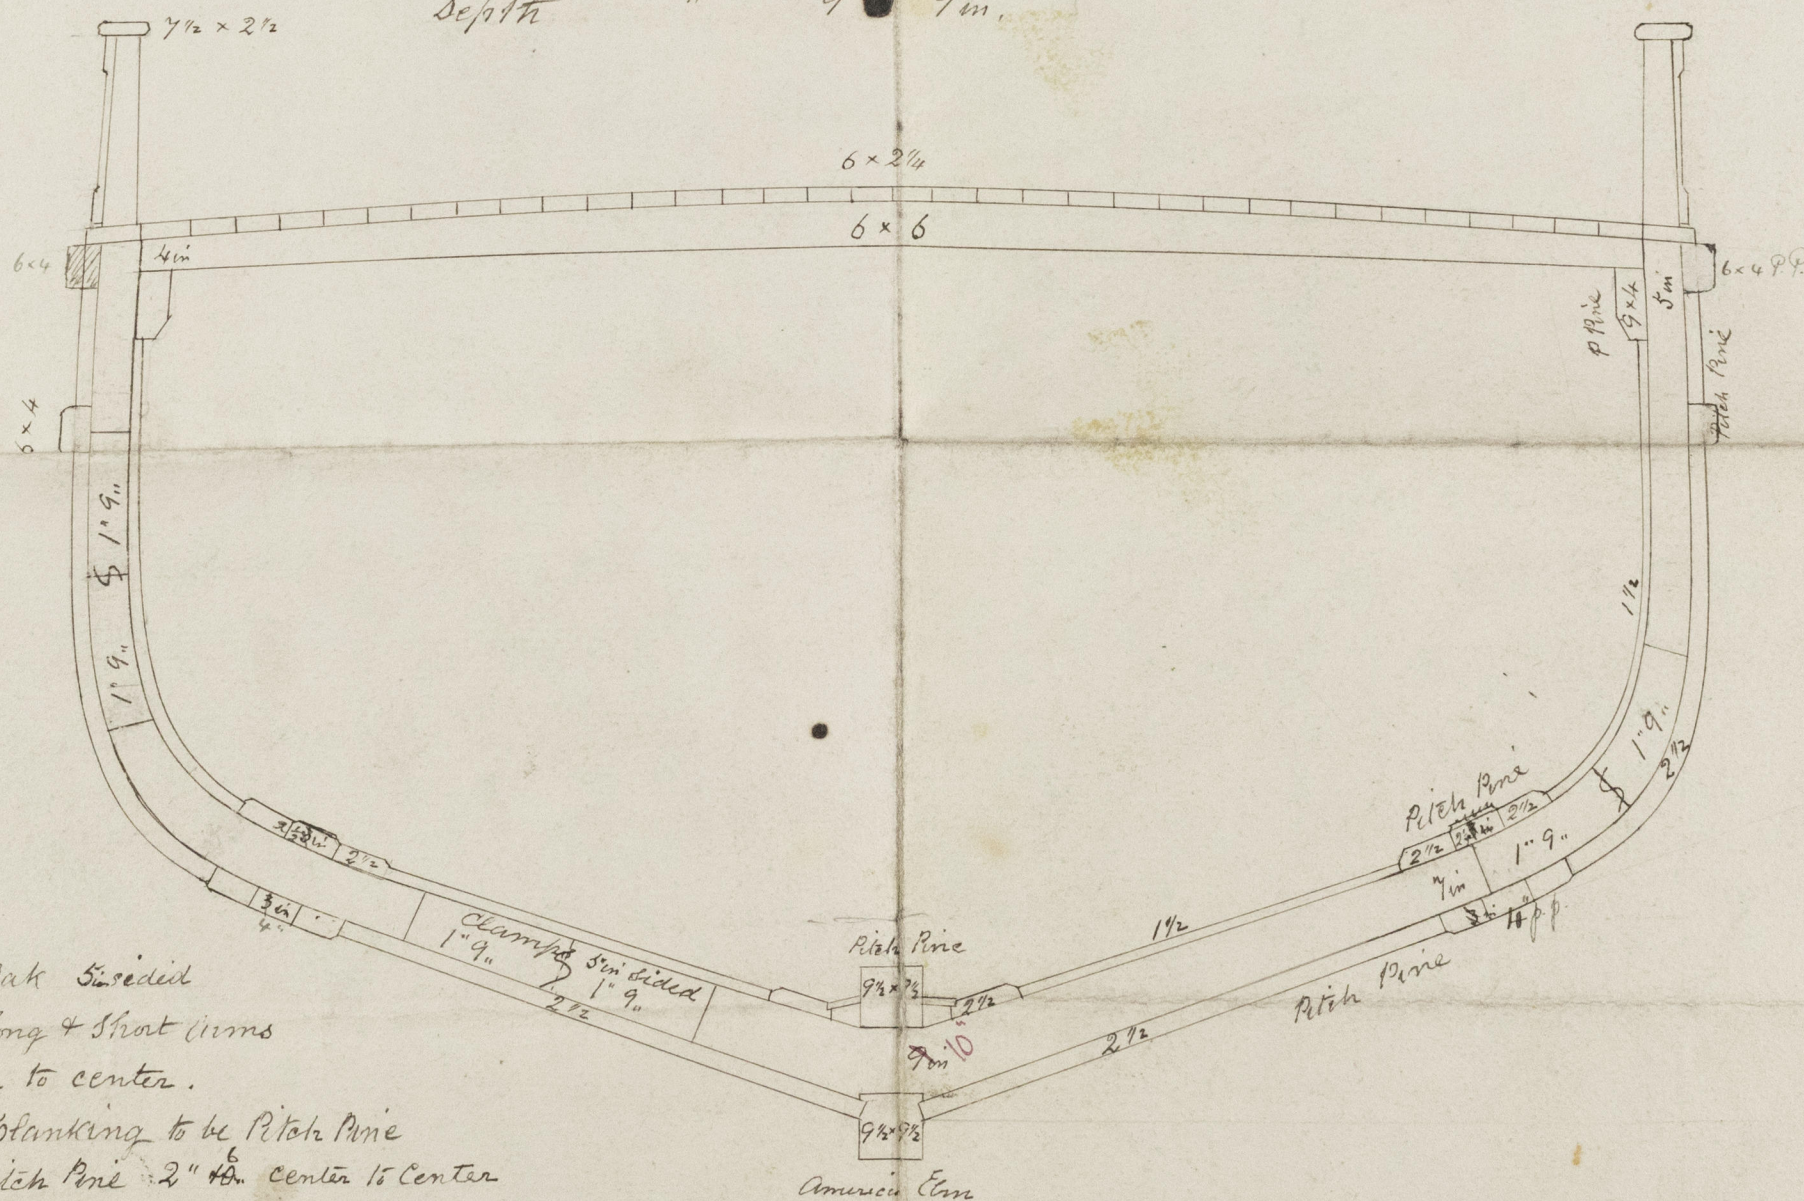

Timbers English Oak 5-sided
built square with long & short arms
set 15 in from center to center.

Outside and inside planking to be Pitch Pine
Beams of Larch or Pitch Pine 2" 6 in center to center

Decks Pitch Pine 6" x 2 1/4"

All Beams kneeded with wood or iron
Seven long knees on side to bridge plank.

Stem & stern Post 8 1/2 sided Rudder Post 8 in

Dead wood (Elm or Beech not more than 2 ft above rabbet of keel)

All center fastening Galvanized Iron


Outside fastening, Spikes short Bolts and through fastenings 2 1/2 and Galvanized through bolt in every 3rd timber in each side

Designed by
William Anstruther
Lloyd's Register
Foundation

LTH 562-0079

"Rob the Ranter"

Lth. Rept. No 6950

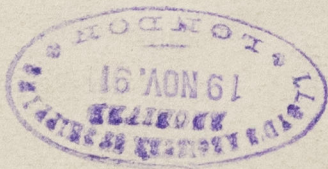

© 2019

Lloyd's Register
Foundation

LTH 562 - 0079