


25.2.92.

Barquentine
PROFILE PLAN OF SCHOONER N° 3 "Lillie"

- TO CLASS 100 A1 LLOYD'S (STEEL) -

Lth. Rep'd 7023.

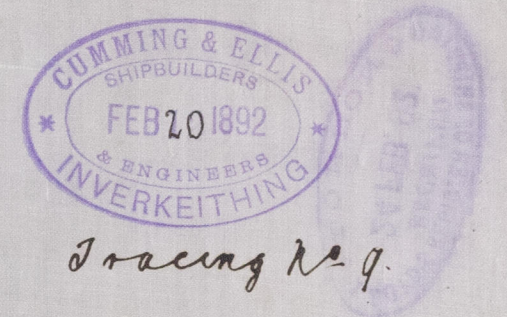

DIMENSIONS 140' BP X 27' X 11'-0 1/4" M^{LD} TO MD
SCALE 1/8" = ONE FOOT.

- POOP DECK -
2 1/2" R.P. BEAMS 5 x 3 x 5/20 ANGLE STEEL
STRINGER 16 x 5/20
TIE PLATES 6 x 5/20
SIDE PLATING 5/20
BAR 2 1/2 x 2 1/2 x 5/20



FORECASTLE DECK 2 1/2" R.P. BEAMS 5 x 3 x 5/20 ANGLE
STRINGER 16 x 5/20 ANGLE 2 1/2 x 2 1/2 x 5/20
TIE PLATES 6 x 5/20
SIDE PLATING 5/20

ALTERNATE REVERSE FRAMES RUN TO GUNWALE

DIAGONAL TIES FITTED IN WAY OF MASTS

*Strengthening in way of
heel of bowsprit & Lumsen's satisfaction*

PLANTING ARRANGEMENTS TO SURVEYOR'S SATISFACTION

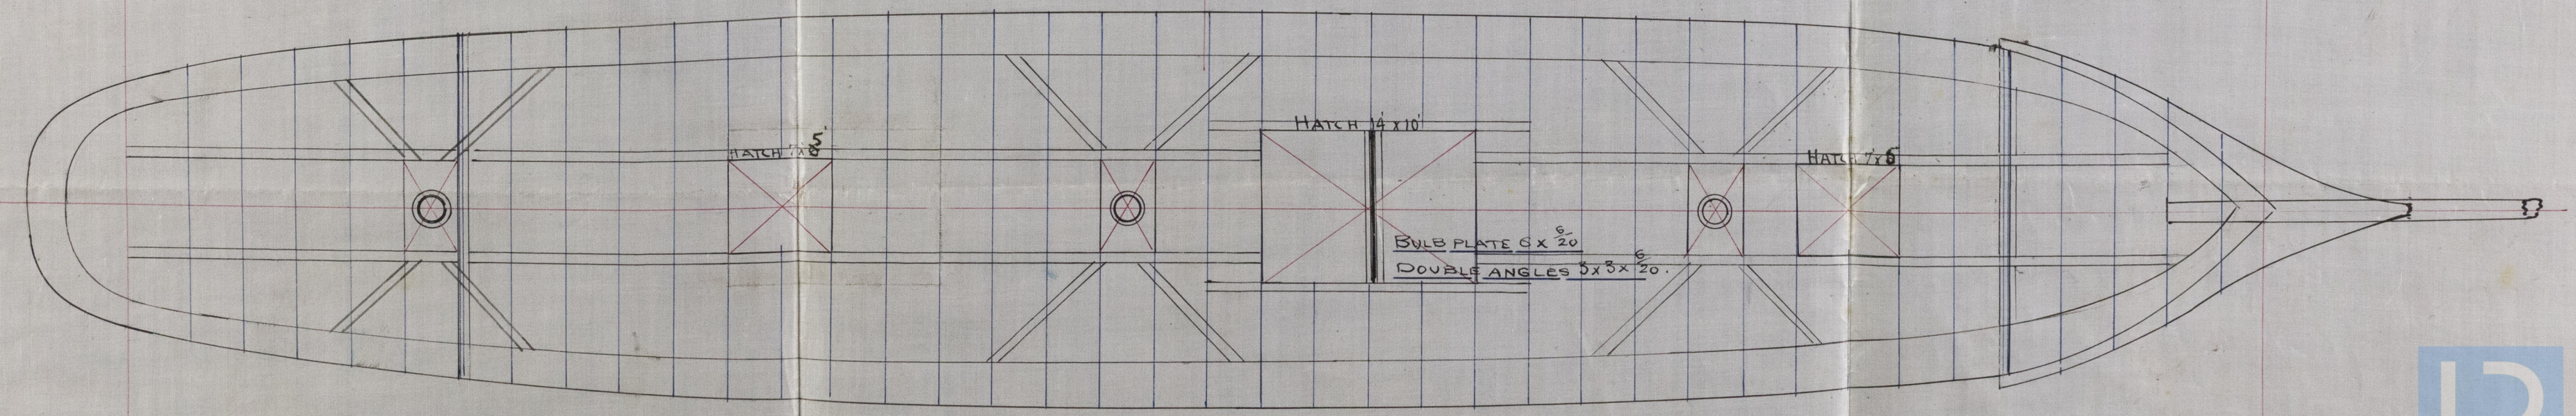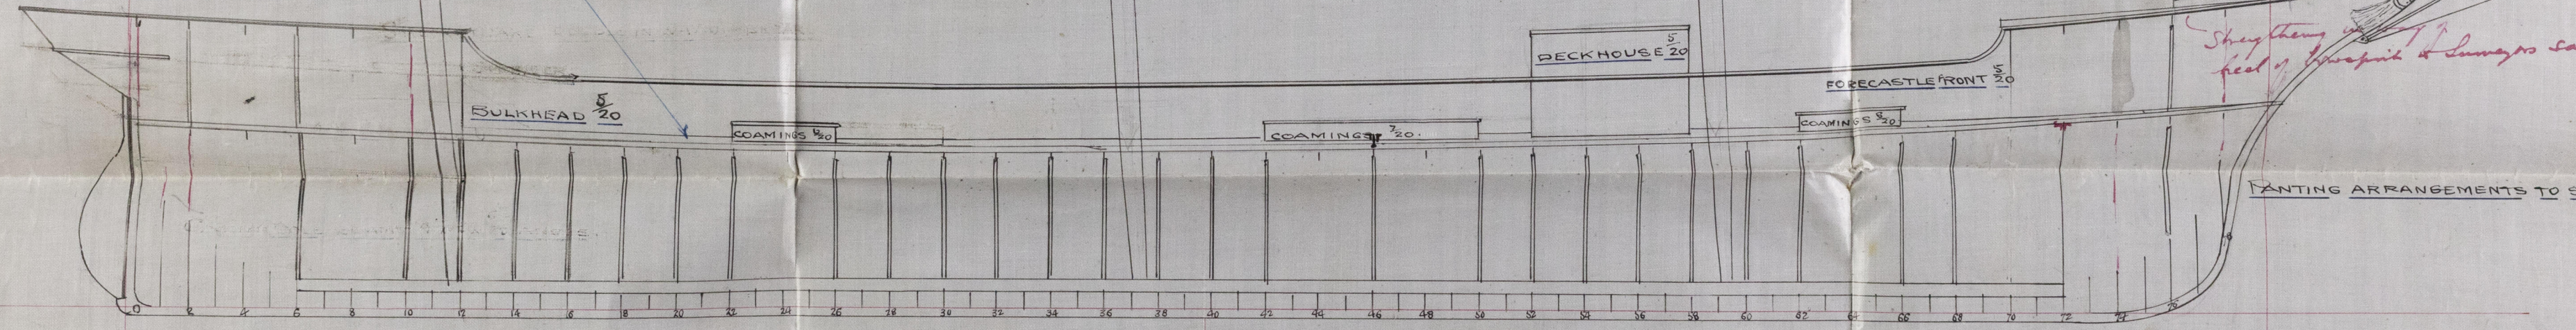

929/92

10/6
25/2/92

San. "Lillie"
Gen. Report 7023.

LT4562-0140

PROJECT PLAN OF SCHOONER "LILLIE"
TO CLASS 100 AT LLOYD'S (STEEL)
SCALE 1" = ONE FOOT

Lloyd's Register
Foundation

© 2011

24 FEB 1922