


25.2.92

MIDSHIP SECTION OF STEEL SCHOONER

TO CLASS 100 A1 AT LLOYD'S.

No 3. "Lillie"

Lth. Regt. No 7023

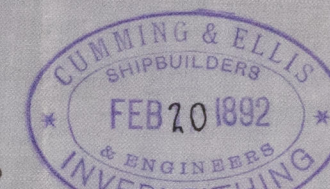

Drawing No 8.

SCALE $\frac{1}{2}$ " = ONE FOOT.

DIMENSIONS 140. B.P. X 27 X 11-04 MOULDED TO M.D.

LLOYD'S NUMERALS.

$\frac{1}{2}$ GIRTH = 21.62
 $\frac{1}{2}$ BREADTH = 13.50
 DEPTHS IN LENGTH = 11.98
 DEPTH = 11.60
 BREADTHS $\frac{D^0}{5.14}$
 $\frac{1}{2}$ NUMBER 46.72 X 138.96 = 6492.21 = 2ND NUMBER.

EQUIPMENT No 6925.02

3 BOWER ANCHORS COLLECTIVE WEIGHT 34 1/2 CWT
 1 STREAM D⁰ 4"
 1 KEDGE D⁰ 2"
 1 D⁰ D⁰ 1"
 195 FATHOMS 1/16 STUD CHAIN CABLE
 60 D⁰ 1/16 STREAM CHAIN OR 24 STEEL WIRE
 75 D⁰ 8" HEMP HAWSER
 90 D⁰ 5 1/2" D⁰ ✓

