
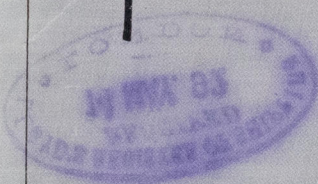


Ln 16.5.92

— BARQUENTINE No 3 — "Lillie" Lth. Regt. 2023


SKETCH SHEWING METHOD OF SECURING STERNPOST & RUDDER TRUNK

SCALE 1 INCH = 1 FOOT

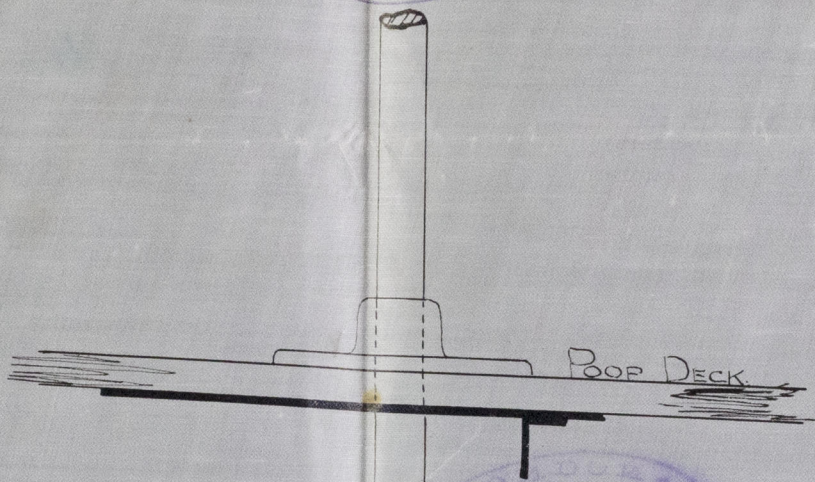

20.5.92
20.5.92

PLAN AT A.

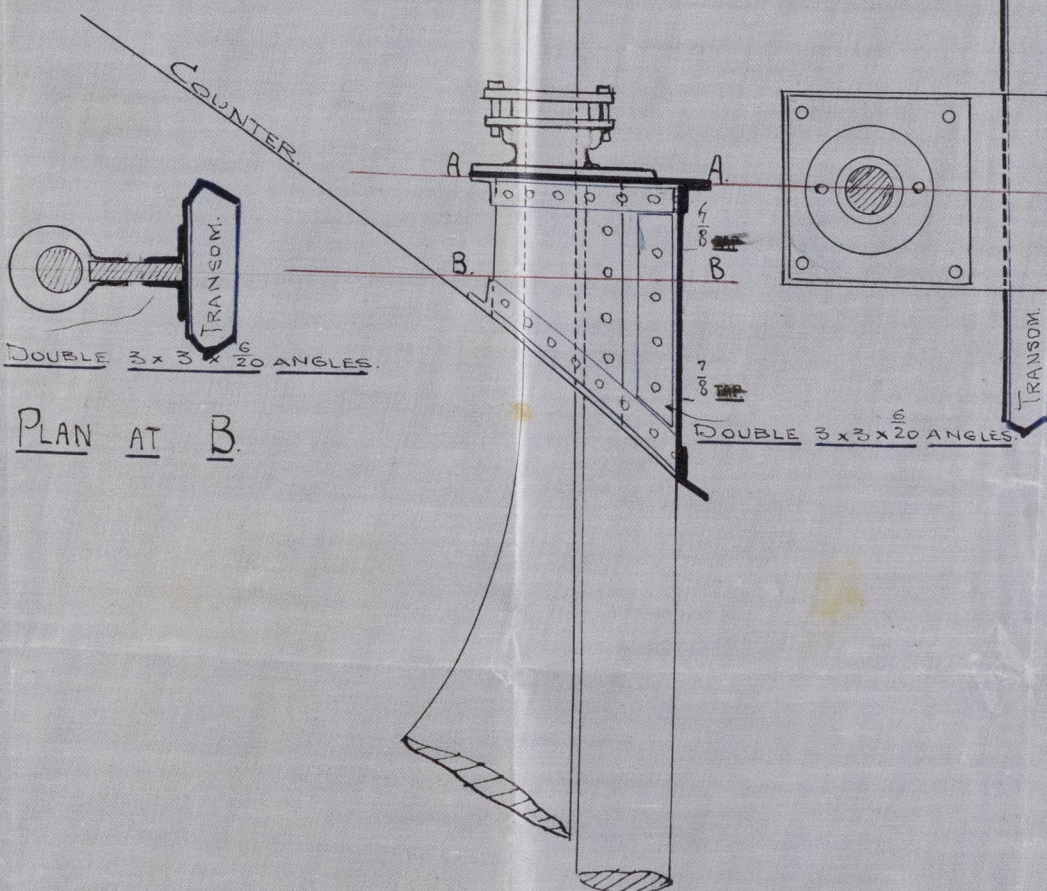

PLAN AT B.



13th May 1892
7.7.




Lloyd's Register
Foundation

LTH 562-0142

Bkn. 'Lillie'
Lth. Rept. 7023.




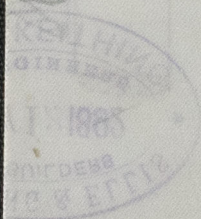

1 INCH = 1 FOOT

TO BE RECEIVED AT THE OFFICE OF THE LLOYD'S REGISTER OF SHIPPING

THE No 3



© 2019

Lloyd's Register
Foundation

LTH 562-0142