
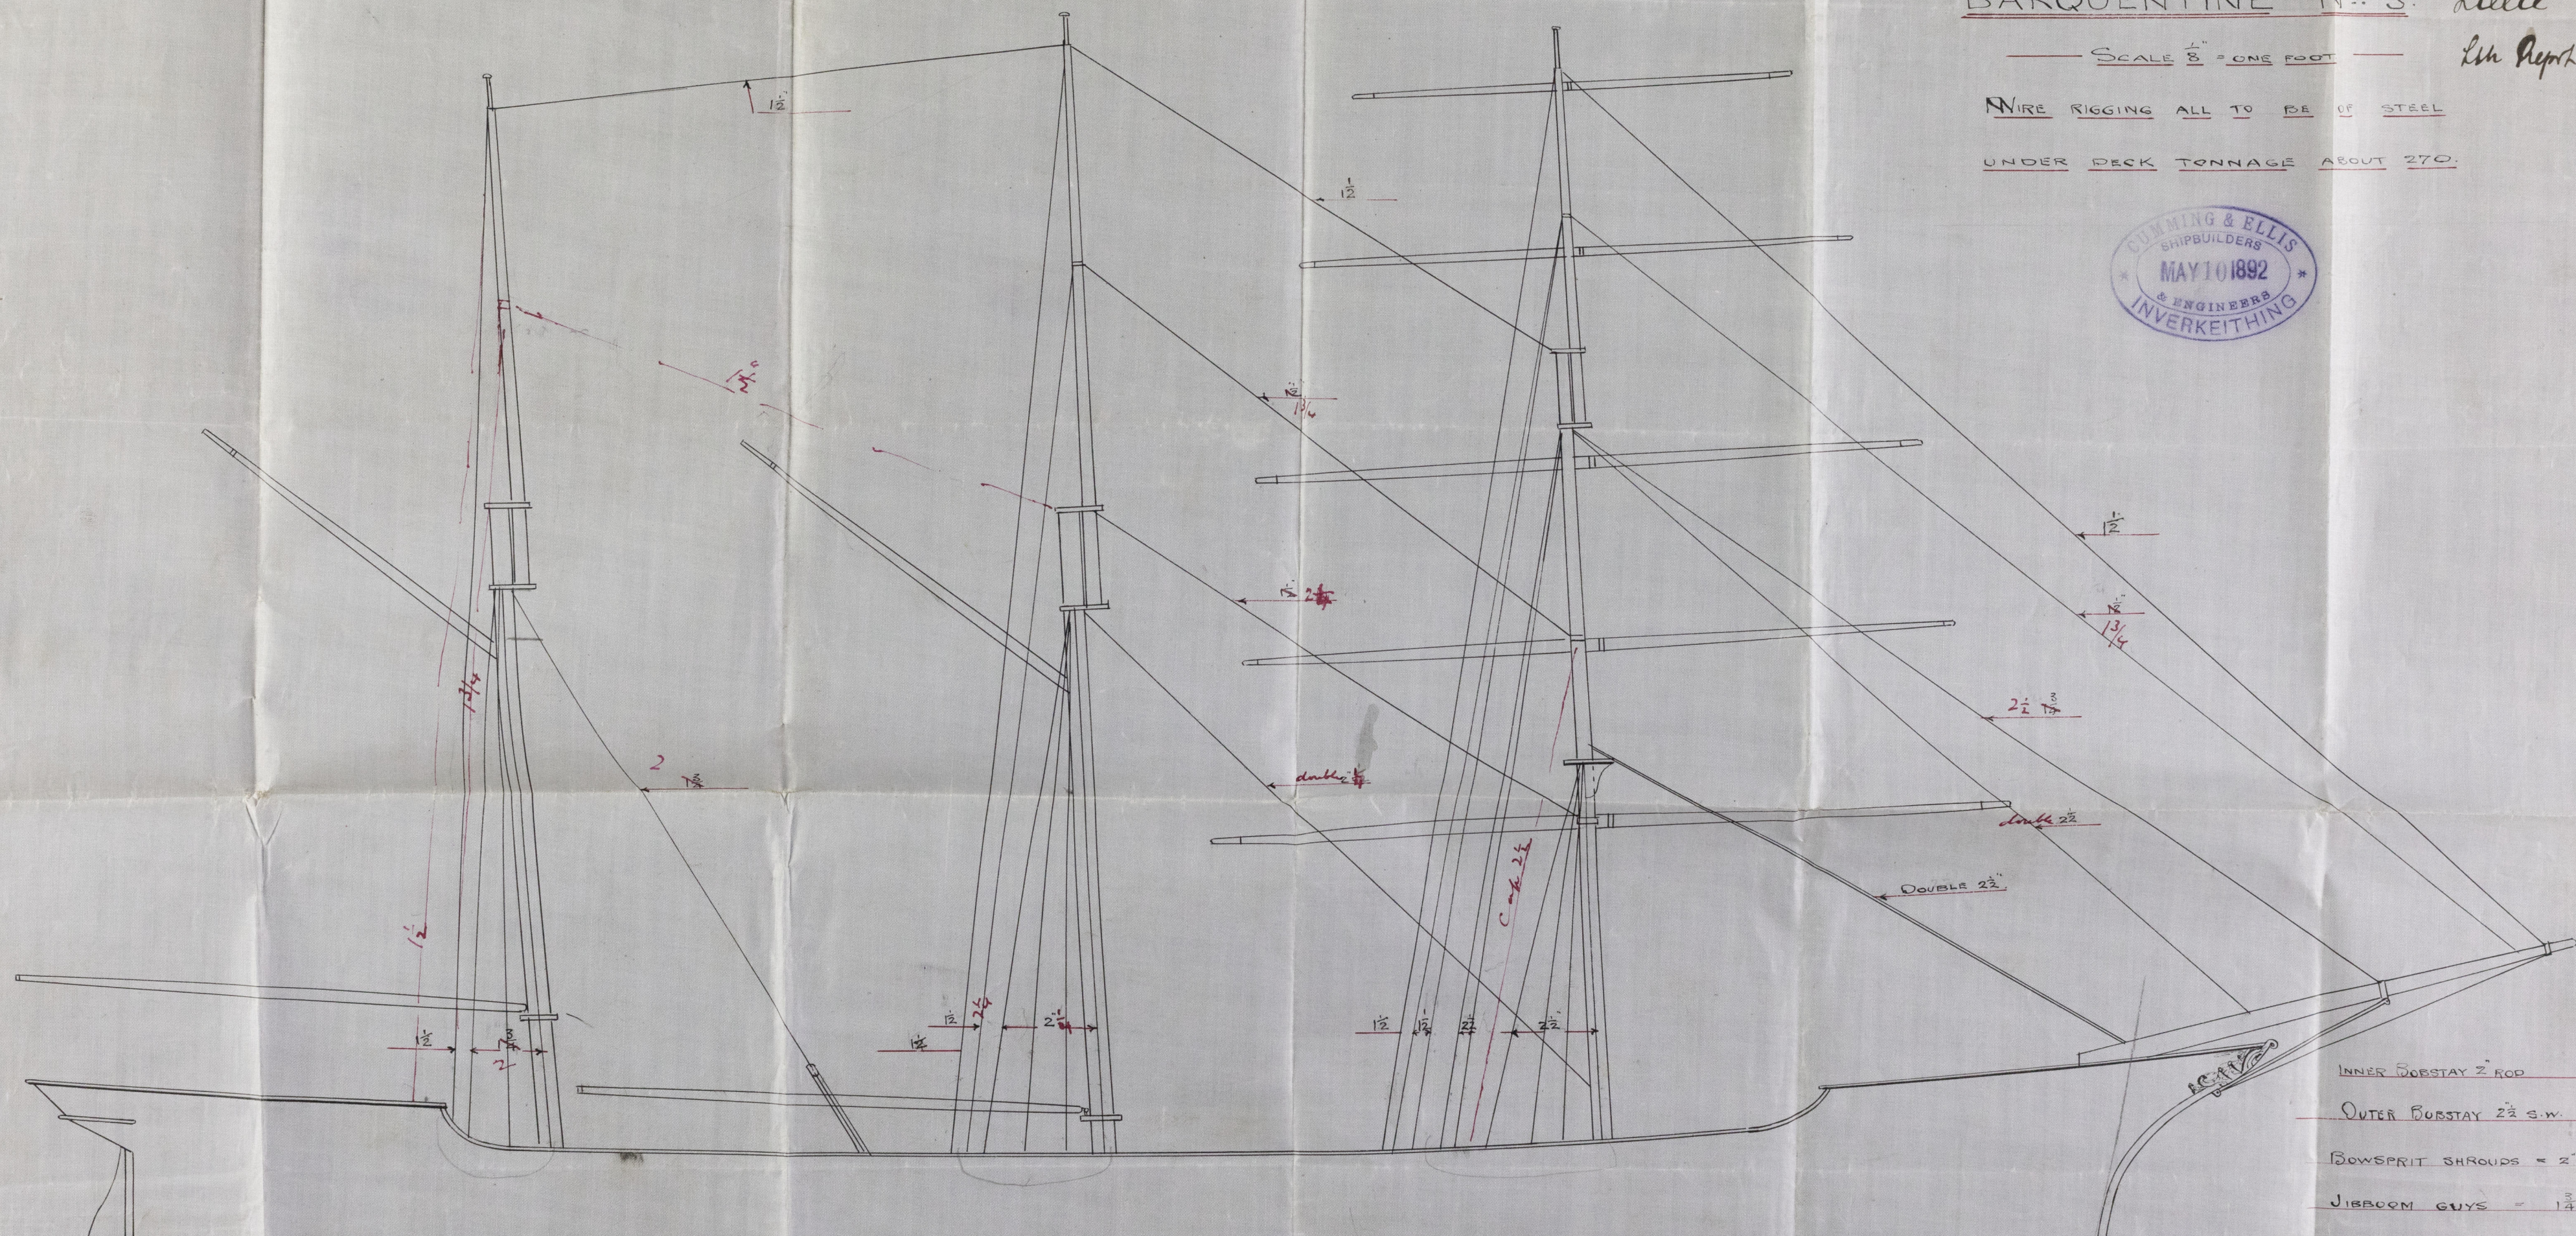


Lth Report 7023

UNDER DECK TONNAGE ABOUT 270.

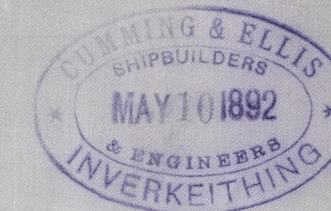







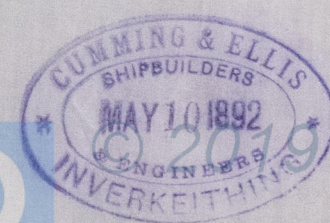

 

for ship 1023

Lillie



Bkn. "Lillie"
Lth. Report 7023

LTN 562-0144



© 2019
Lloyd's Register
Foundation