


DIMENSIONS 303 = O.B.P  $\times$  42 = 11 $\frac{1}{2}$ "  $\times$  26.9 $\frac{1}{2}$ " M<sup>LD</sup>




TO CLASS 100.A.1. AT LLOYDS.

HALF GIRTH.....44.08		<u>PROPORTIONS</u>
HALF BREADTH.....21.48		BREADTHS IN LENGTH.....7.01
DEPTH.....27.66		DEPTH IN LENGTH.....10.89
<u>93.22</u>	$\times 301.25 =$	<u>28082.525</u> + $\frac{1}{15} =$ <u>29954.693</u>
<u>F.N</u>		<u>P.N.</u>
		<u>E.N.</u>

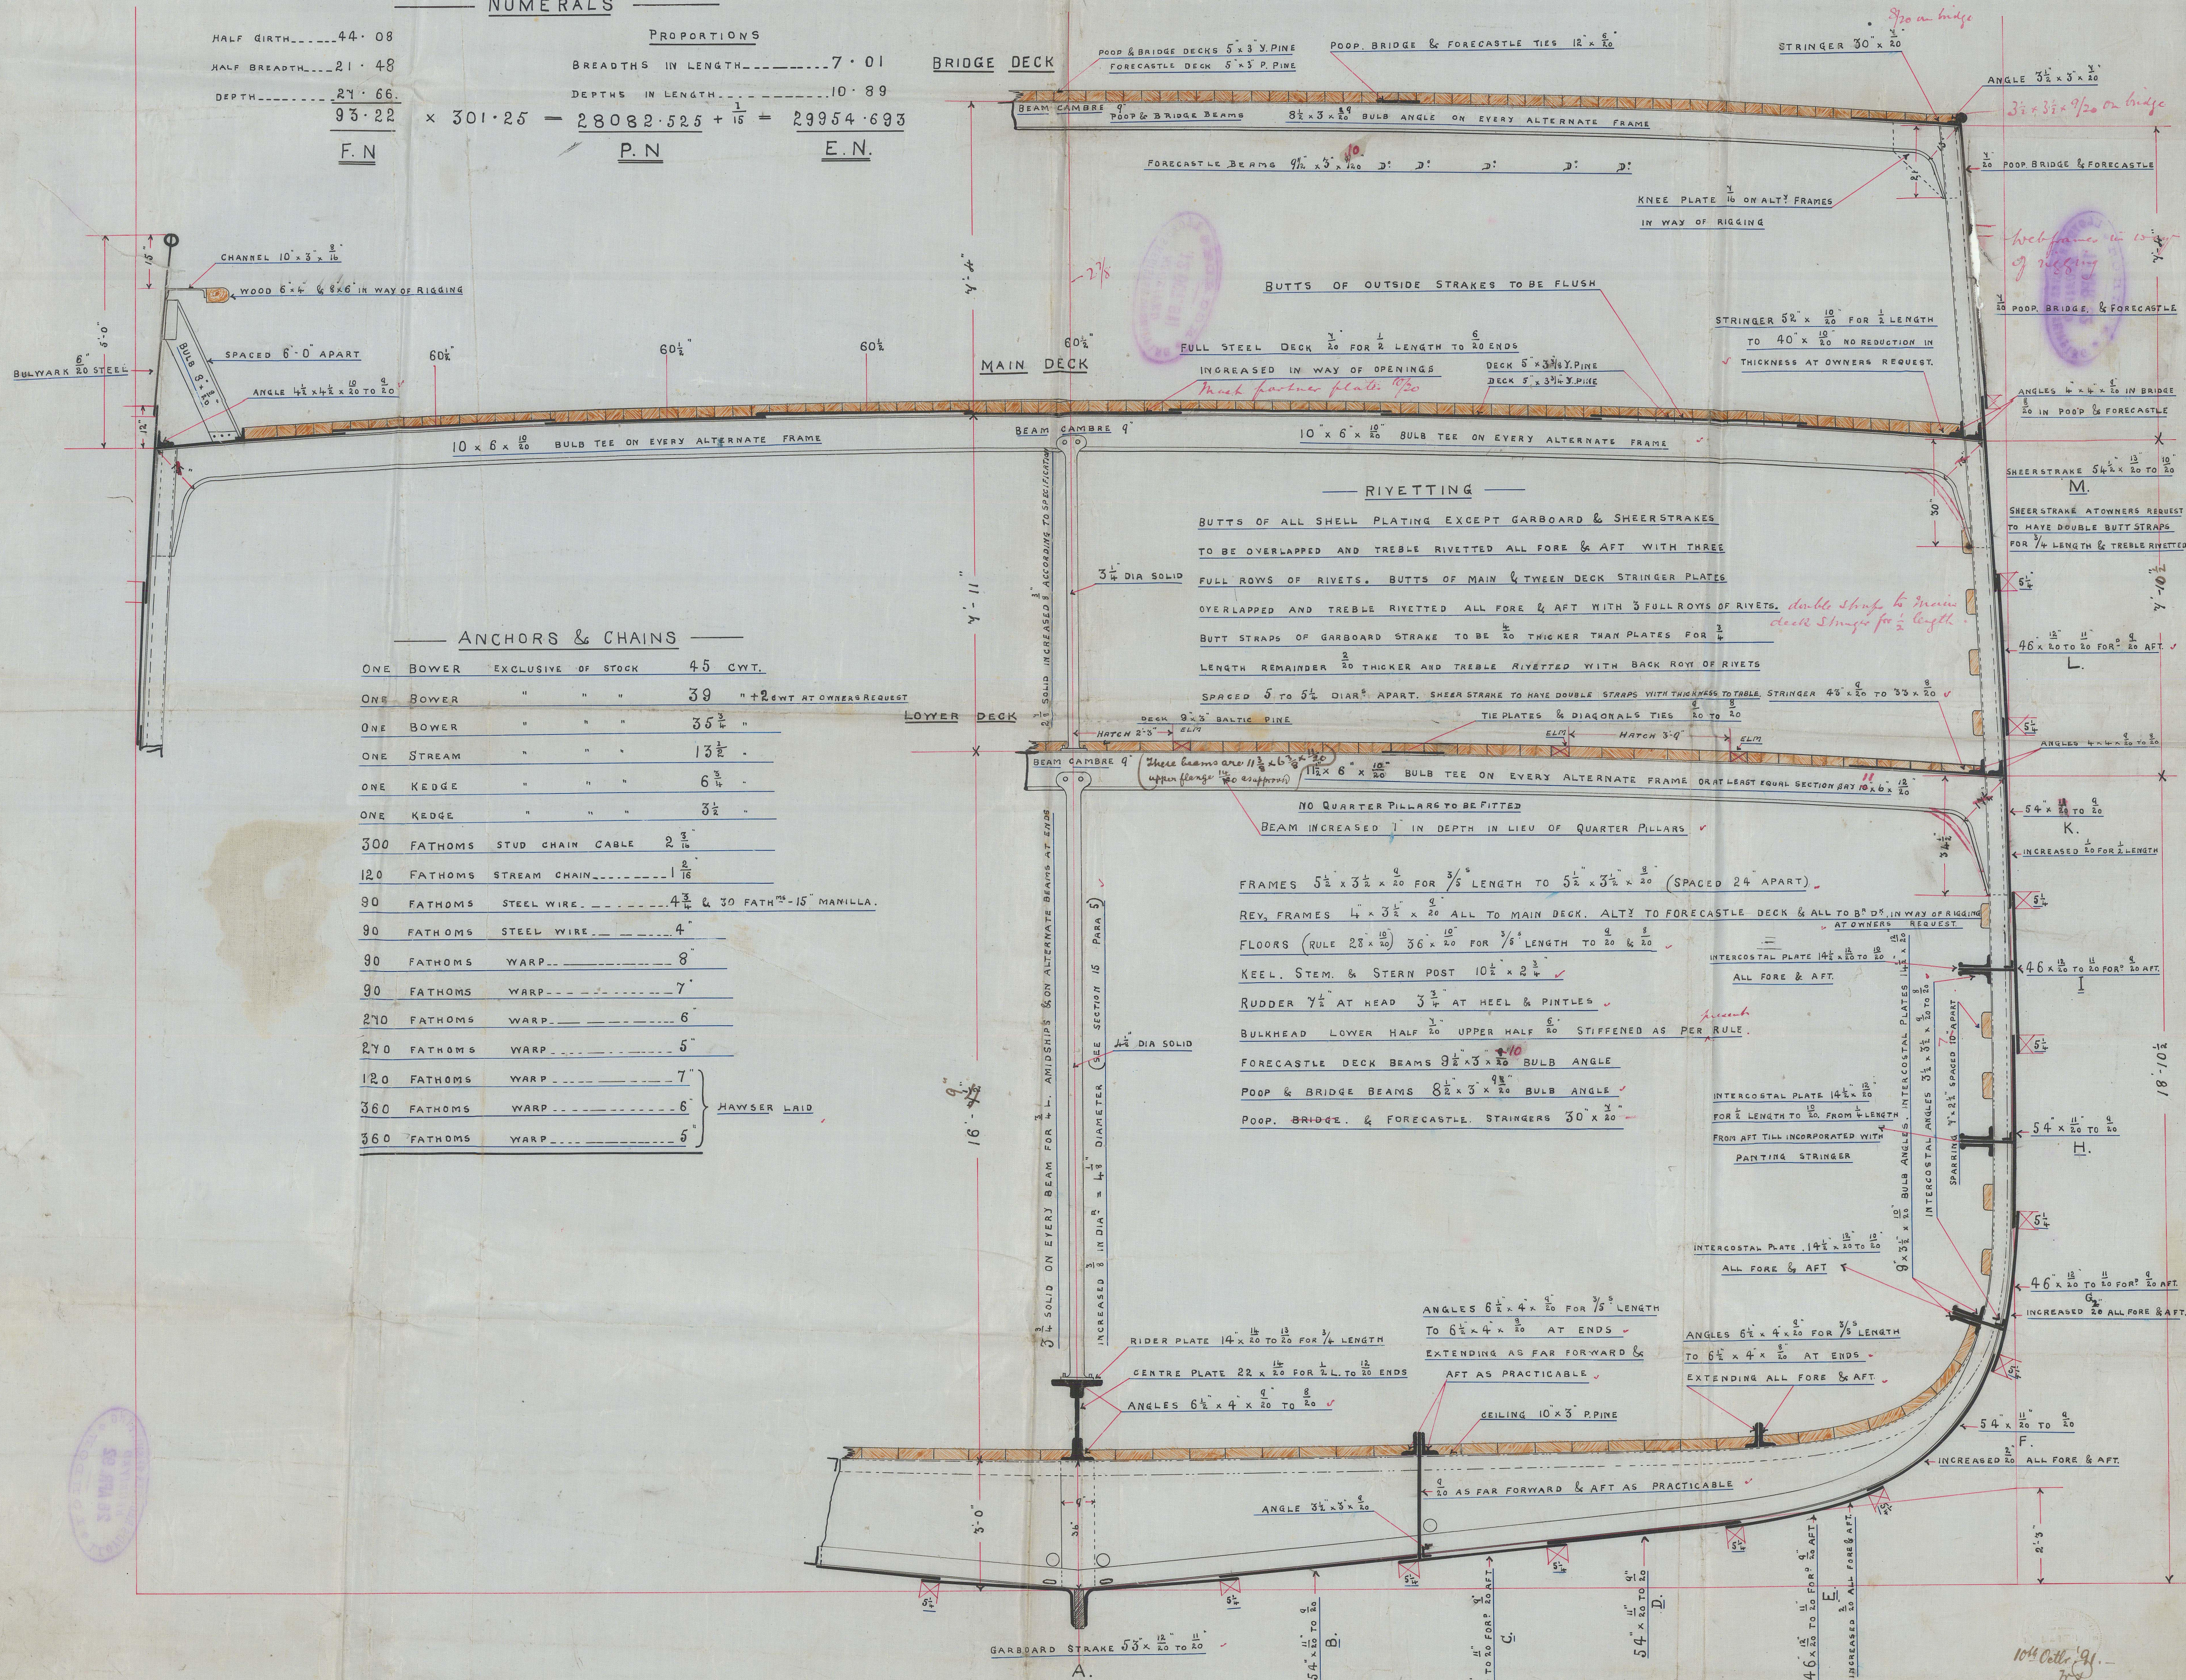

Outside Shakes, offplating  
Not to be reduced more than 1/30 th.  
at the fore end.



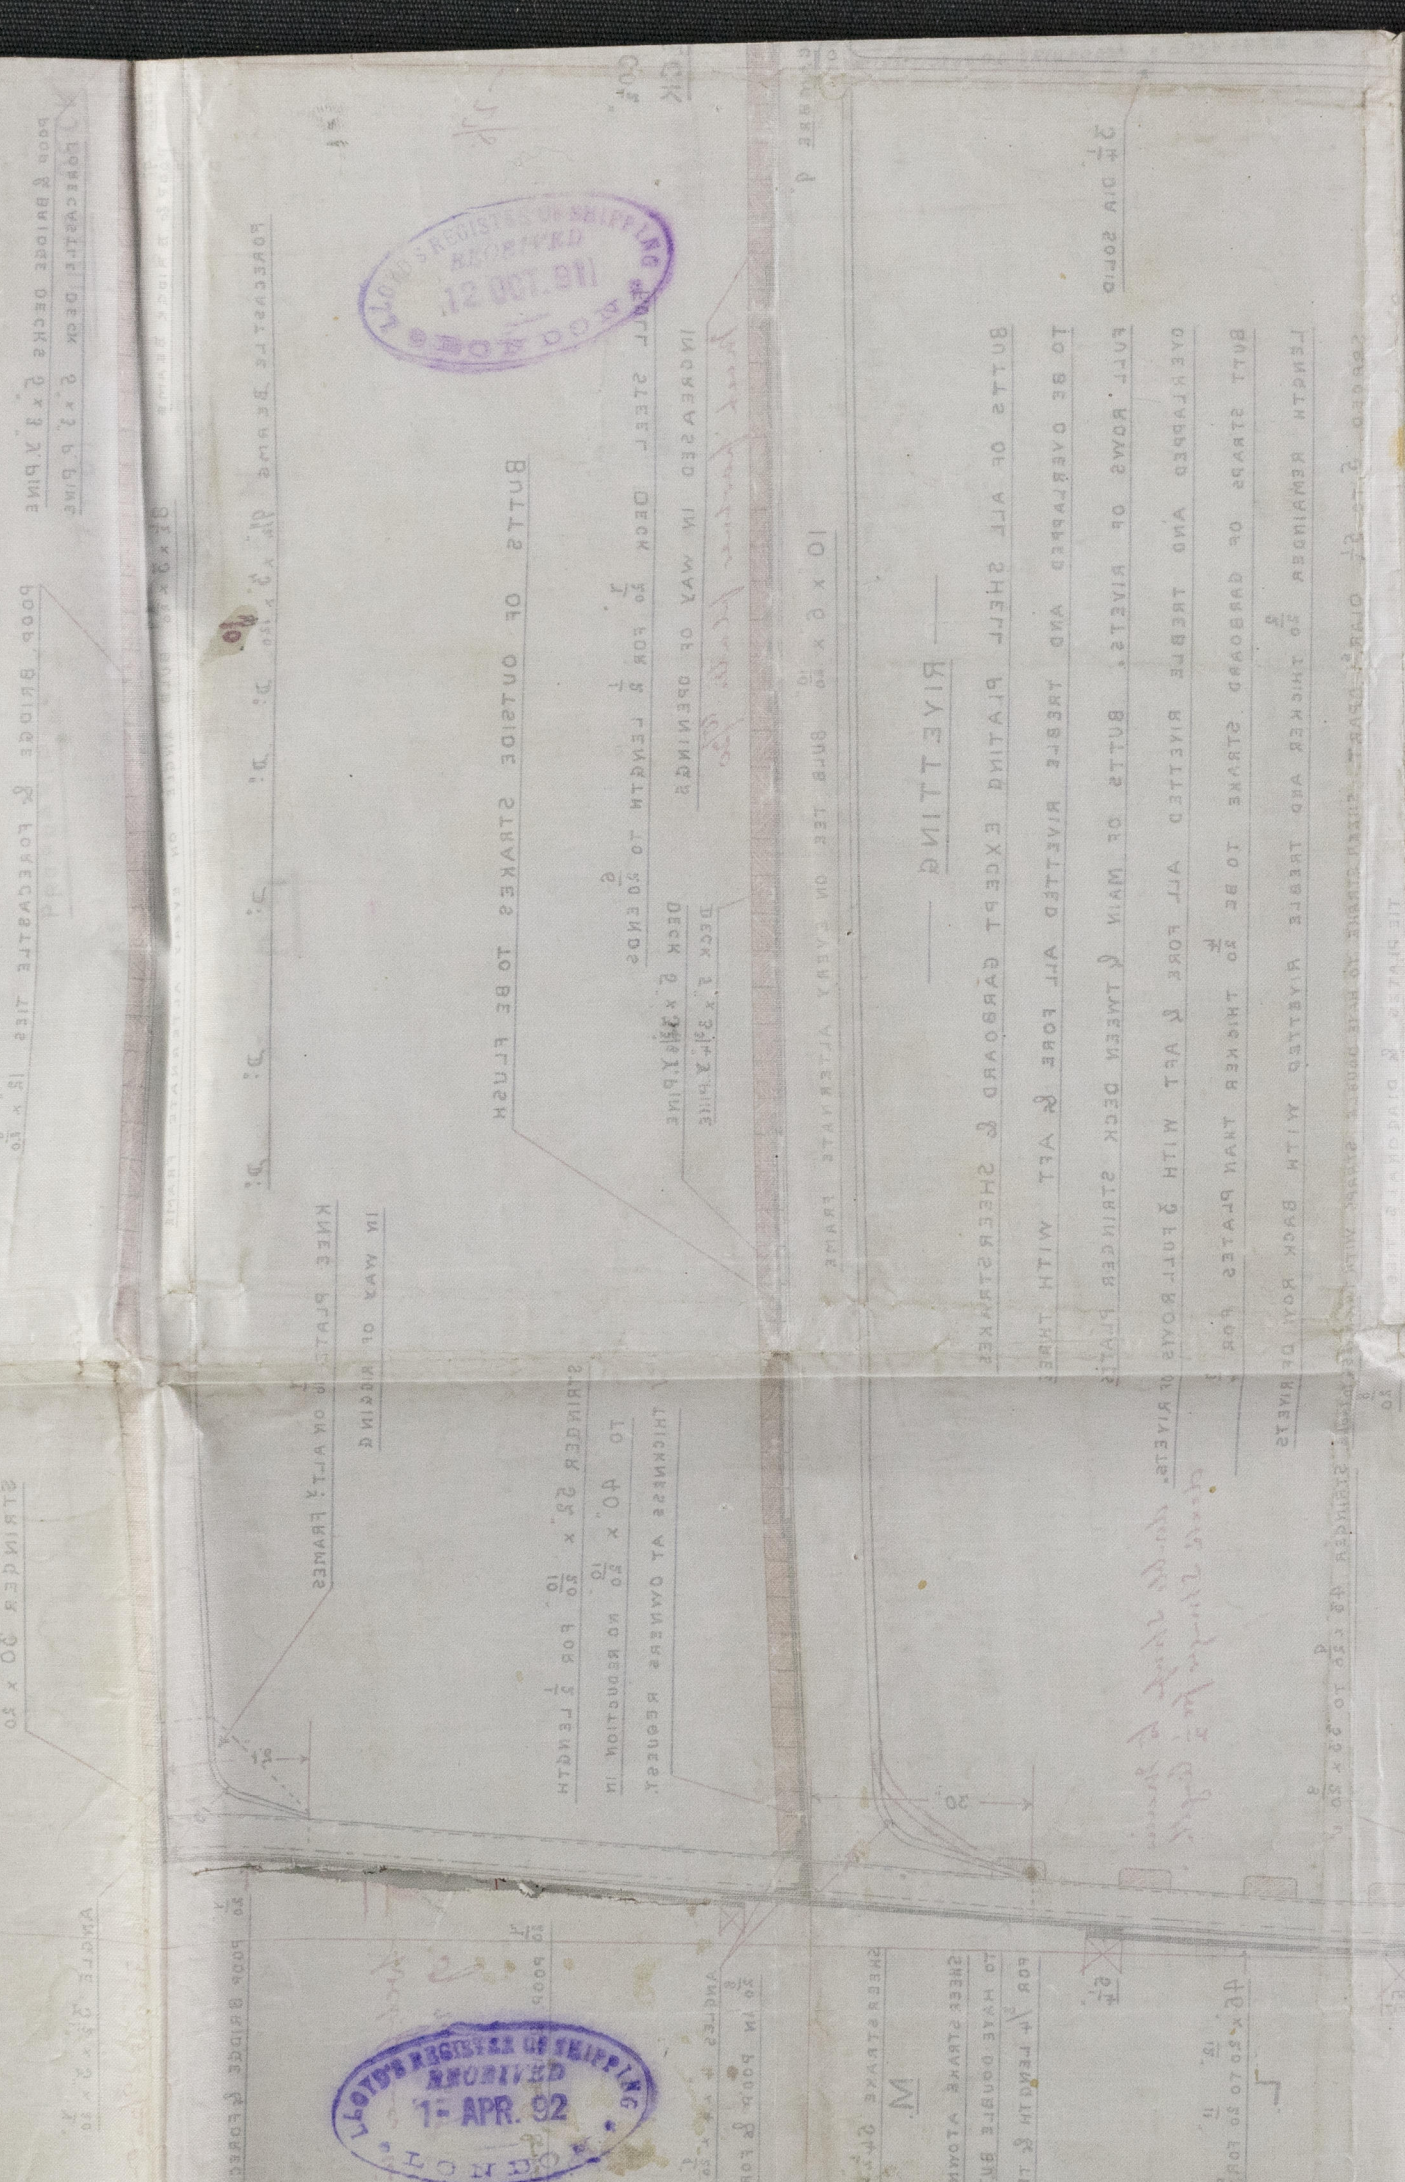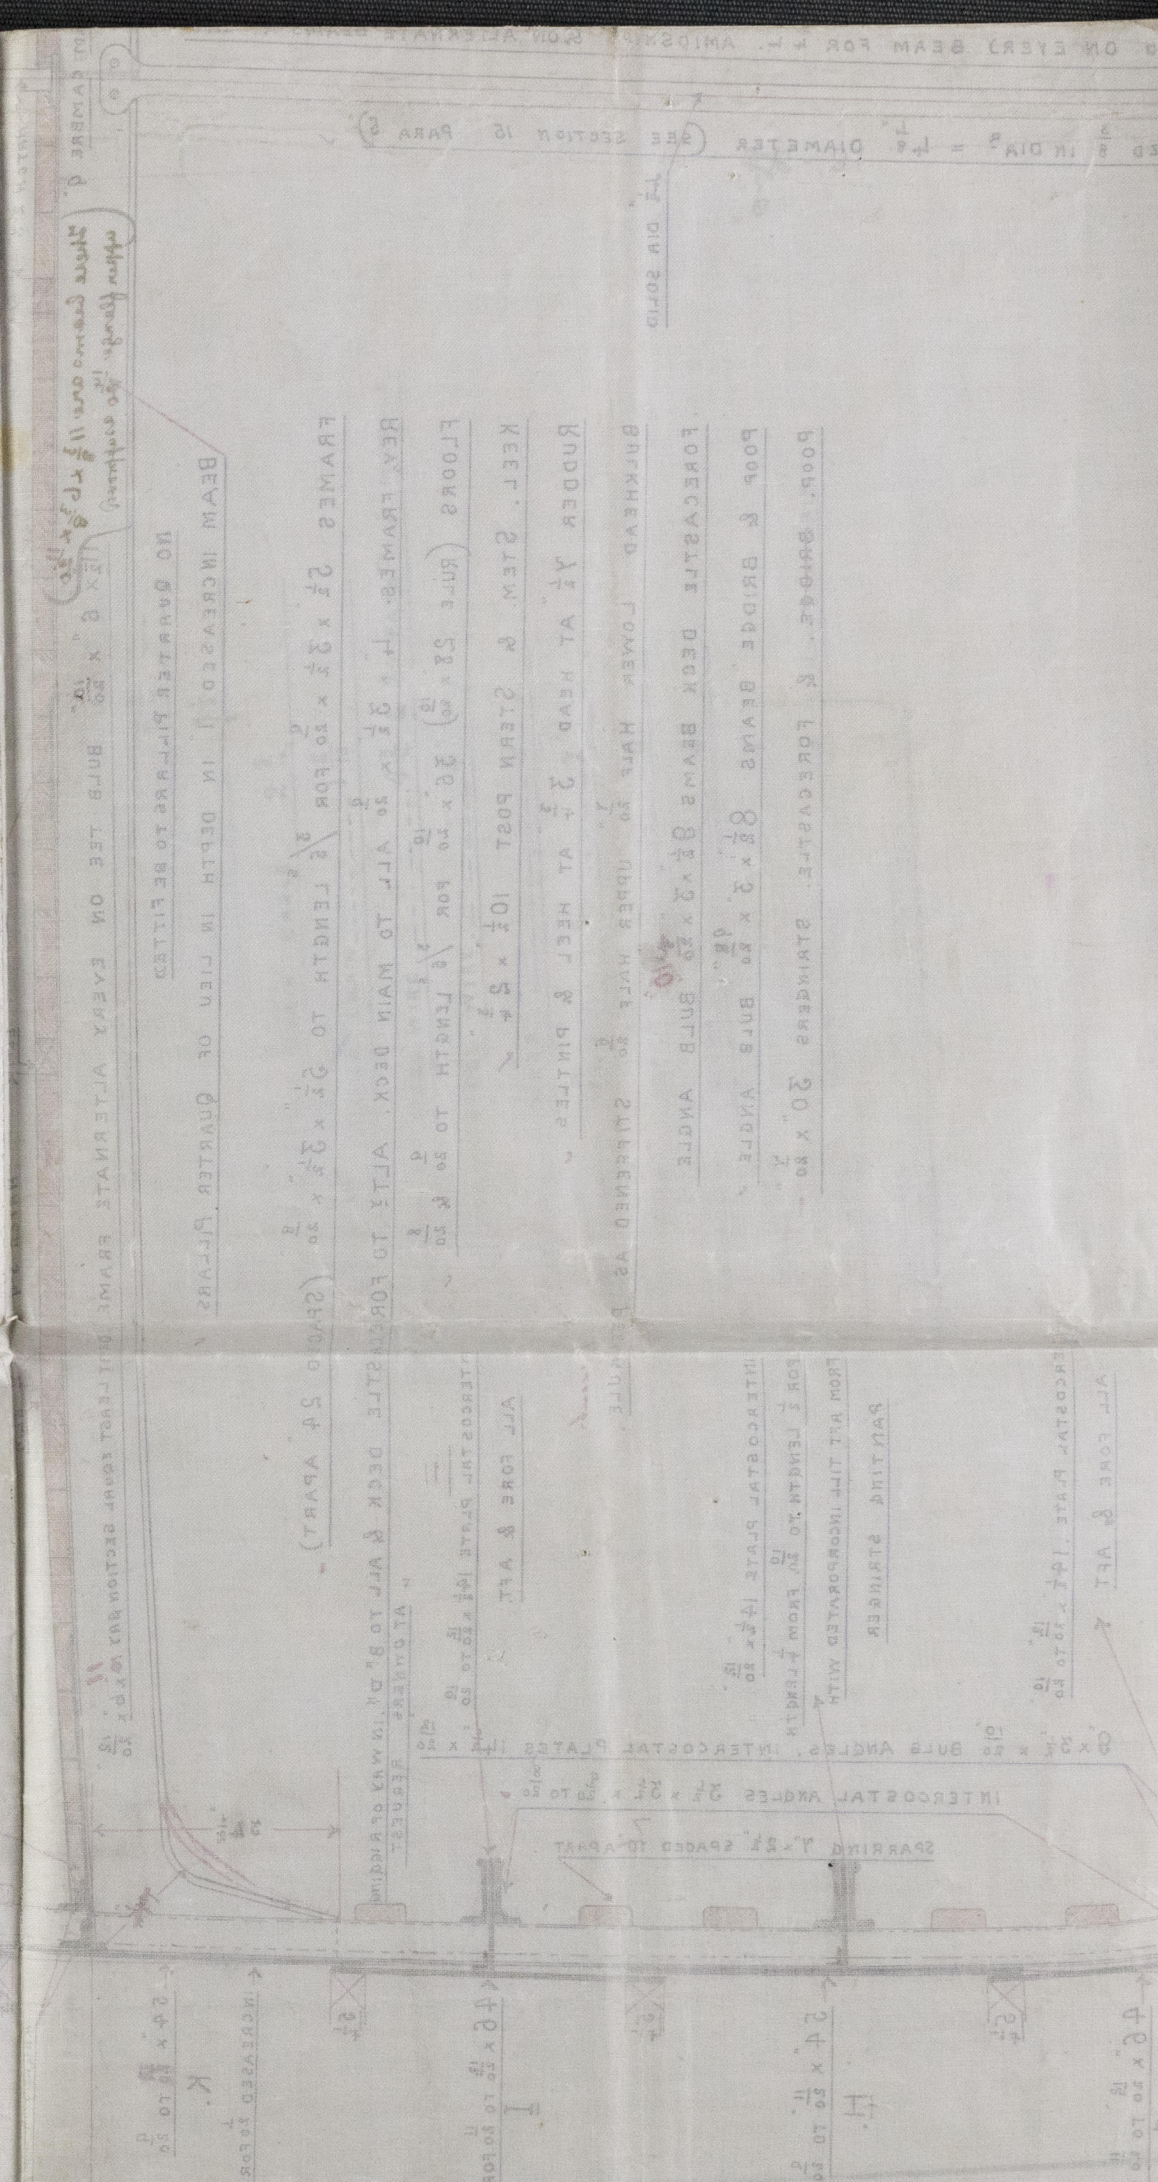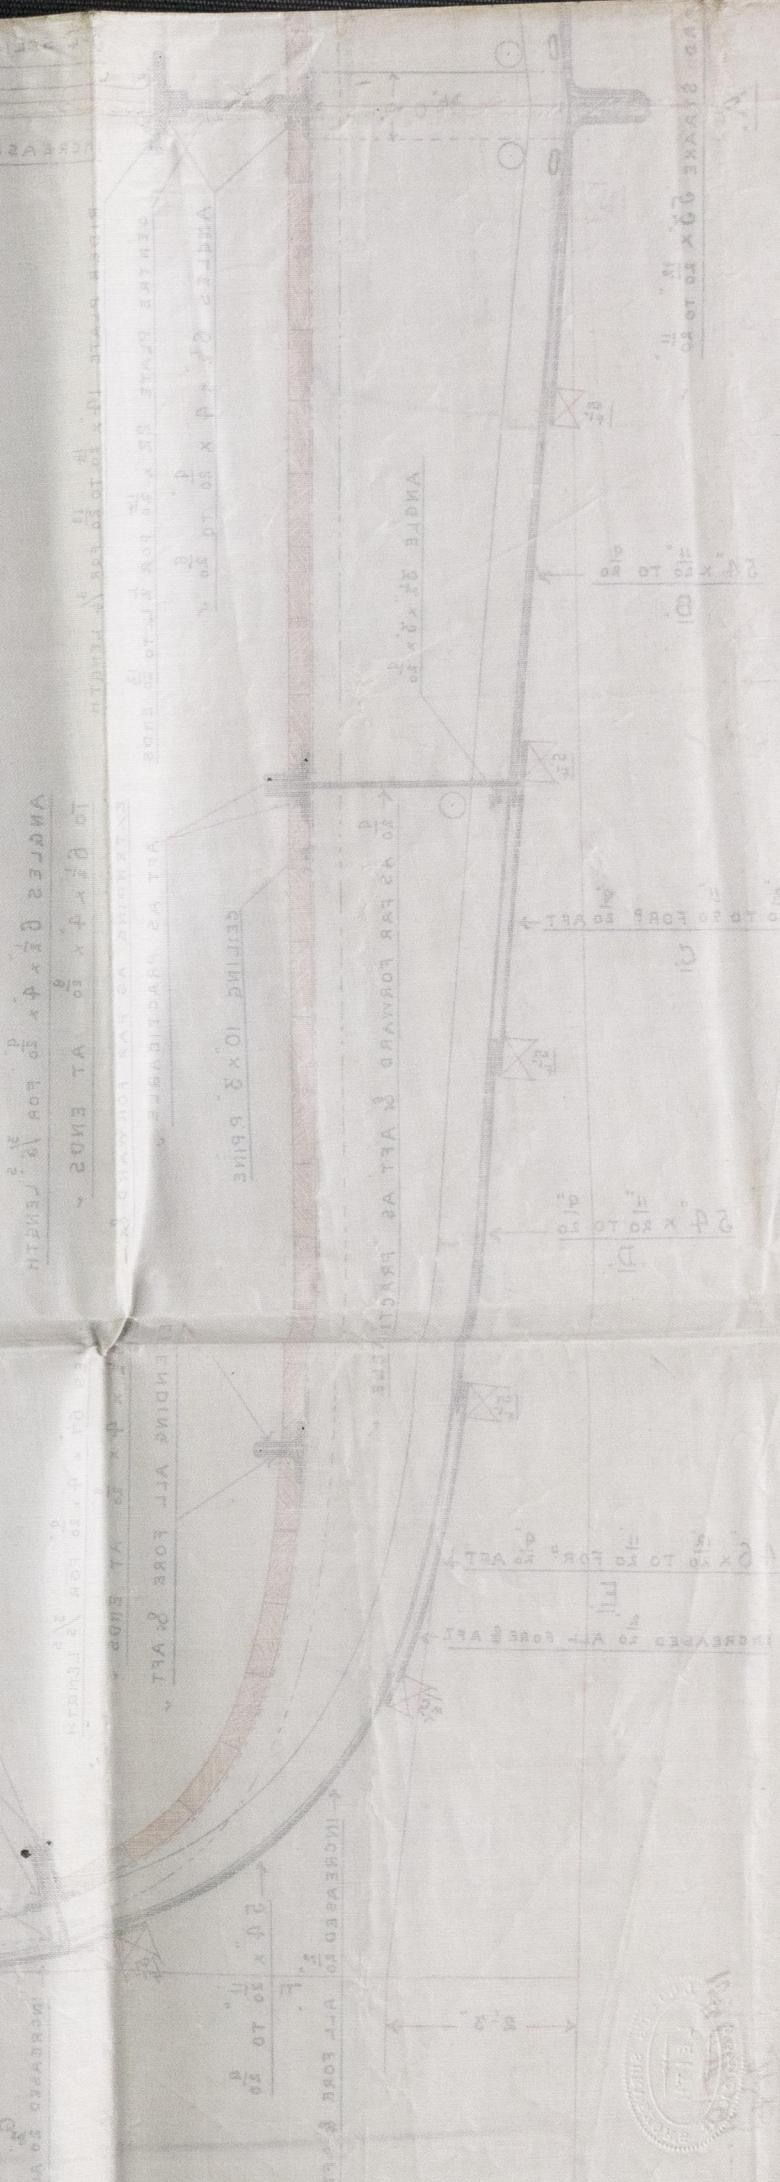





© 2021  
Lloyd's Register  
Foundation