

# Lloyd's Register of British and Foreign Shipping.

(Report on Vessel No. 7039 Port Leith)

## No.        SHIP FORGINGS OR CASTINGS.

The words FORGINGS or CASTINGS, IRON or STEEL, should be struck out as may be required.

I have to report that the undermentioned Iron or Steel Forgings or Castings, manufactured by The Life Forge Co. of Wirkcaldy for the Vessel No. 1644, being built by The Grauzmouth Dryd. Co. of Grauzmouth have been inspected by me as set forth below, and found to be, so far as can be seen, sound forgings.


Mark on Forgings.

Lloyd's
No. <u>✓</u>
<u>✓</u>

*W. J. Darling*  
*Leith.*

	STERN FRAME.	RUDDER FRAME.	STEM.
Material*	<i>Scrap iron.</i>		<i>Scrap iron.</i>
How made	<i>Forged &amp; smithed.</i>		<i>Forged &amp; smithed.</i>
Dimensions	<i>10 1/2 x 2 3/4</i>		<i>10 1/2 x 2 3/4</i>
Progress on Inspection	<i>Forged &amp; smithed.</i>		<i>Forged &amp; smithed.</i>
Dates when Inspected			

SKETCHES OF FRAMES SHEWING POSITION AND DESCRIPTION OF WELDS OF FORGINGS, OR PARTICULARS OF TESTS APPLIED TO CASTINGS.

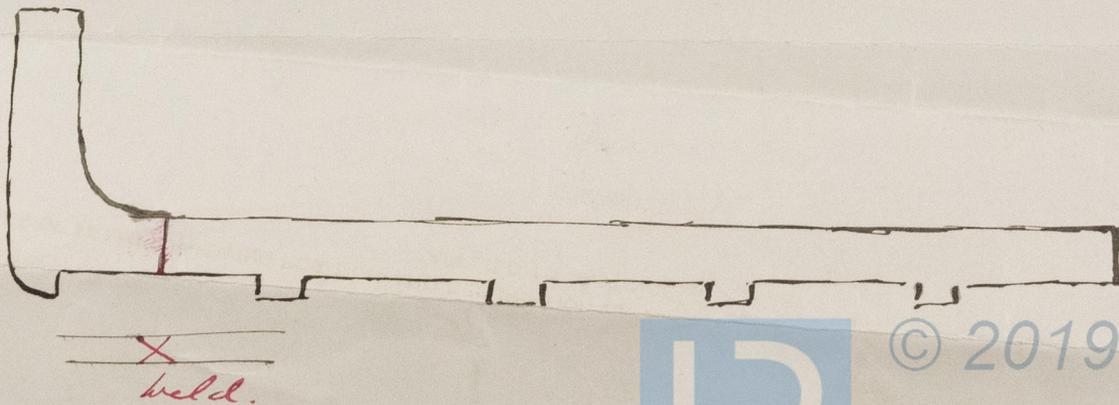

© 2019

Lloyd's Register  
Foundation

Boa. "Alcides"

Lth. Reprt. 7039.

SHIP RECORDS OF THE LLOYD'S

*[Faint, illegible handwritten text, likely bleed-through from the reverse side of the page]*

*[Faint, illegible handwritten text, likely bleed-through from the reverse side of the page]*

*[Faint, illegible handwritten text, likely bleed-through from the reverse side of the page]*



© 2019

Lloyd's Register  
Foundation