

Lloyd's Register of British and Foreign Shipping.

Leith

(Report on Vessel No. *7039* Port *Leith*)

No. *2236.a*

SHIP FORGINGS OR CASTINGS.

The words FORGINGS or CASTINGS, IRON or STEEL, should be struck out as may be required.

I have to report that the undermentioned Iron or Steel Forgings or Castings, manufactured by

Mr Tho Ray

of *Pallin*

for the Vessel No. *164*, being built by *The Grangemouth Dockyard Co.*

of *Grangemouth* have been inspected by me as set forth below, and found

to be, so far as can be seen, *sound*



Mark on Forgings.

Lloyd's
No. *2236.a*
N.C.

Wm Cameron
Sunderland
25.7.92

	STERN FRAME.	RUDDER FRAME.	STEM.
Material*	/	<i>Scrap iron</i>	/
How made		<i>fayed</i>	
Dimensions		<i>7 1/2" - 3 3/4"</i>	
Progress on Inspection		<i>fayed & smithed</i>	
Dates when Inspected		<i>May 10th to July 25/92</i>	

SKETCHES OF FRAMES SHEWING POSITION AND DESCRIPTION OF WELDS OF FORGINGS, OR PARTICULARS OF TESTS APPLIED TO CASTINGS.

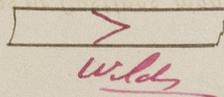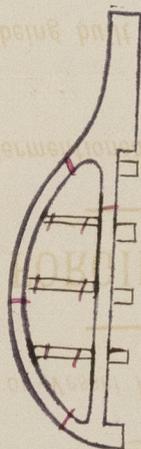

© 2019

Lloyd's Register Foundation

BA. "Alcides"
Lth. Rept. 7039



© 2019

Lloyd's Register
Foundation