


95-92

Riveting of yards. Butts to be lapped - 6" lap & rivets. Beams single riveted 2 1/4" with 5 rivets

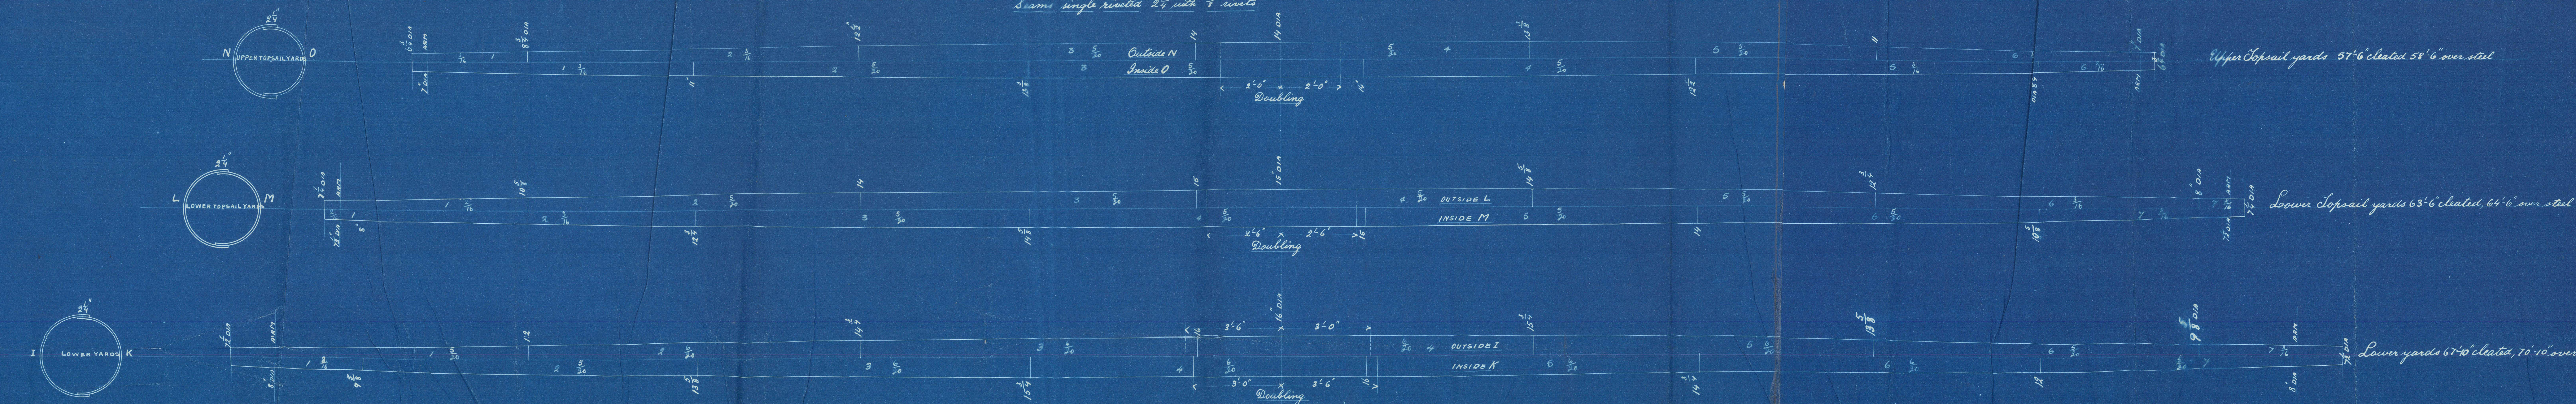

MASTS & YARDS N^o 170 "Margery Glen"


SCALE 1/2" = ONE FOOT

Rep. No. 7059


NOTE: ALL BUTTS TO BE LAPPED EXCEPT THOSE IN WAY OF DOUBLING PLATES WHICH ARE TO BE FLUSH BUTTS. THE LINES ON THE TRACING SHOWN CENTERS OF BUTT LAPS.

J.R. = TRIPLE RIVETING
D.R. = DOUBLE RIVETING

Riveting of bowsprit. Butts marked 2R to be double riveted & 3R to be triple riveted. Beams double riveted 5/8" x 3/4" RIVETS

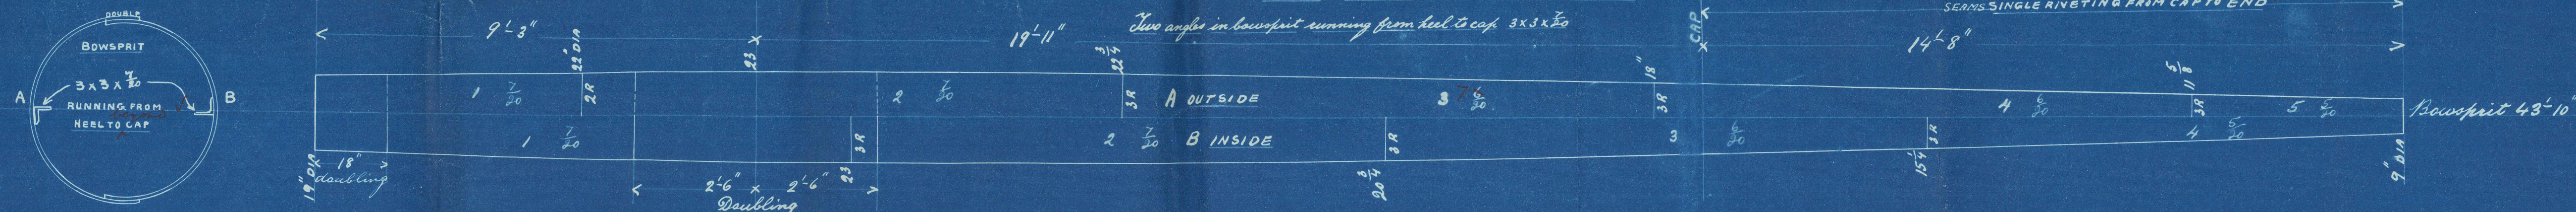

Riveting of main mast. Butts marked 2R = double riveted & 3R = triple riveted. Beams double riveted 5/8" x 3/4" RIVETS

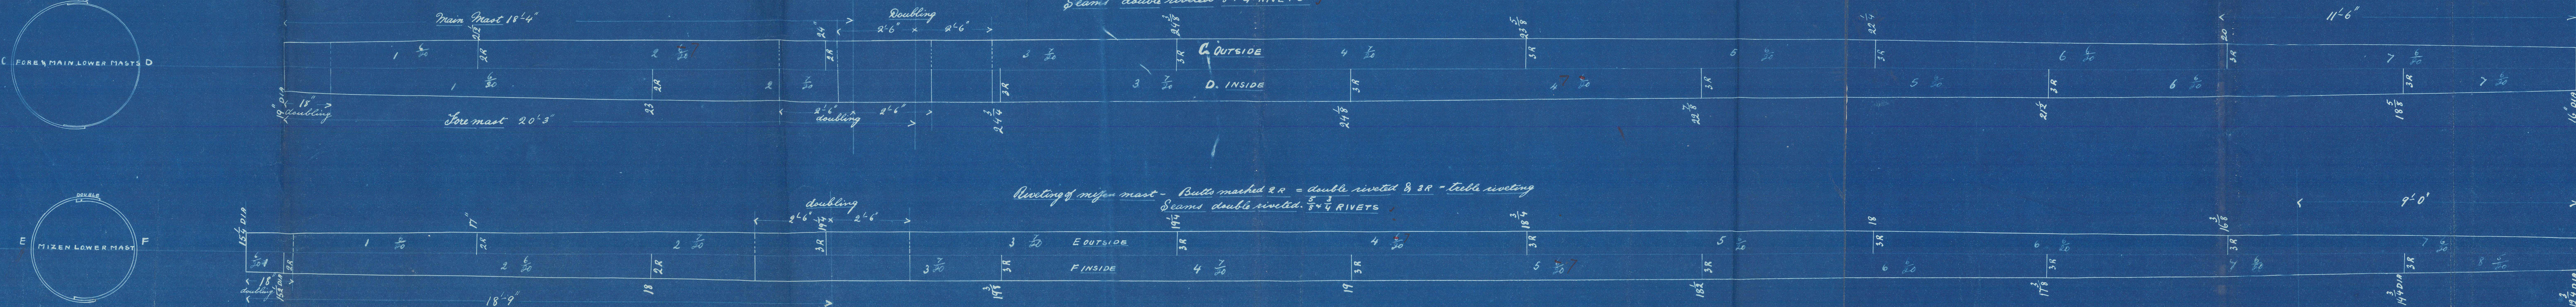

55 Aug 92

LTH 562-0180C1\2\

24/9/92
2nd May

18 92

GRANGEMOUTH DOCKYARD CO.

GRANGEMOUTH AND ALLOA.

Returned is
This Enclosure is to be sent to

Ships No.

140

Tracing No.

115

Lloyd's

British

Lloyd's Register
Foundation

7059

Riggings

BR. "Marjory Glen"
Lth. Report. No. 7059



© 2021

Lloyd's Register
LTH 562-50180