

Lloyd's Register of British and Foreign Shipping.

(Report on Vessel No. 7059 Port Leith)

The words FORGINGS or CASTINGS, IRON or STEEL, should be struck out as may be required.

No. 135. SHIP FORGINGS OR CASTINGS.

I have to report that the undermentioned Iron or ~~Steel~~ Forgings or Castings, manufactured by The Fire Forge Co. of North Leith for the Vessel No. 170, being built by The Grazebrook Dyke Co. of Grazebrook have been inspected by me as set forth below, and found to be, so far as can be seen, sound forgings.

Mark on Forgings.


Lloyd's
No. 124
W.F.D.

W. Darling.
Leith.

Superior of

	STERN FRAME.	RUDDER FRAME.	STEM.
Material*	<u>Scrap iron</u>	<u>Scrap iron</u>	<u>Scrap iron</u>
How made	<u>Forged & mottled</u>	<u>Forged & mottled</u>	<u>Forged</u>
Dimensions	<u>7 1/4 x 2 3/8</u>	<u>had 5 1/4 x 3 had</u>	<u>7 1/4 x 2 3/8</u>
Progress on Inspection	<u>Forged & finished</u>	<u>Forged & finished</u>	<u>Forged</u>
Dates when Inspected	<u>From 12th March 1892. —</u> <u>Do 7th July 1892. —</u>		<u>8 visits. —</u>

SKETCHES OF FRAMES SHEWING POSITION AND DESCRIPTION OF WELDS OF FORGINGS, OR PARTICULARS OF TESTS APPLIED TO CASTINGS.

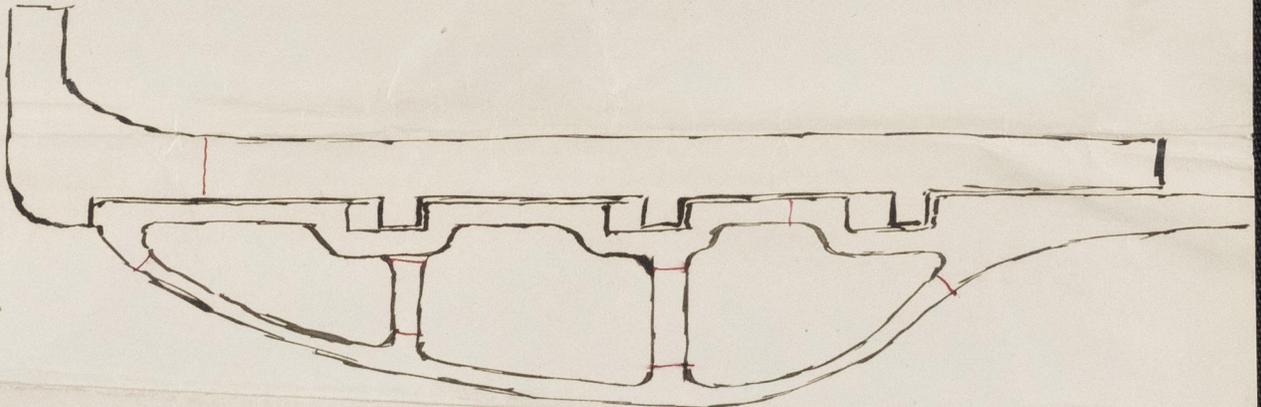

X
welds



© 2019

Lloyd's Register
Foundation

Ms. Marjory Helen

Ms. Report. No. 7059



© 2019

Lloyd's Register
Foundation