

27.2.92
9.5.92

could proceed at
2207 21.4.92

MIDSHIP SECTION STEEL SAILING BARQUE N° 170

"Marjory Glen"
Lth. Regt No 7059.


SCALE 1/2 INCH PER FOOT.

ANCHORS AND CHAINS

TROTMAN'S 2	BOYER'S EACH 30 CWTs EX STOCK
RODGER'S OLD PATENT	BOYER'S EACH 30 CWTs EX STOCK (COLL WEIGHT 85 1/2 CWTs)
1 STREAM	9 1/2 "
1 KEDGE	4 3/4 "
1 KEDGE	2 1/2 "
240 FATHOMS	STUD CHAIN CABLE 1 1/2 "
75 "	3 1/2 STEEL WIRE STREAM ROPE
90 "	3 " STEEL WIRE
75 "	3 " STEEL WITH 15 FATHOMS 11 COIR SPRING
90 "	5 1/2 " WARP

1/2 GIRTH 34' 00
1/2 BREADTH 16' 91
DEPTH 21' 54


PROPORTIONS
BREADTHS IN LENGTH 5' 99
DEPTHS " " 9' 41
 $72 \cdot 45 \times 202 \cdot 49 = 14682 \cdot 035 + \frac{1}{15} = 15664 \cdot 834$
F.N. P.N. E.N.

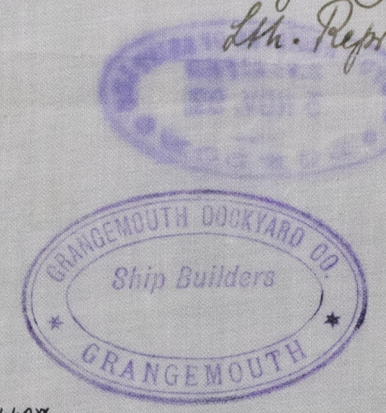

TO CLASS 100. A. I. AT LLOYDS

DIMENSIONS

204'-0" B.P. x 33'-10" x 20'-10" MOULDED

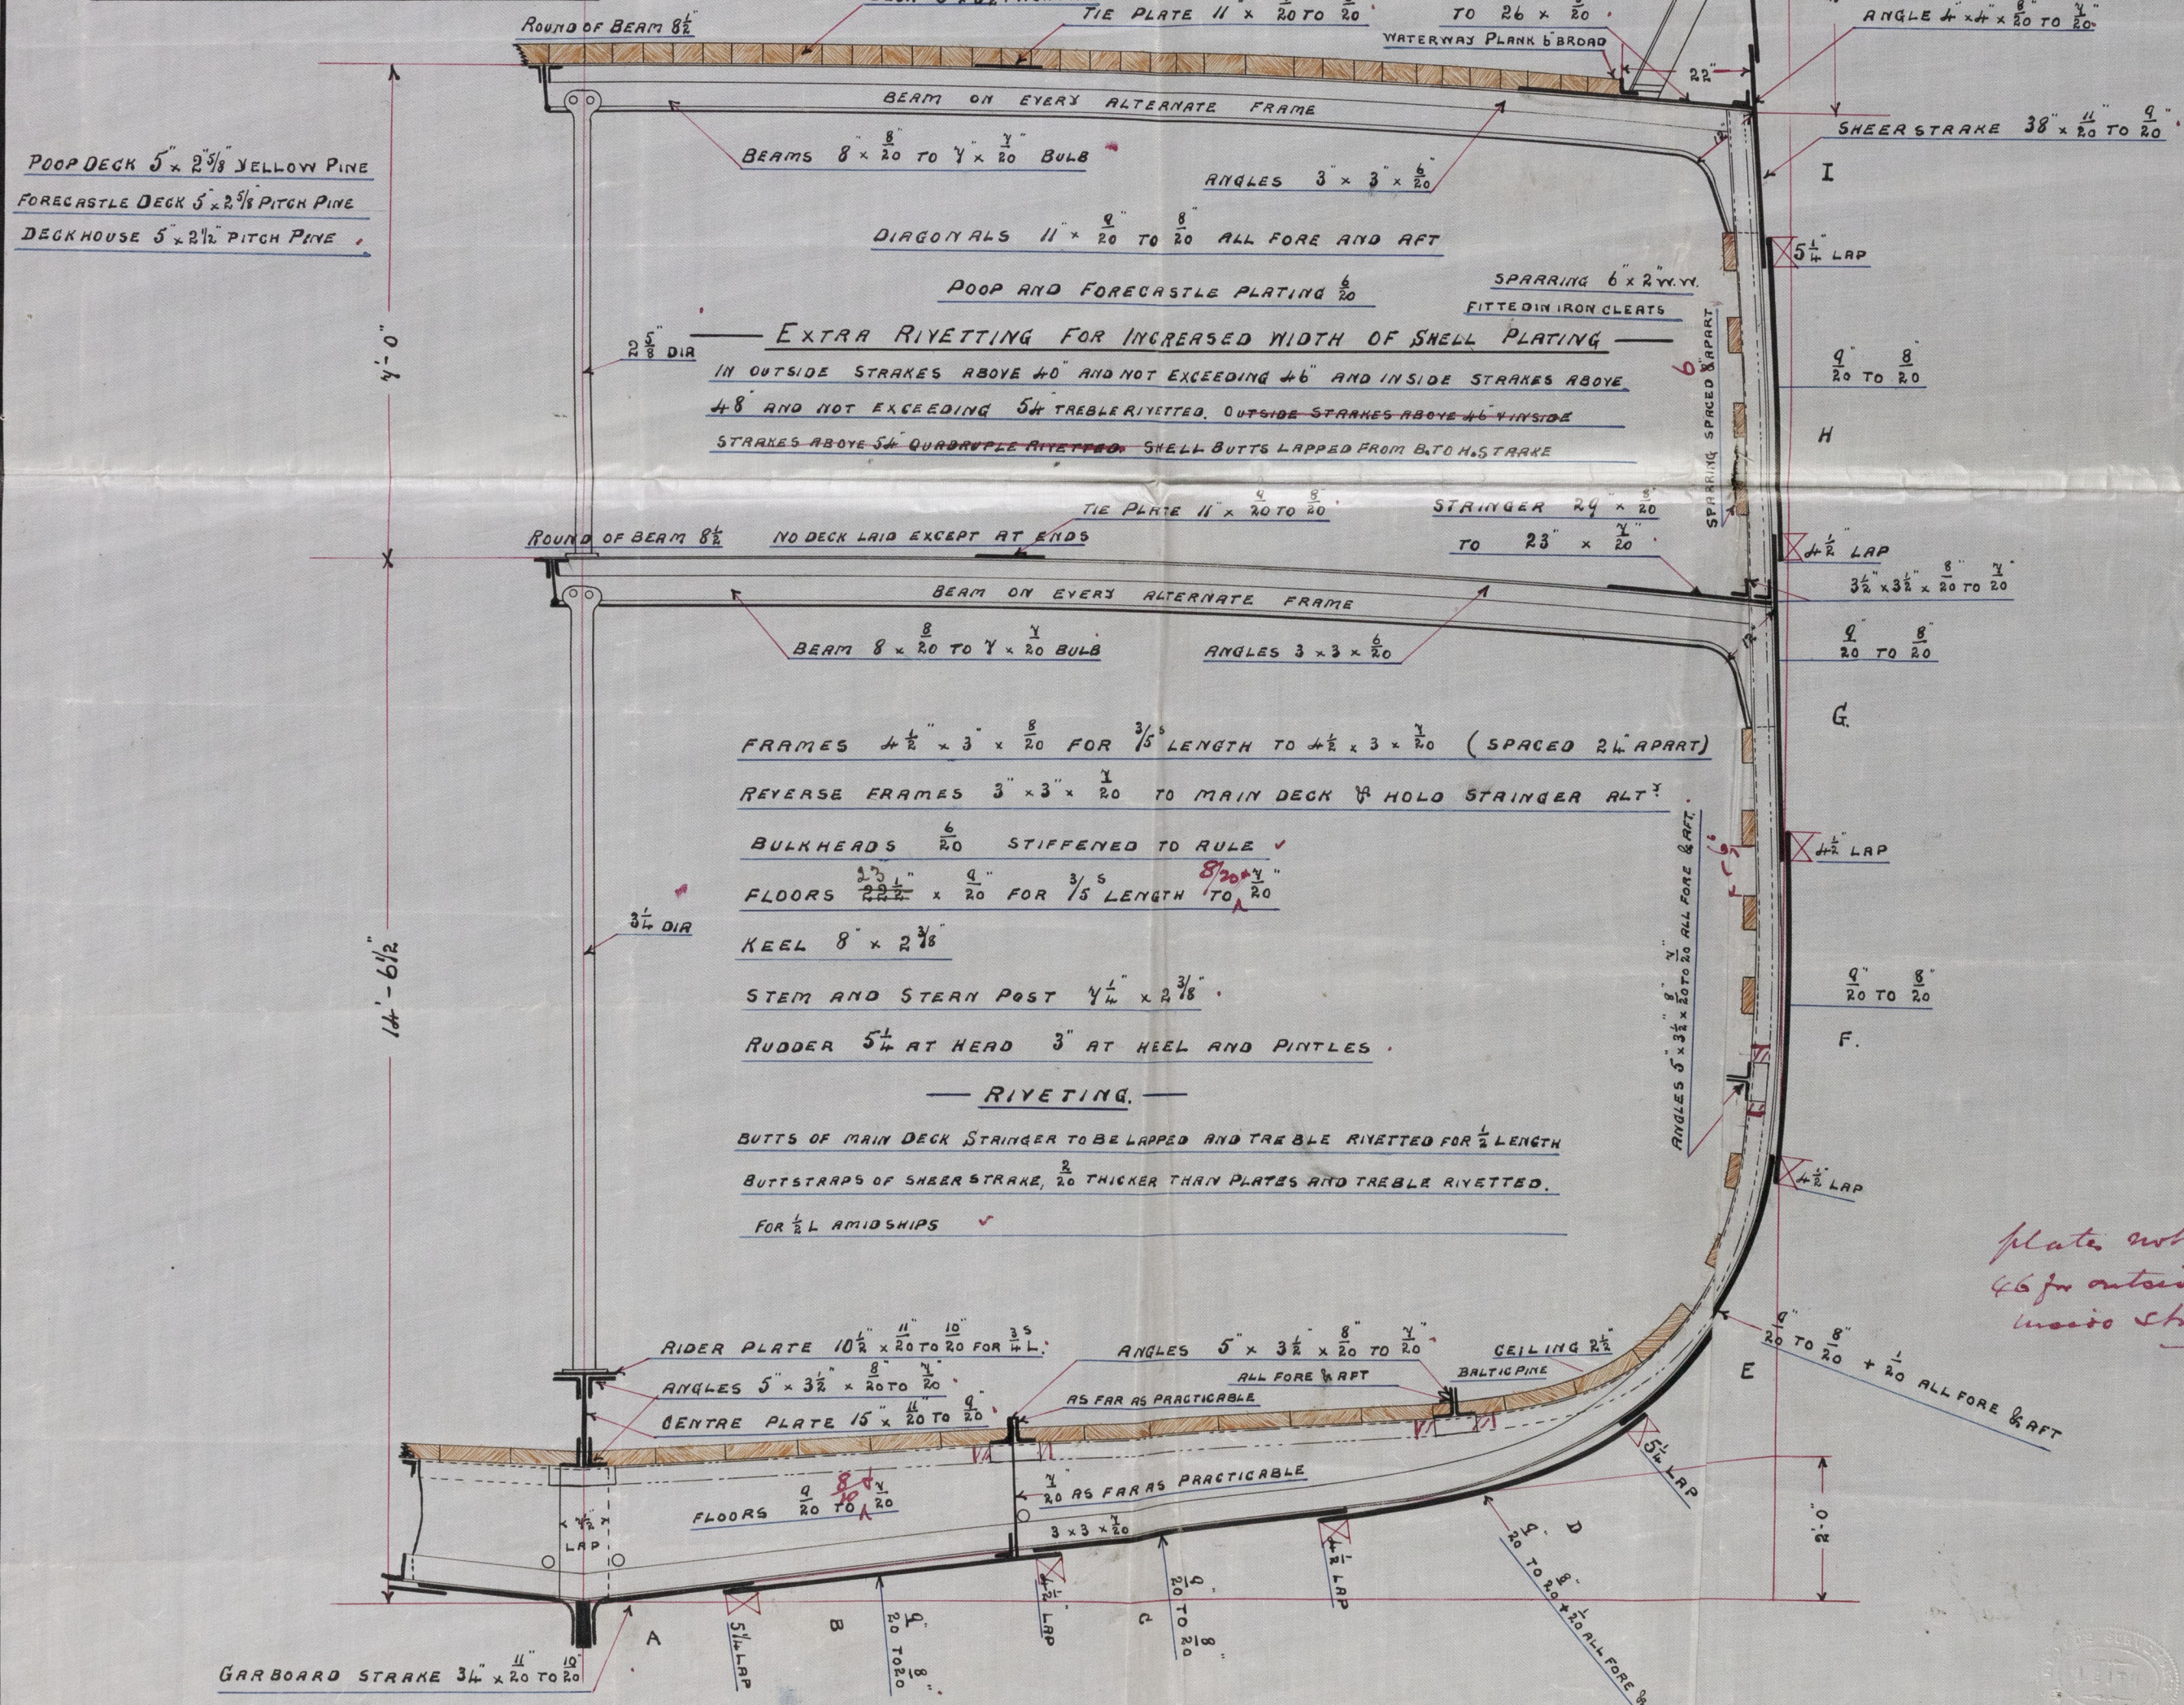

EXTRA RIVETTING FOR INCREASED WIDTH OF SHELL PLATING
IN OUTSIDE STRAKES ABOVE 40" AND NOT EXCEEDING 46" AND INSIDE STRAKES ABOVE 48" AND NOT EXCEEDING 54" TRIPLE RIVETTED. OUTSIDE STRAKES ABOVE 46" INSIDE STRAKES ABOVE 54" QUADRUPLE RIVETTED. SHELL BUTTS LAPPED FROM B. TO H. STRAKE

FRAMES 4 1/2' x 3' x 3/8" FOR 1/5 LENGTH TO 4 1/2' x 3' x 3/8" (SPACED 24" APART)
REVERSE FRAMES 3' x 3' x 3/8" TO MAIN DECK V. HOLD STRINGER ALT.
BULKHEADS 6" STIFFENED TO RULE
FLOORS 3' x 3' x 3/8" FOR 1/5 LENGTH TO 20' x 1/2"
KEEL 8' x 2 1/8"
STEM AND STERN POST 7 1/4' x 2 3/8"
RUDDER 5 1/4" AT HEAD 3" AT HEEL AND PINTLES.

RIVETING
BUTTS OF MAIN DECK STRINGER TO BE LAPPED AND TRIPLE RIVETTED FOR 1/2 LENGTH
BUTTSTRAPS OF SHEER STRAKE, 20 THICKER THAN PLATES AND TRIPLE RIVETTED.
FOR 1/2 L. AMIDSHIPS

plate out to exceed
46 for outside & 54 for
inside strakes

27/2/92

Bk. "Marjory Glen"

Lth. Rept. No 7059

LLOYD'S REGISTER OF SHIPS
REGISTERED
3 NOV 92
LONDON


© 2019
Lloyd's Register
Foundation